


MATCH LINE STA. 411+00
SEE SHEET NO. 346


END (1) +55

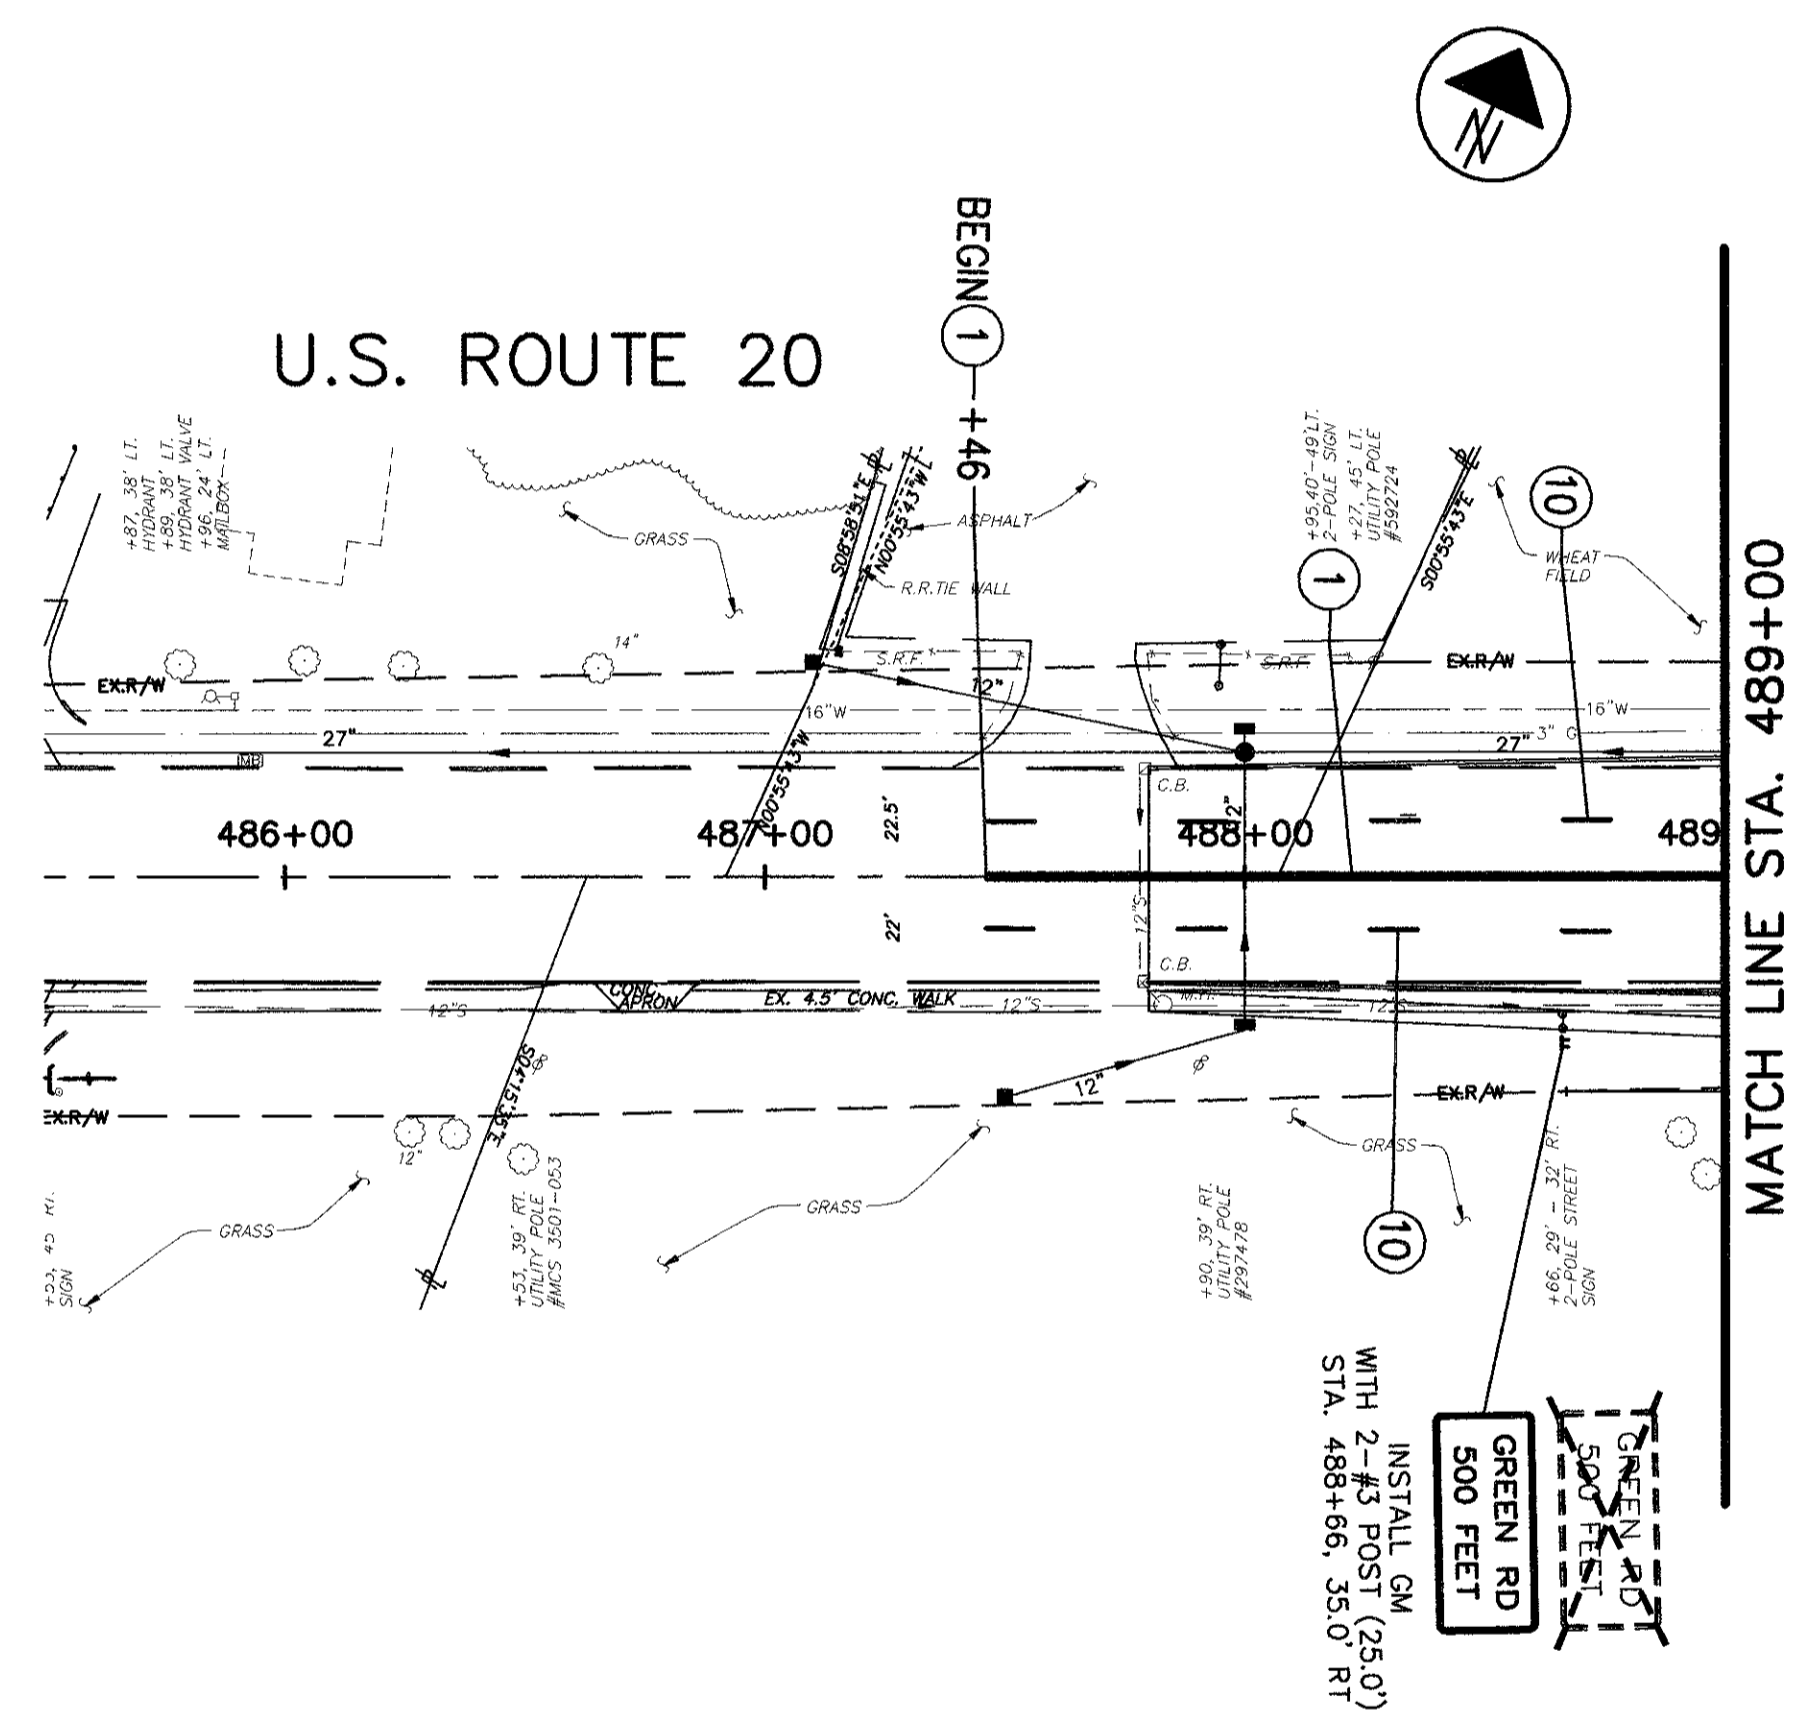

U.S. ROUTE 20

BEGIN (1) +46

MATCH LINE STA. 489+00
SEE SHEET NO. 348A

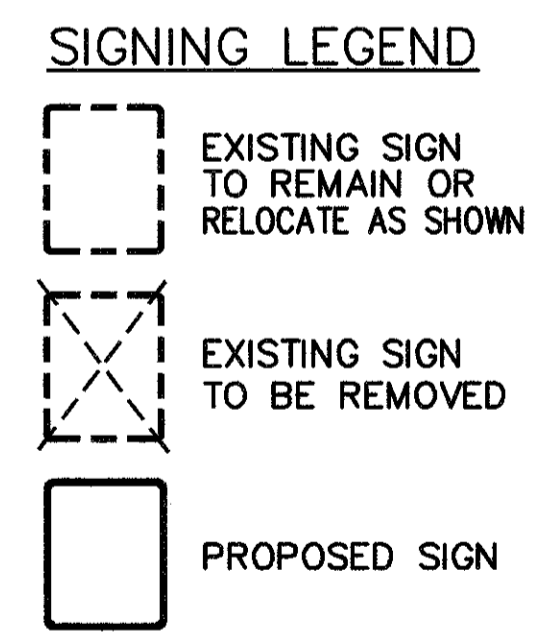




SIGNING AND PAVEMENT MARKING PLAN
U.S. 20