
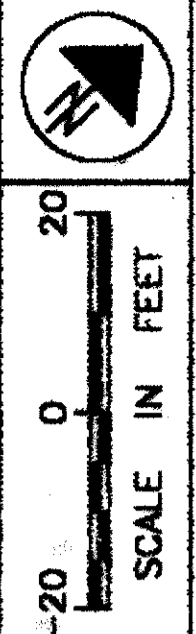


PART OF LOT 7, TRACT 2  
PART OF LOTS 5 THRU 13, TRACT 1  
PAINESVILLE, TOWNSHIP  
LAKE COUNTY, OHIO

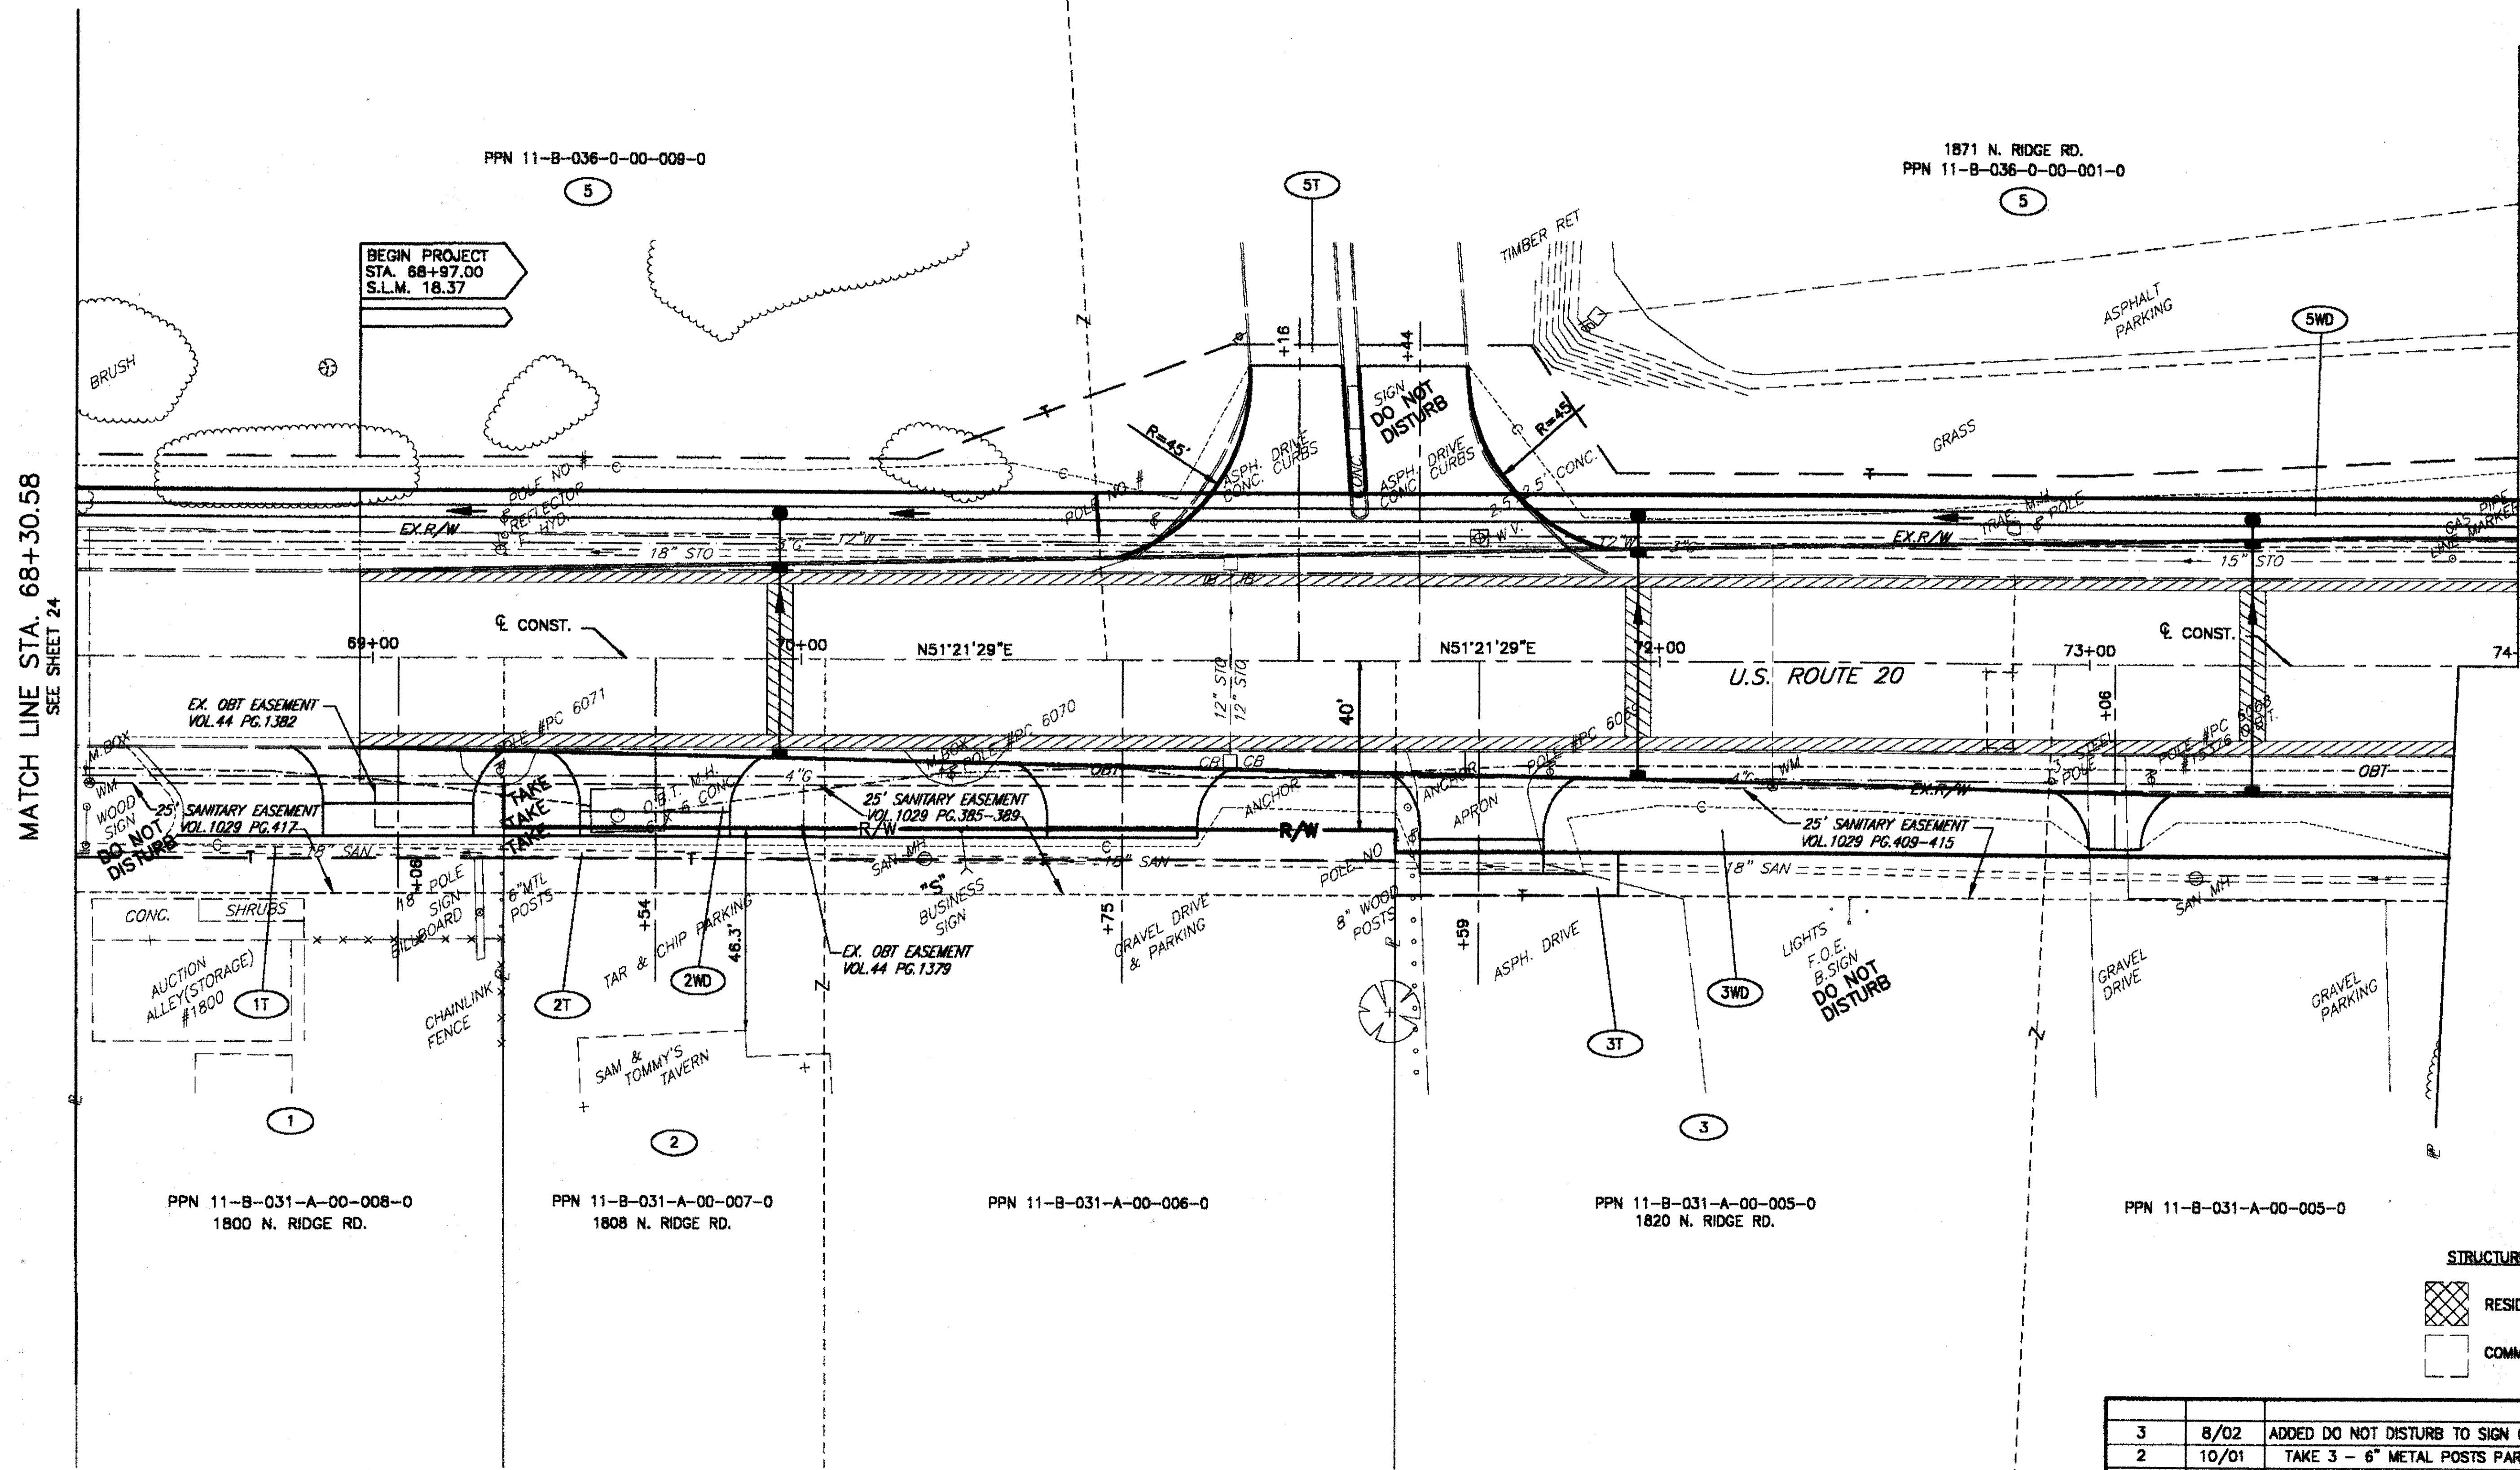

FEDERAL PROJECT NO. 20343

RIGHT OF WAY PLAN U.S. 20  
STA. 68+30.58 TO STA. 74+00.00

LAK - 20 - 18.72

STRUCTURE KEY

	RESIDENTIAL
	COMMERCIAL

REV	DATE	DESCRIPTION
3	8/02	ADDED DO NOT DISTURB TO SIGN ON PCL 5
2	10/01	TAKE 3 - 6" METAL POSTS PARCEL 1
1	7/01	REVISED PARCEL 3WD & 3T

PLAN COMPLETED:

26/87  
380  
441

H:\1998\98404.DWG\IRWPLAN1.DWG