



PART OF LOT 7, TRACT 2
PART OF LOTS 5 THRU 13, TRACT 1
PAINESVILLE, TOWNSHIP
LAKE COUNTY, OHIO

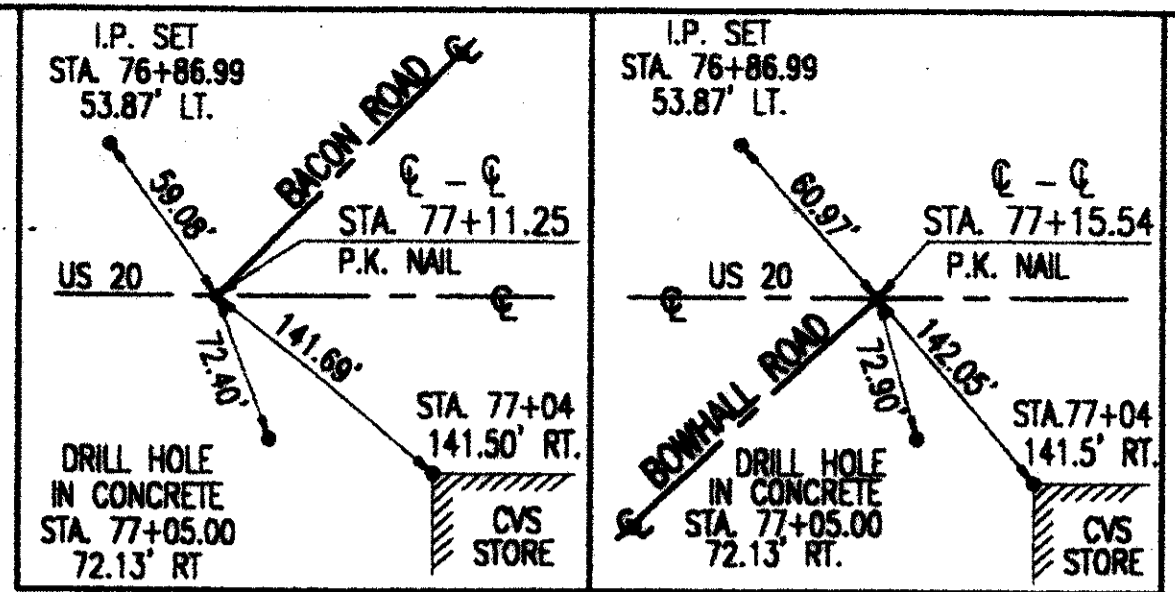

MATCH LINE STA. 74+00.00
SEE SHEET 26

MATCH LINE STA. 79+00.00
SEE SHEET 30

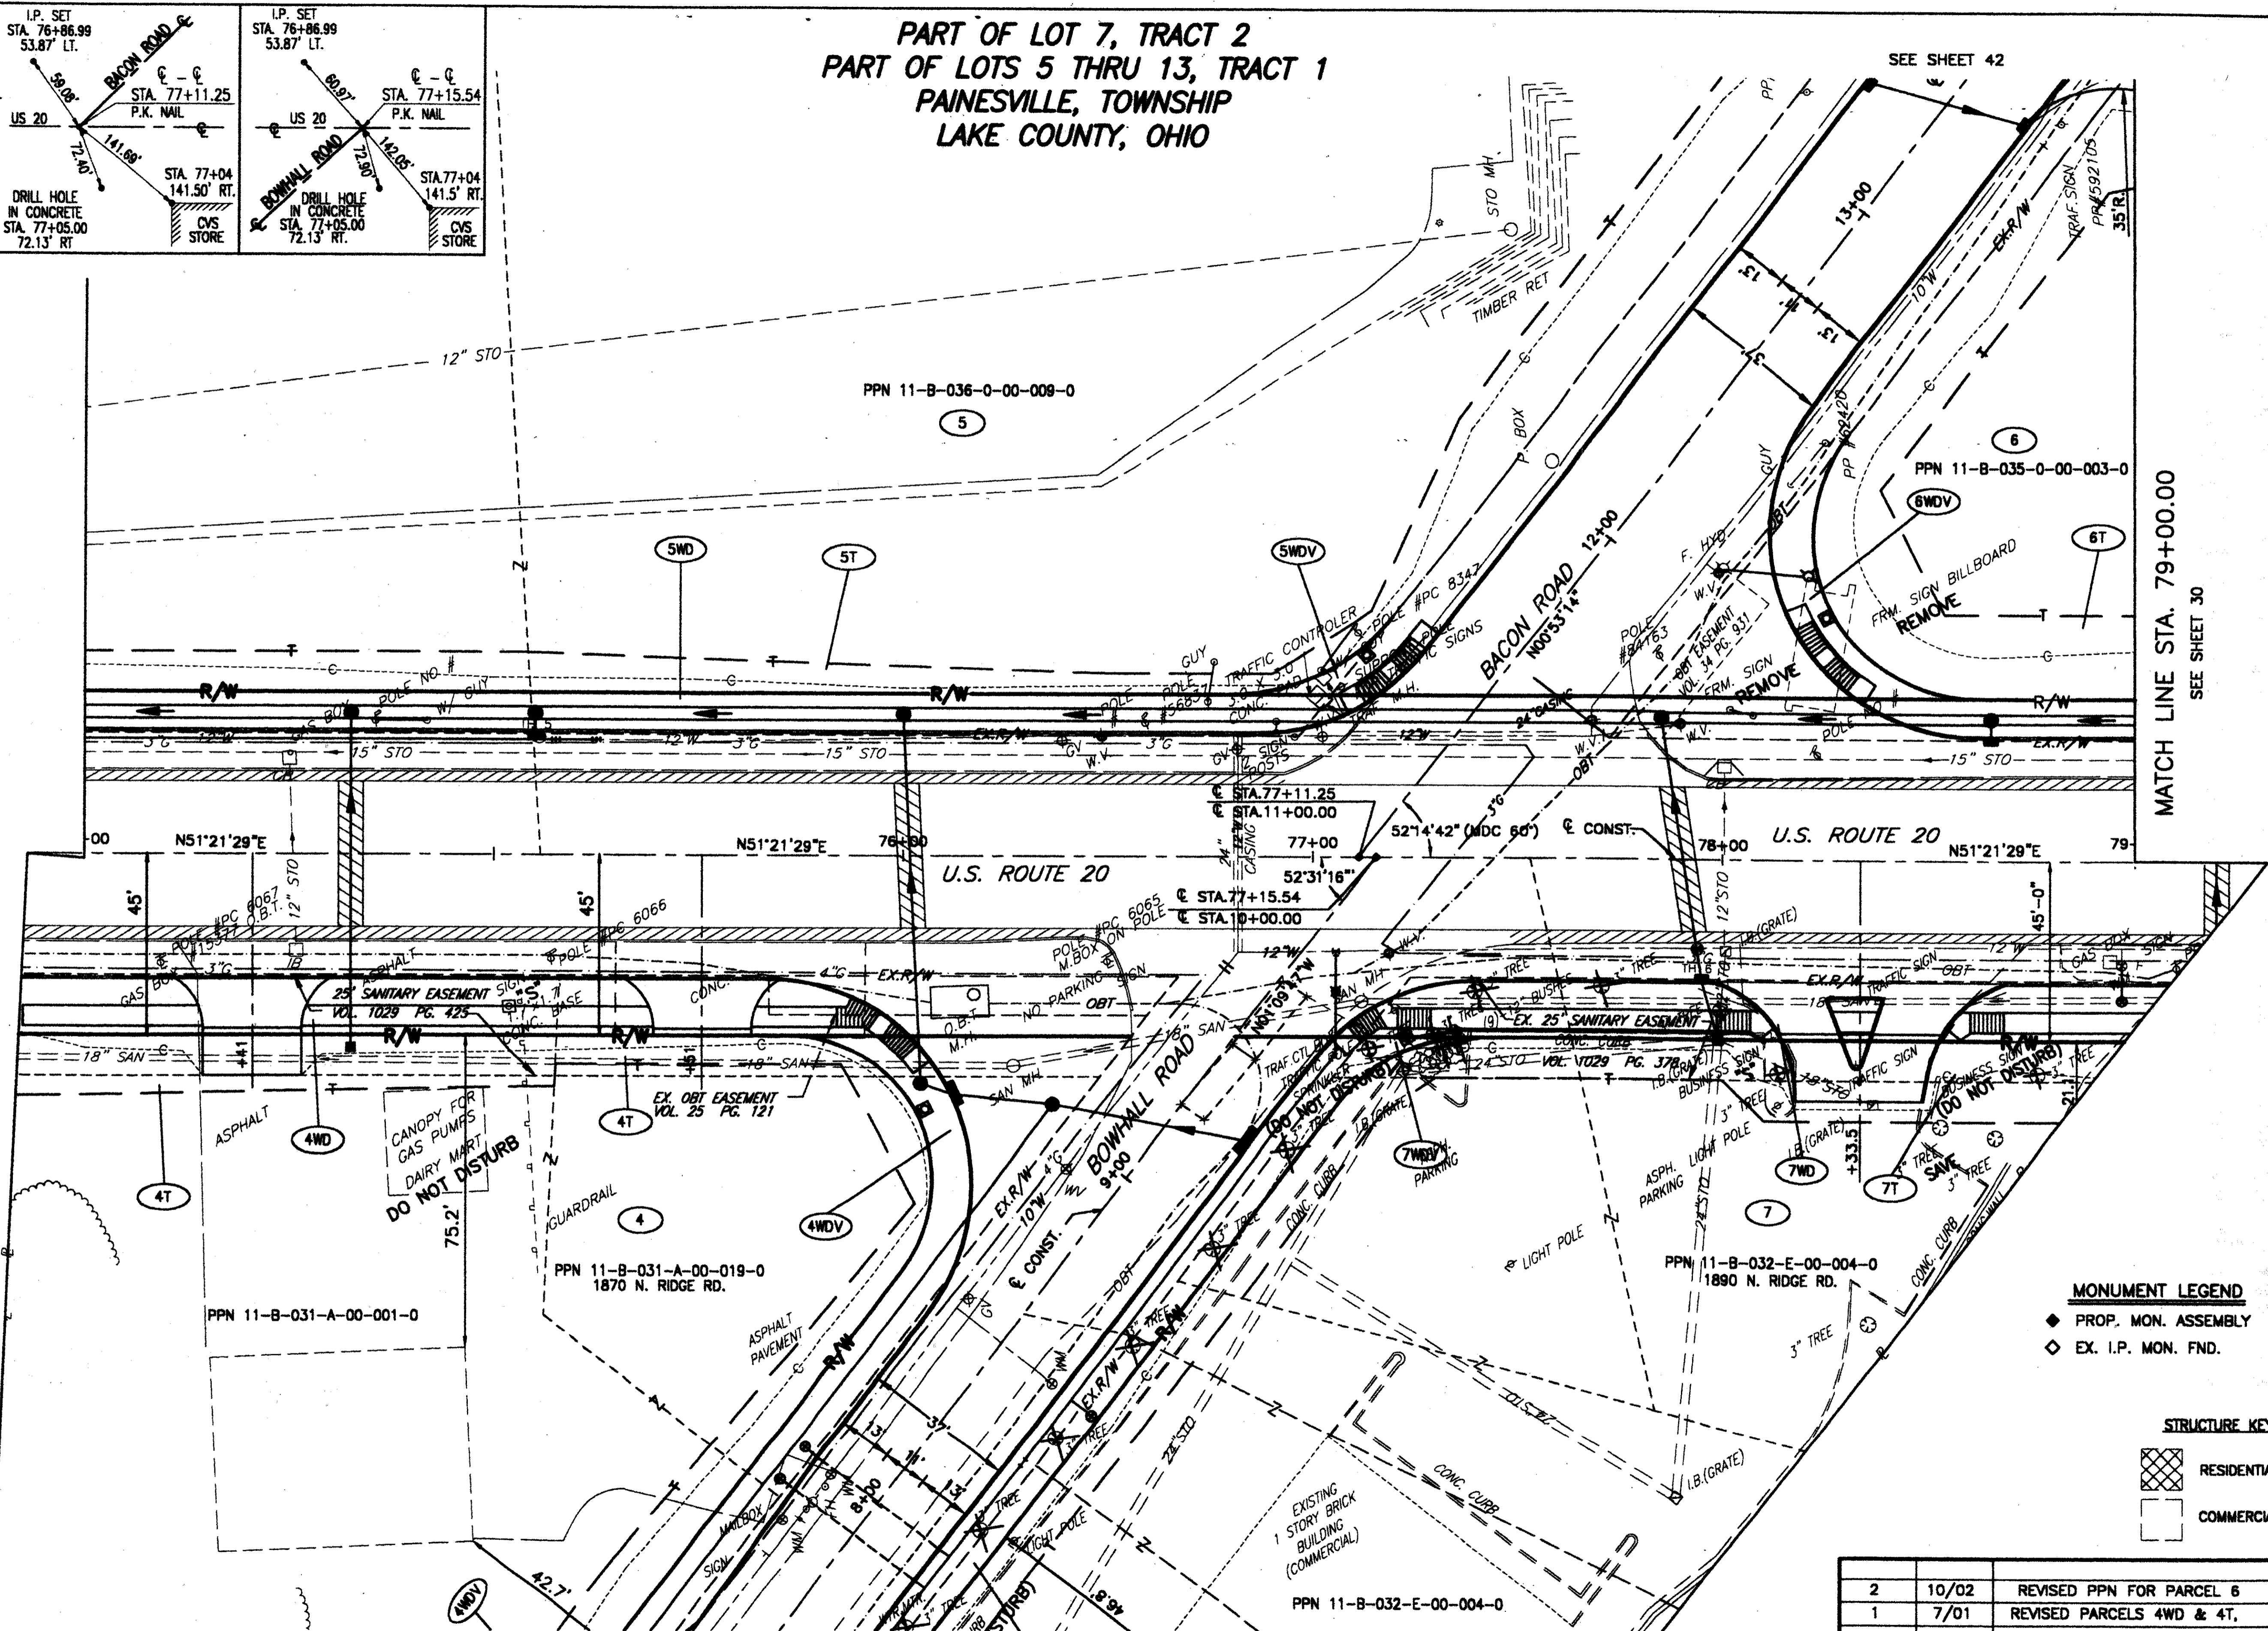

- MONUMENT LEGEND**
- ◆ PROP. MON. ASSEMBLY
 - ◇ EX. I.P. MON. FND.

- STRUCTURE KEY**
- RESIDENTIAL
 - COMMERCIAL

2	10/02	REVISED PPN FOR PARCEL 6	28/87
1	7/01	REVISED PARCELS 4WD & 4T, 6WD & 6T	382 441
REV	DATE	DESCRIPTION	
PLAN COMPLETED:			

N

20
0
-20
SCALE IN FEET

FEDERAL PROJECT NO. 20343

PID NO. 20343

RIGHT OF WAY PLAN U.S. 20
STA. 74+00.00 TO STA. 79+00.00

LAK - 20 - 18.72

H:\1998\98404\DWG\HRWPLAN2.DWG