
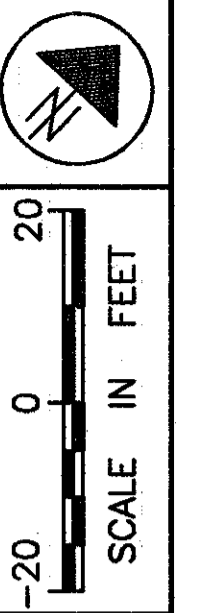


**PART OF LOT 7, TRACT 2
PART OF LOTS 5 THRU 13, TRACT 1
PAINESVILLE, TOWNSHIP
LAKE COUNTY, OHIO**

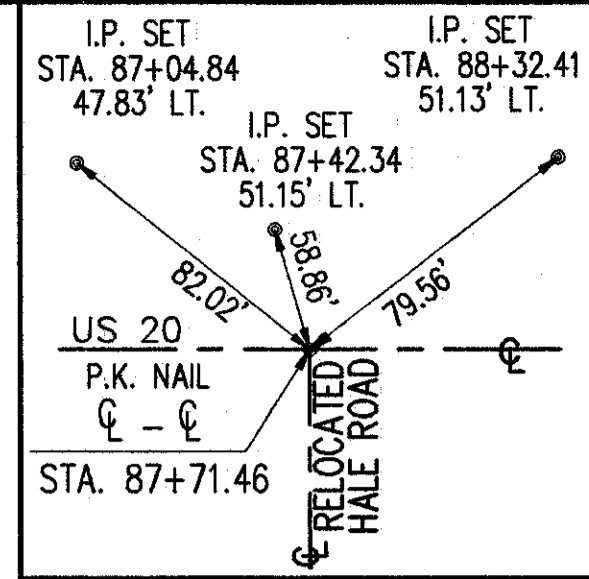


FEDERAL PROJECT NO. 20343

RIGHT OF WAY PLAN U.S. 20
STA. 87+22.57 TO STA. 91+24.00

LAK - 20 - 18.72

34/87
388
441

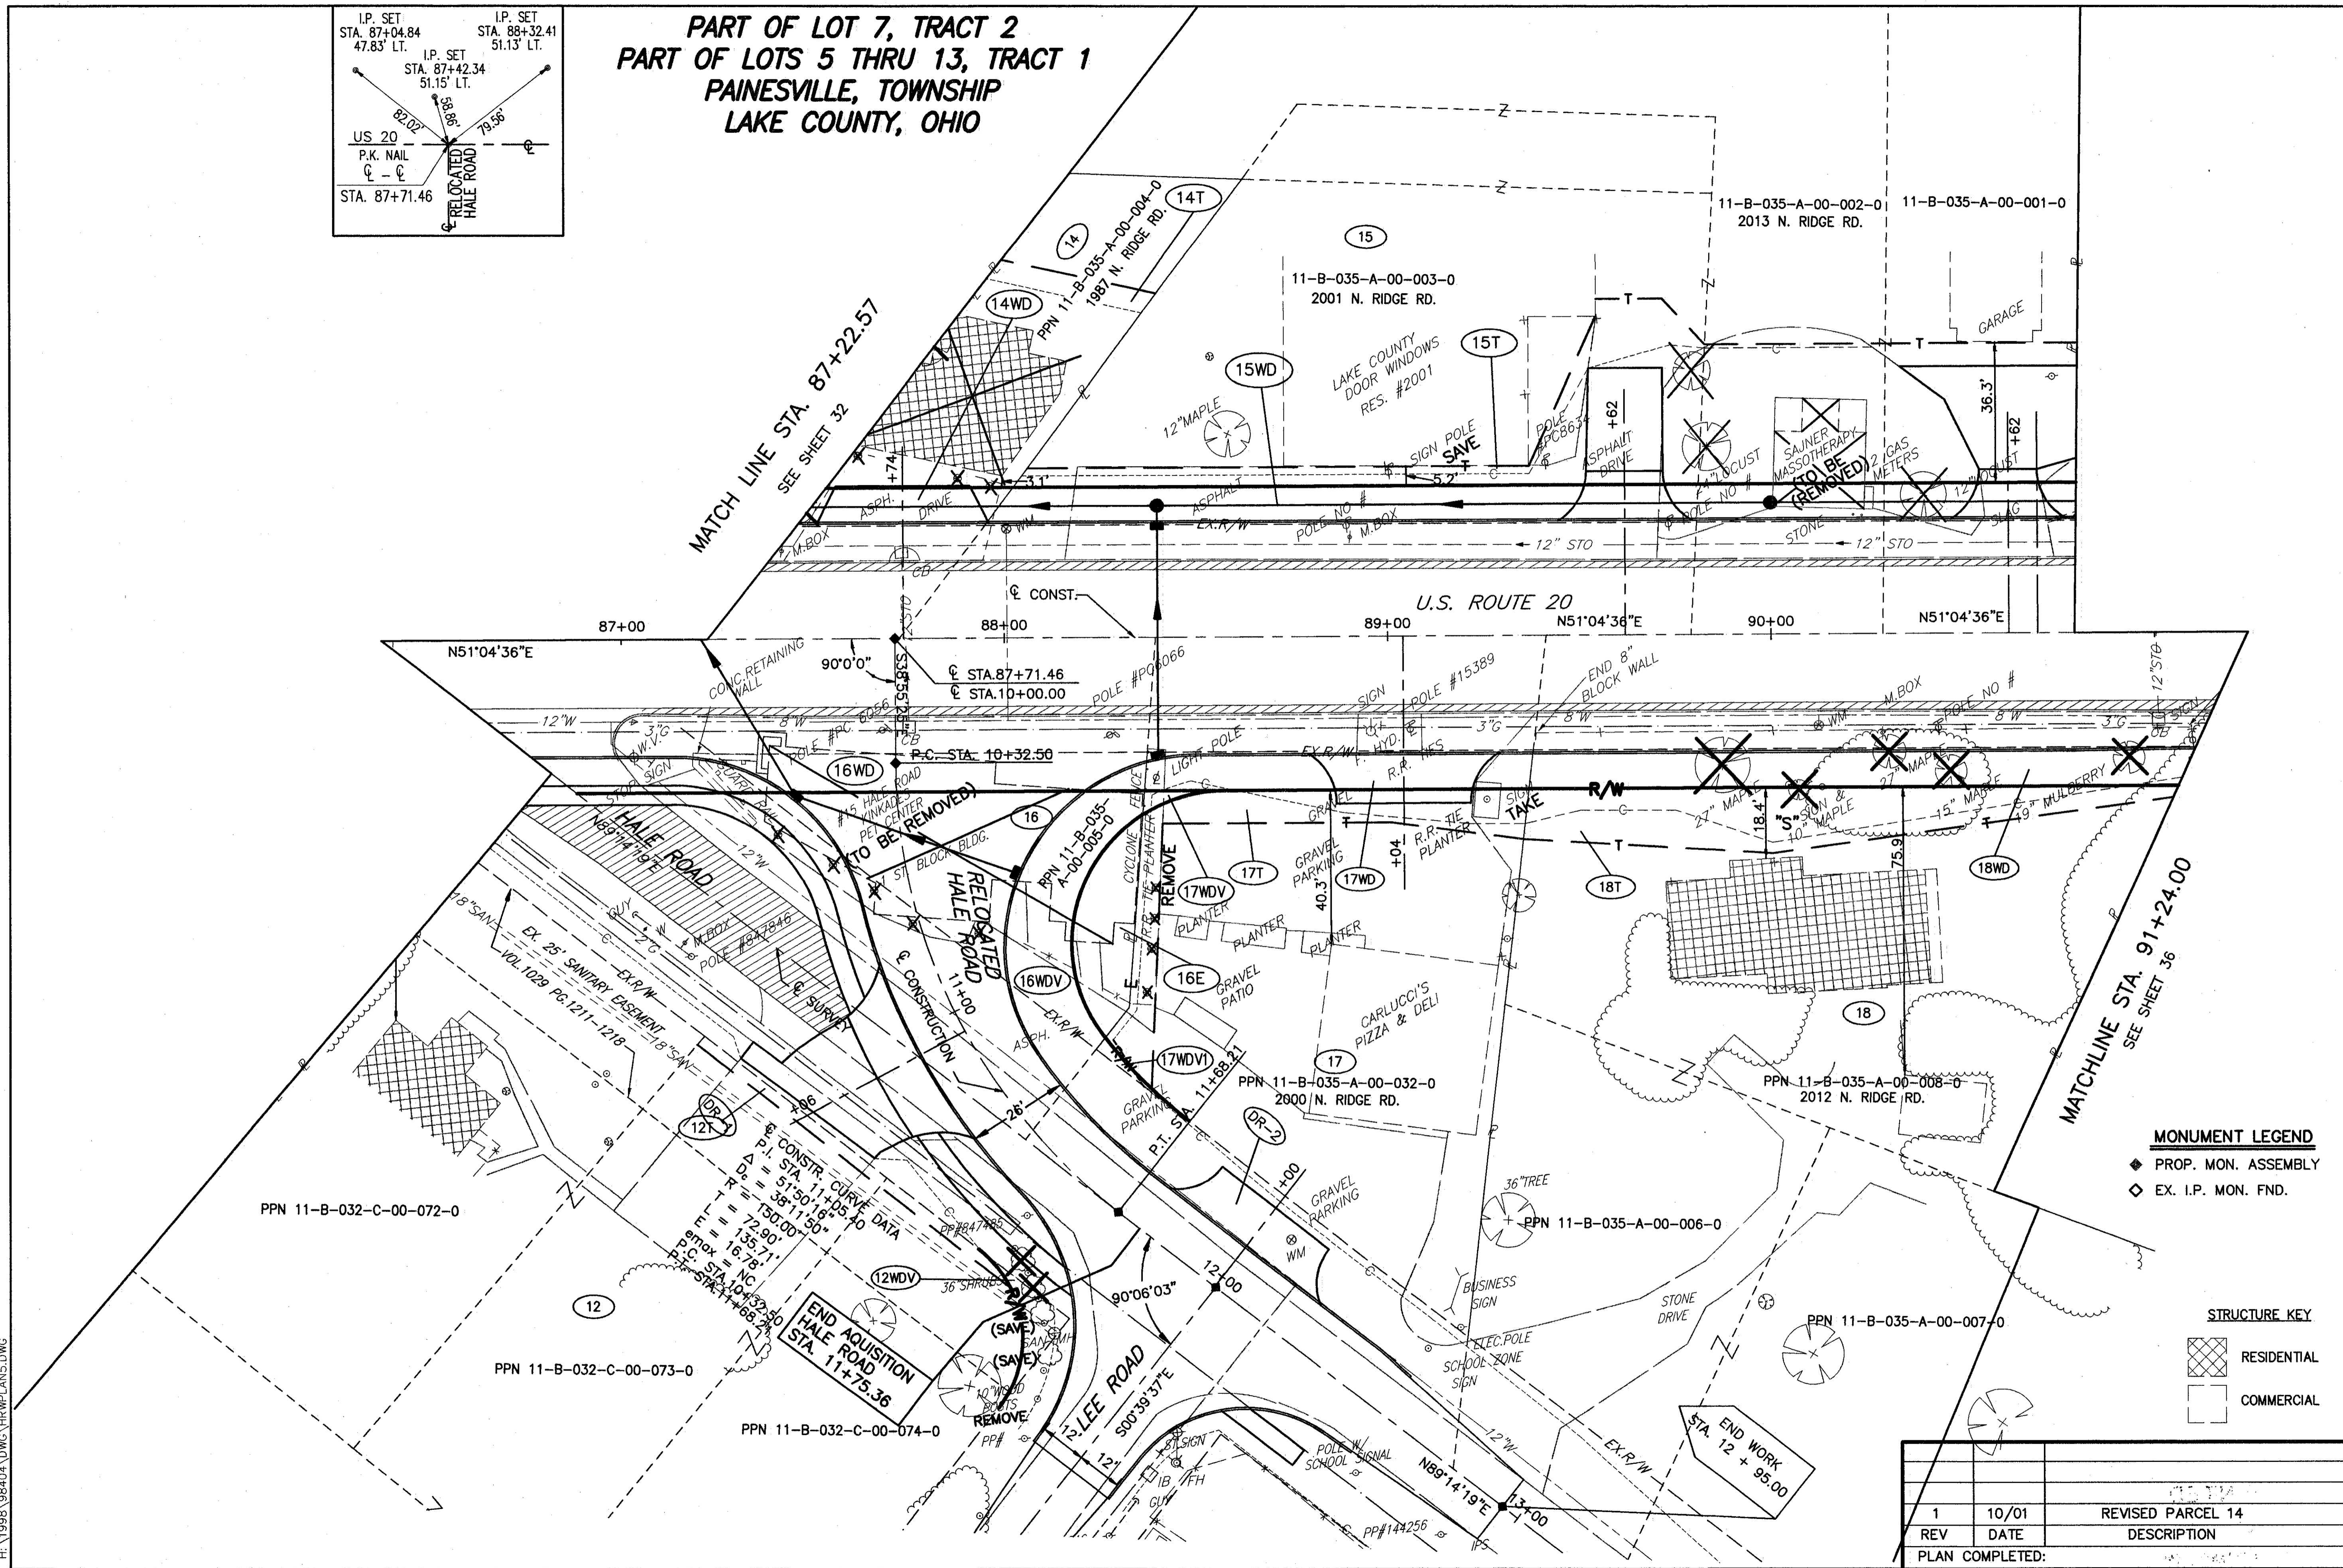

MONUMENT LEGEND
 ◆ PROP. MON. ASSEMBLY
 ◇ EX. I.P. MON. FND.

STRUCTURE KEY
 [Hatched Box] RESIDENTIAL
 [White Box] COMMERCIAL

1	10/01	REVISED PARCEL 14
REV	DATE	DESCRIPTION
PLAN COMPLETED:		

H:\1998\98404\DWG\HWPLAN5.DWG