

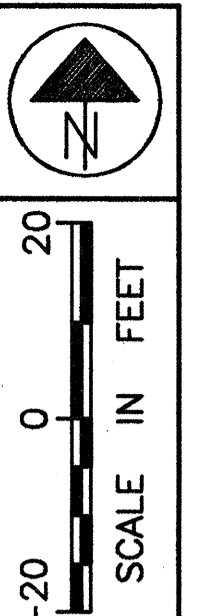


**PART OF LOT 7, TRACT 2
PART OF LOTS 5 THRU 13, TRACT 1
PAINESVILLE, TOWNSHIP
LAKE COUNTY, OHIO**

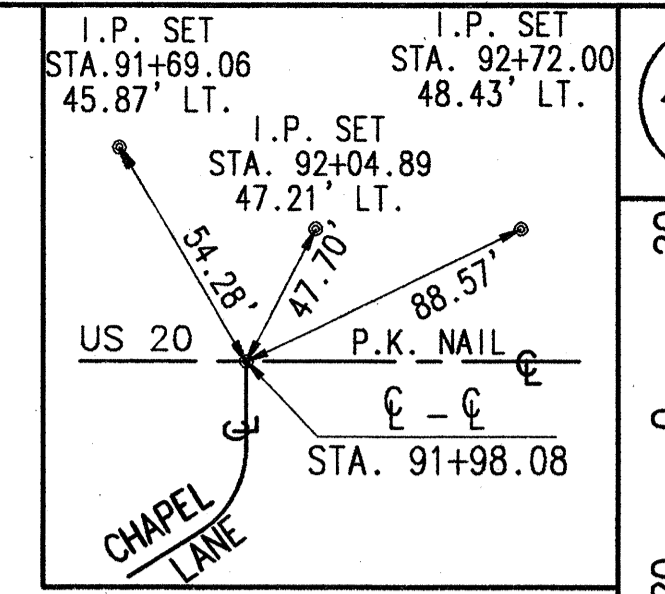

MONUMENT LEGEND
 ◆ PROP. MON. ASSEMBLY
 ◇ EX. I.P. MON. FND.

MATCH LINE STA. 91+24.00
SEE SHEET 34

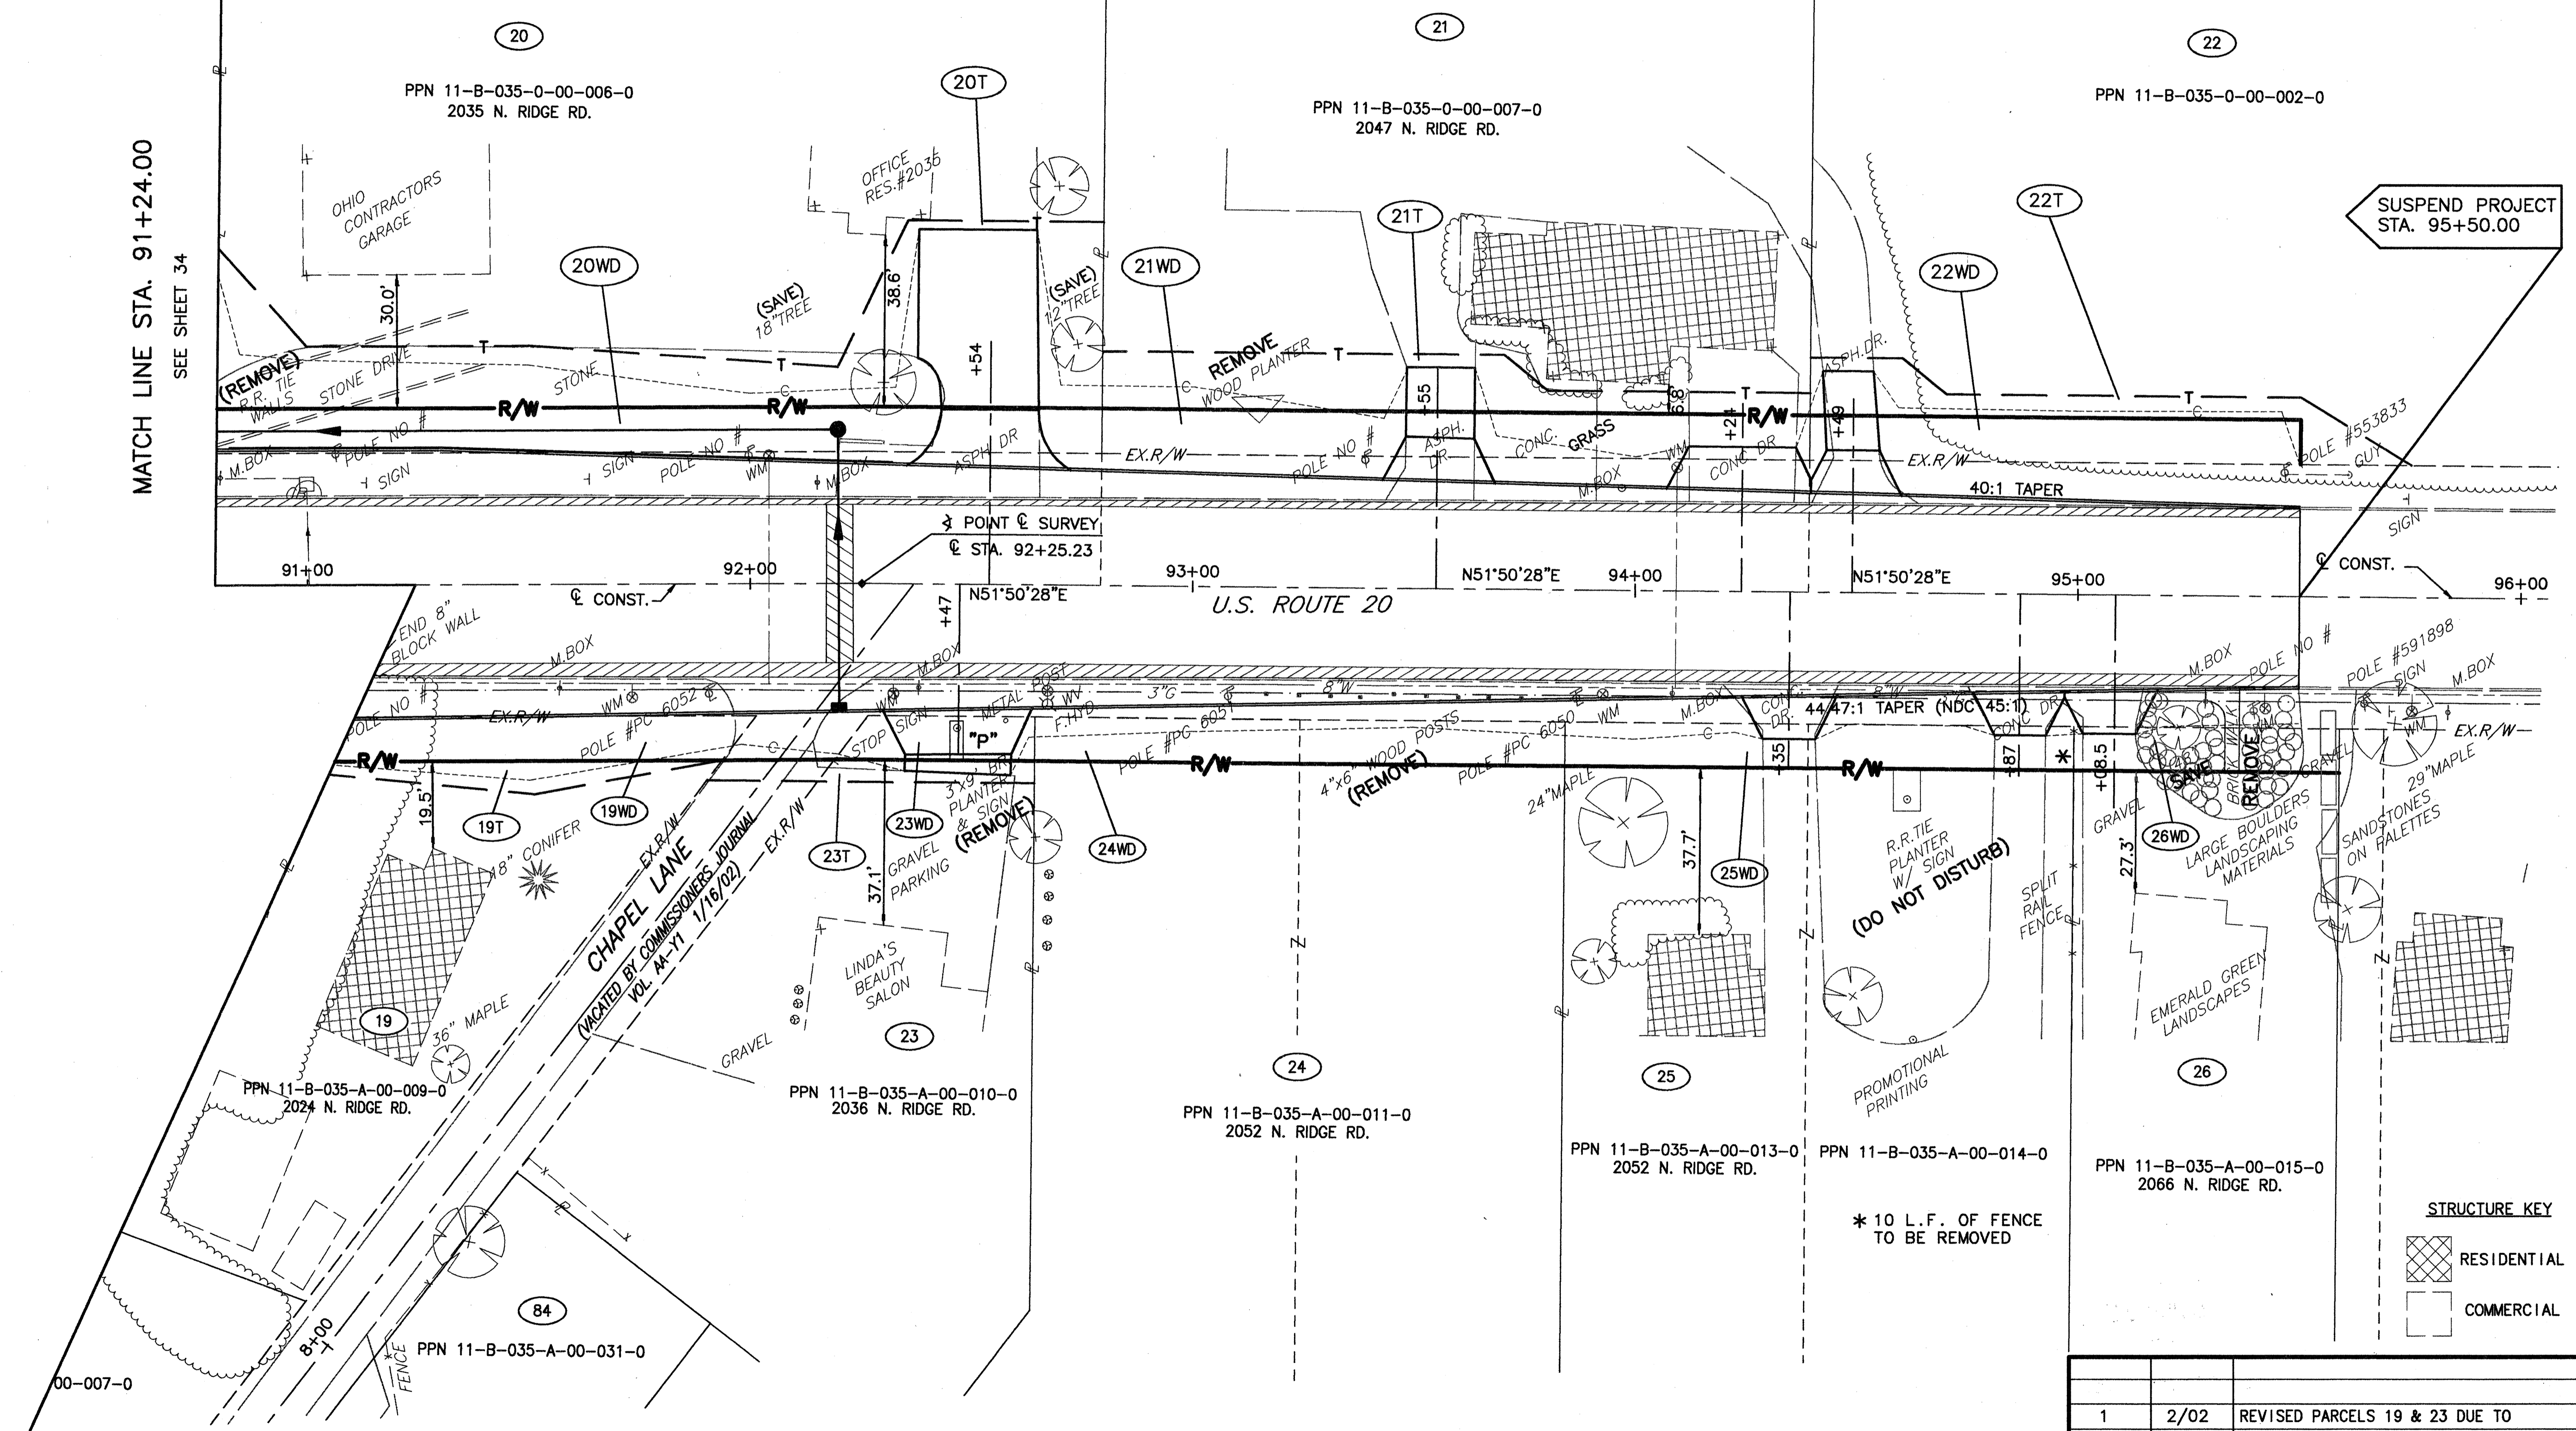

SUSPEND PROJECT
STA. 95+50.00

STRUCTURE KEY
 [Hatched Box] RESIDENTIAL
 [White Box] COMMERCIAL

* 10 L.F. OF FENCE TO BE REMOVED

FEDERAL PROJECT NO. 20343
 RIGHT OF WAY PLAN U.S. 20
 STA. 91+24.00 TO STA. 95+75.00

LAK - 20 - 18.72

1	2/02	REVISED PARCELS 19 & 23 DUE TO VACATION OF CHAPEL LANE
REV	DATE	DESCRIPTION
PLAN COMPLETED:		

36/87

390
441

RECEIVED
MAR 0 5 1998
PRODUCTION DEPT.

H:\DWG\HRWPLANG.DWG