


FED. RD. DIST. No	STATE	FED. AID PROJECT	FISCAL YEAR	36 68
10	OHIO	4(A)	1939	

CLEVELAND-BUFFALO ROAD
S.H. No 2 SEC. J (PT)
LAKE COUNTY

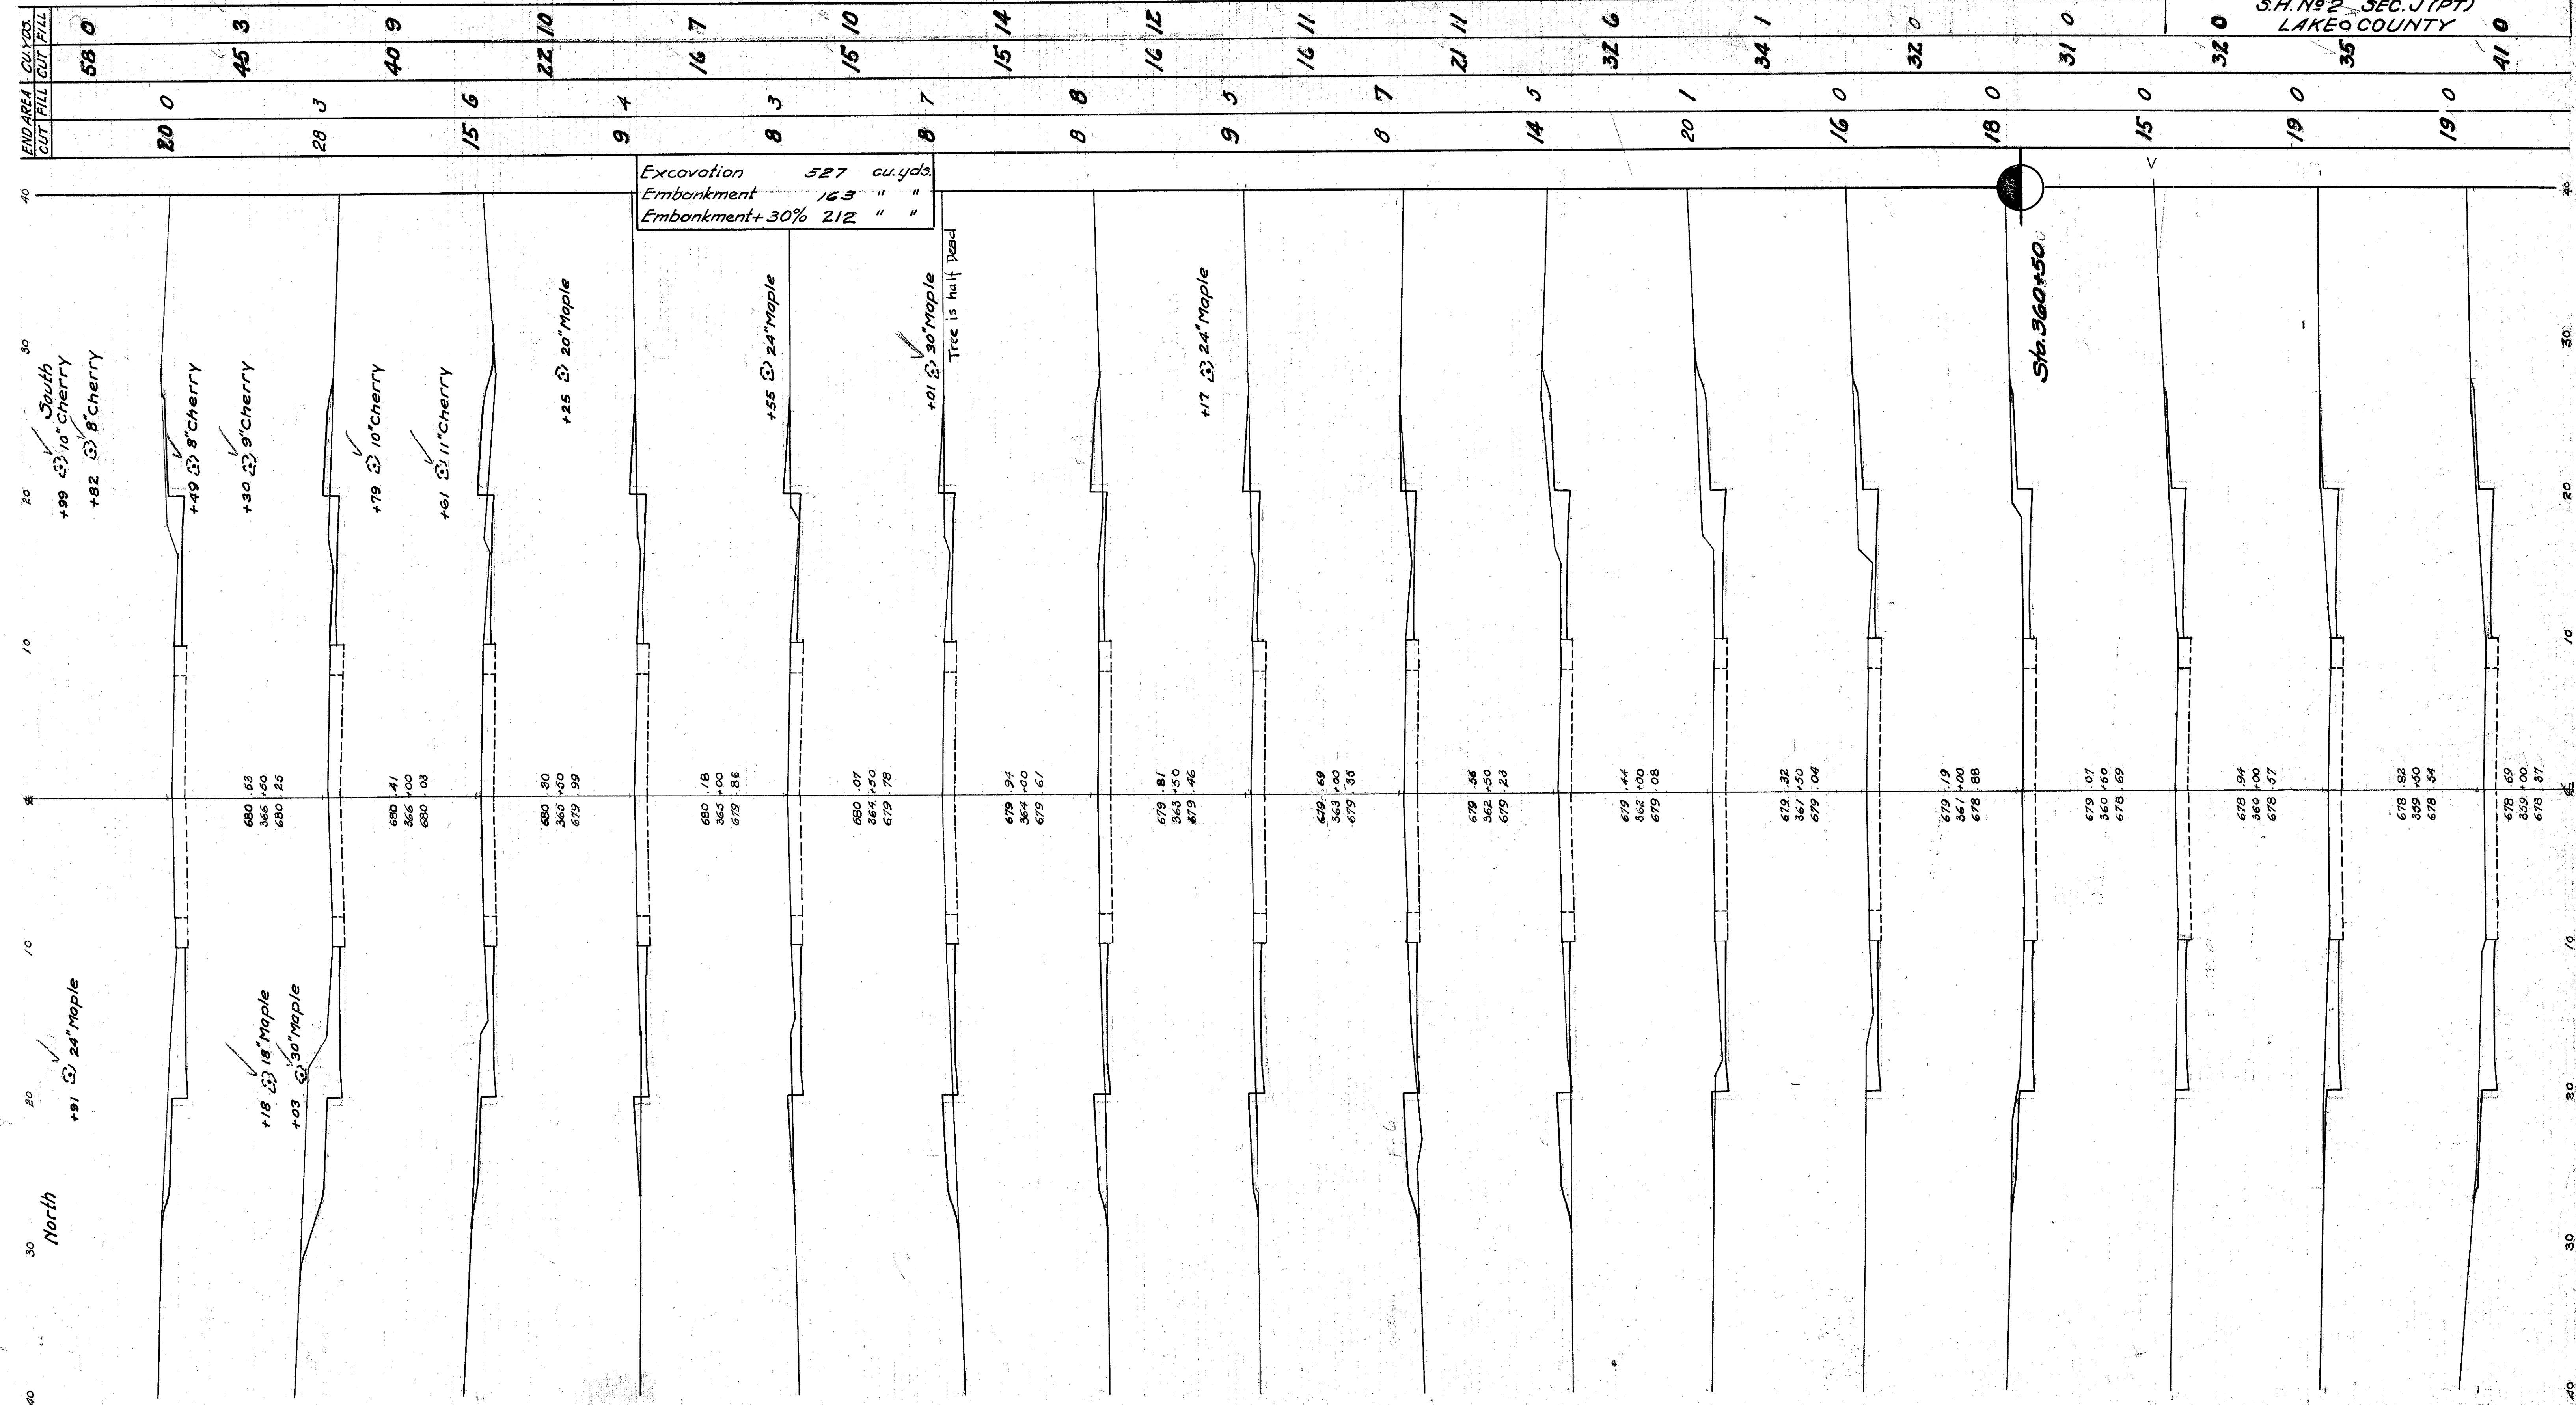

Excavation 527 cu. yds.
Embankment 163 " "
Embankment + 30% 212 " "

END AREA CUT FILL	CUT	FILL	CUT FILL

STA. 359+00 TO STA. 366+50