

FED. RD. DIVISION	STATE	PROJECT	
2	OHIO	275	

LAKE COUNTY
LAK-20-27.92

TYPICAL SECTIONS



SCALE: 3/8" = 1'-0"

PROPOSED PAVEMENT LEGEND

- (A) ITEM 301 - 7" BITUMINOUS AGGREGATE BASE: 702.01 (85-100 OR AC-20); OR 702.09, RT-11 OR RT-12; (2- 3 1/2" COURSES).
- (B) ITEM 310 - 6" SUBBASE, GRADING "B"
- (D) ITEM 403 - 2" ASPHALT CONCRETE (70-85 OR AC-20)
- (D-1) ITEM 403 - ASPHALT CONCRETE (70-85 OR AC-20) *for spot leveling*
- (E) ITEM 404 - 1" ASPHALT CONCRETE (70-85 OR AC-20)
- (F) ITEM 408 - PRIME COAT 702.09, RT-2 OR RT-3 APPLIED AT THE RATE OF 0.40 GALLONS PER SQ. YD.
- (G) ITEM 407 - TACK COAT: 702.04, MS-2 OR RS-1; OR 702.02, RC-70 OR RC-250 APPLIED AT THE RATE OF 0.10 GALLONS PER SQ. YD.
- (H) ITEM 609 - CONCRETE CURB, STANDARD TYPE 6

EXISTING PAVEMENT LEGEND

- (1) 4" ASPHALT CONCRETE
- (2) 1 1/2" SEAL COAT
- (3) 2 1/2" BANK RUN GRAVEL
- (4) 4 1/2" ASPHALT CONCRETE
- (5) 6"-7"-6" REINFORCED CONCRETE PAVEMENT
- (6) 3" ASPHALT CONCRETE
- (7) 5" GRANULATED SLAG
- (8) 6" ASPHALT CONCRETE
- (9) 9"-7"-7"-9" REINFORCED CONCRETE PAVEMENT
- (10) 3" ASPHALT CONCRETE BASE
- (11) 1/4" INSULATION COURSE
- (12) 6"x 16" CURB, TO BE REMOVED UNDER ITEM 202
- (13) 4" BRICK PAVEMENT
- (14) 9" CONCRETE WIDENING
- (15) 5" CONCRETE BASE
- (16) 8" CONCRETE BASE

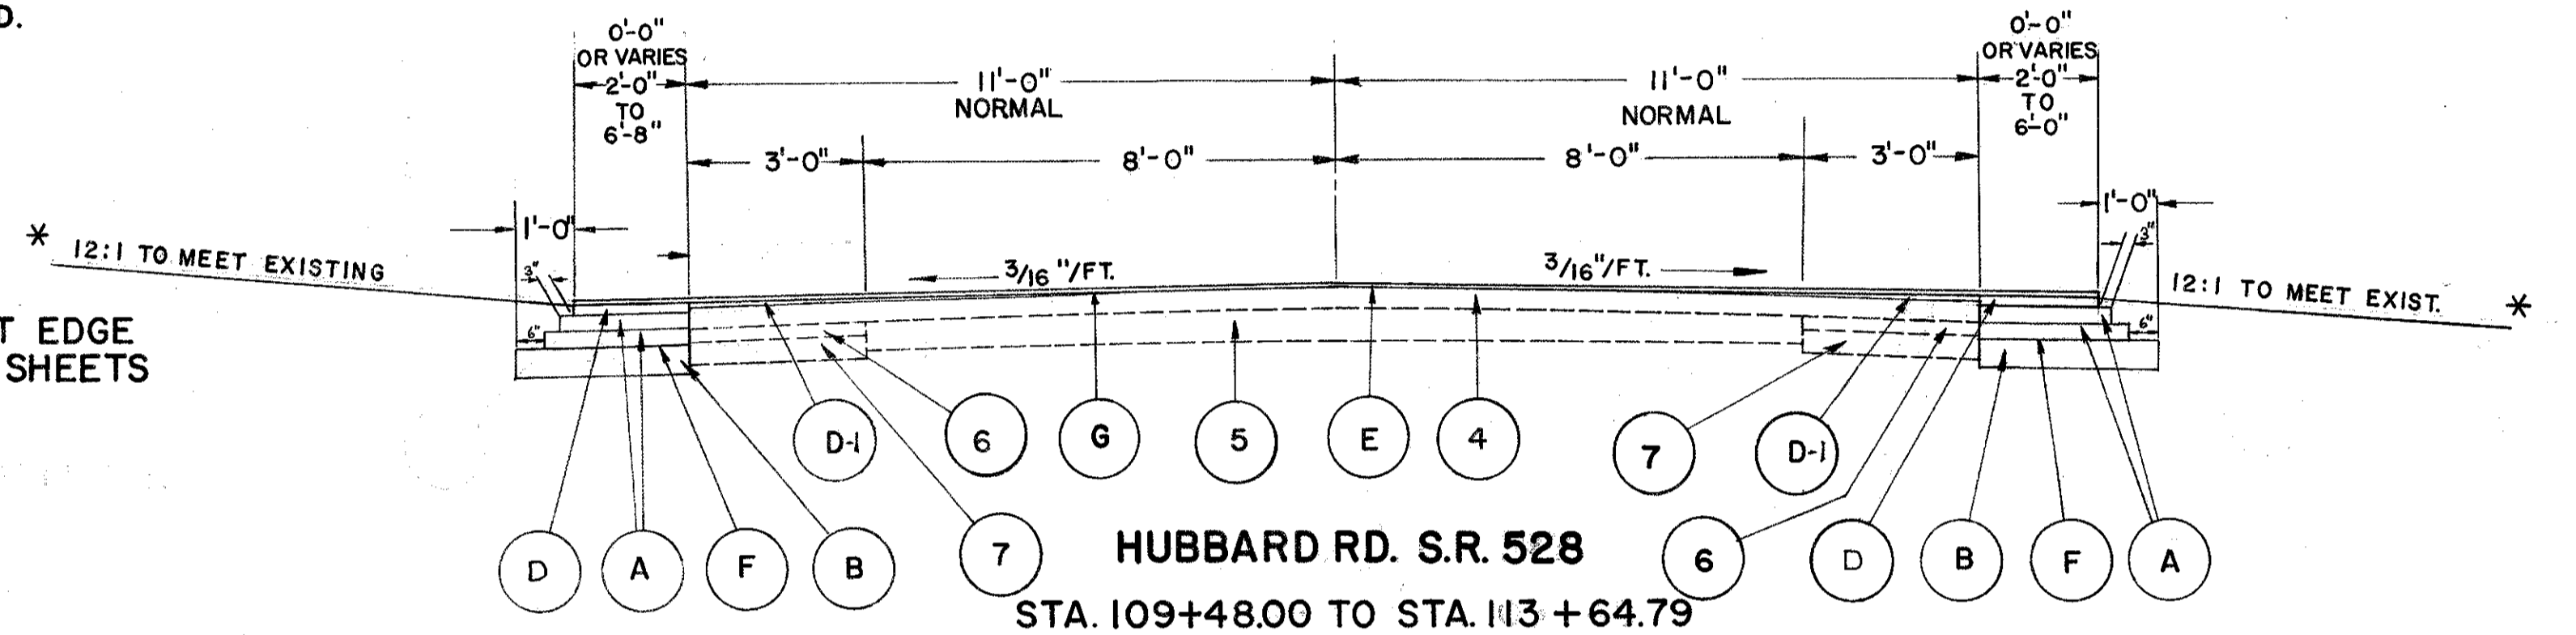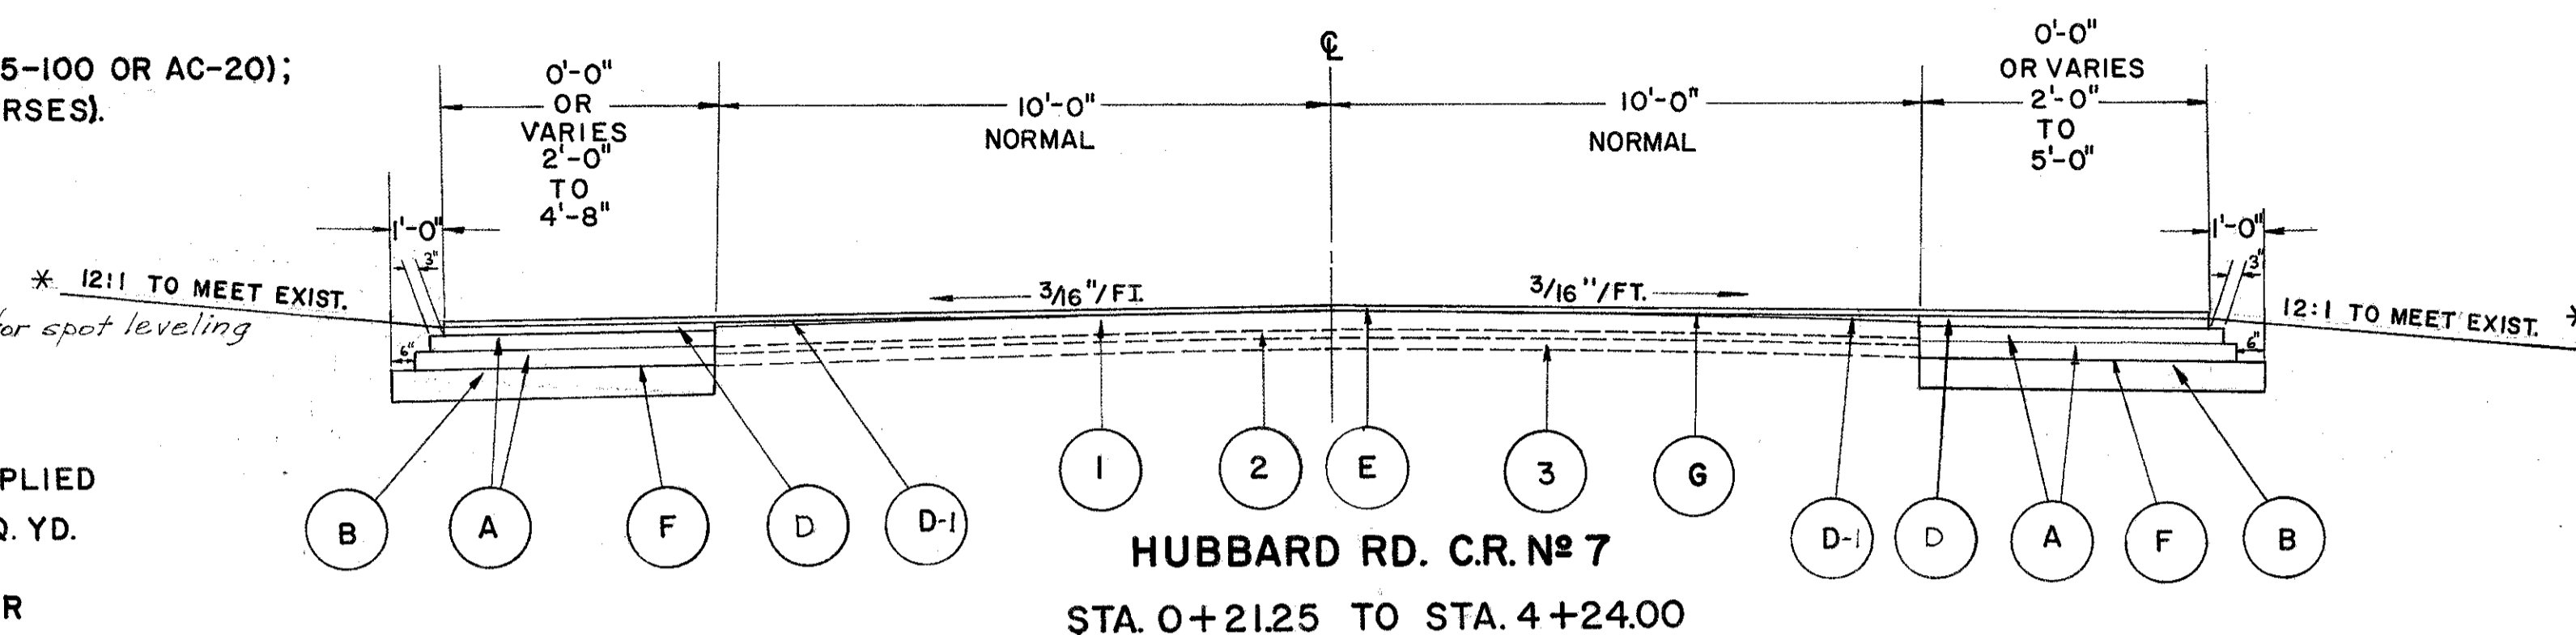

NOTE: FOR WORK REQUIRED BEYOND PAVEMENT EDGE REFER TO APPROPRIATE CROSS SECTION SHEETS

* CUT AND FILL SECTIONS ARE INTERCHANGEABLE WITH EITHER SIDE OF THE ROADWAY.

