



LAKE COUNTY
CITY OF MENTOR
LOTS 2,6,7 TRACT 4

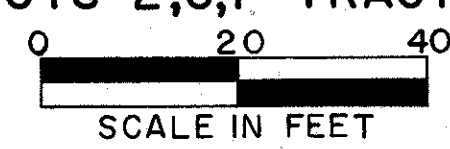

CURVE DATA

P.I. STA. 59+02.91
 $\Delta = 6^{\circ} 35' 06''$
 $Dc = 1^{\circ} 00' 00''$
 $R = 5729.58'$
 $L = 658.51'$
 $T = 329.61'$
 $E = 94.1'$

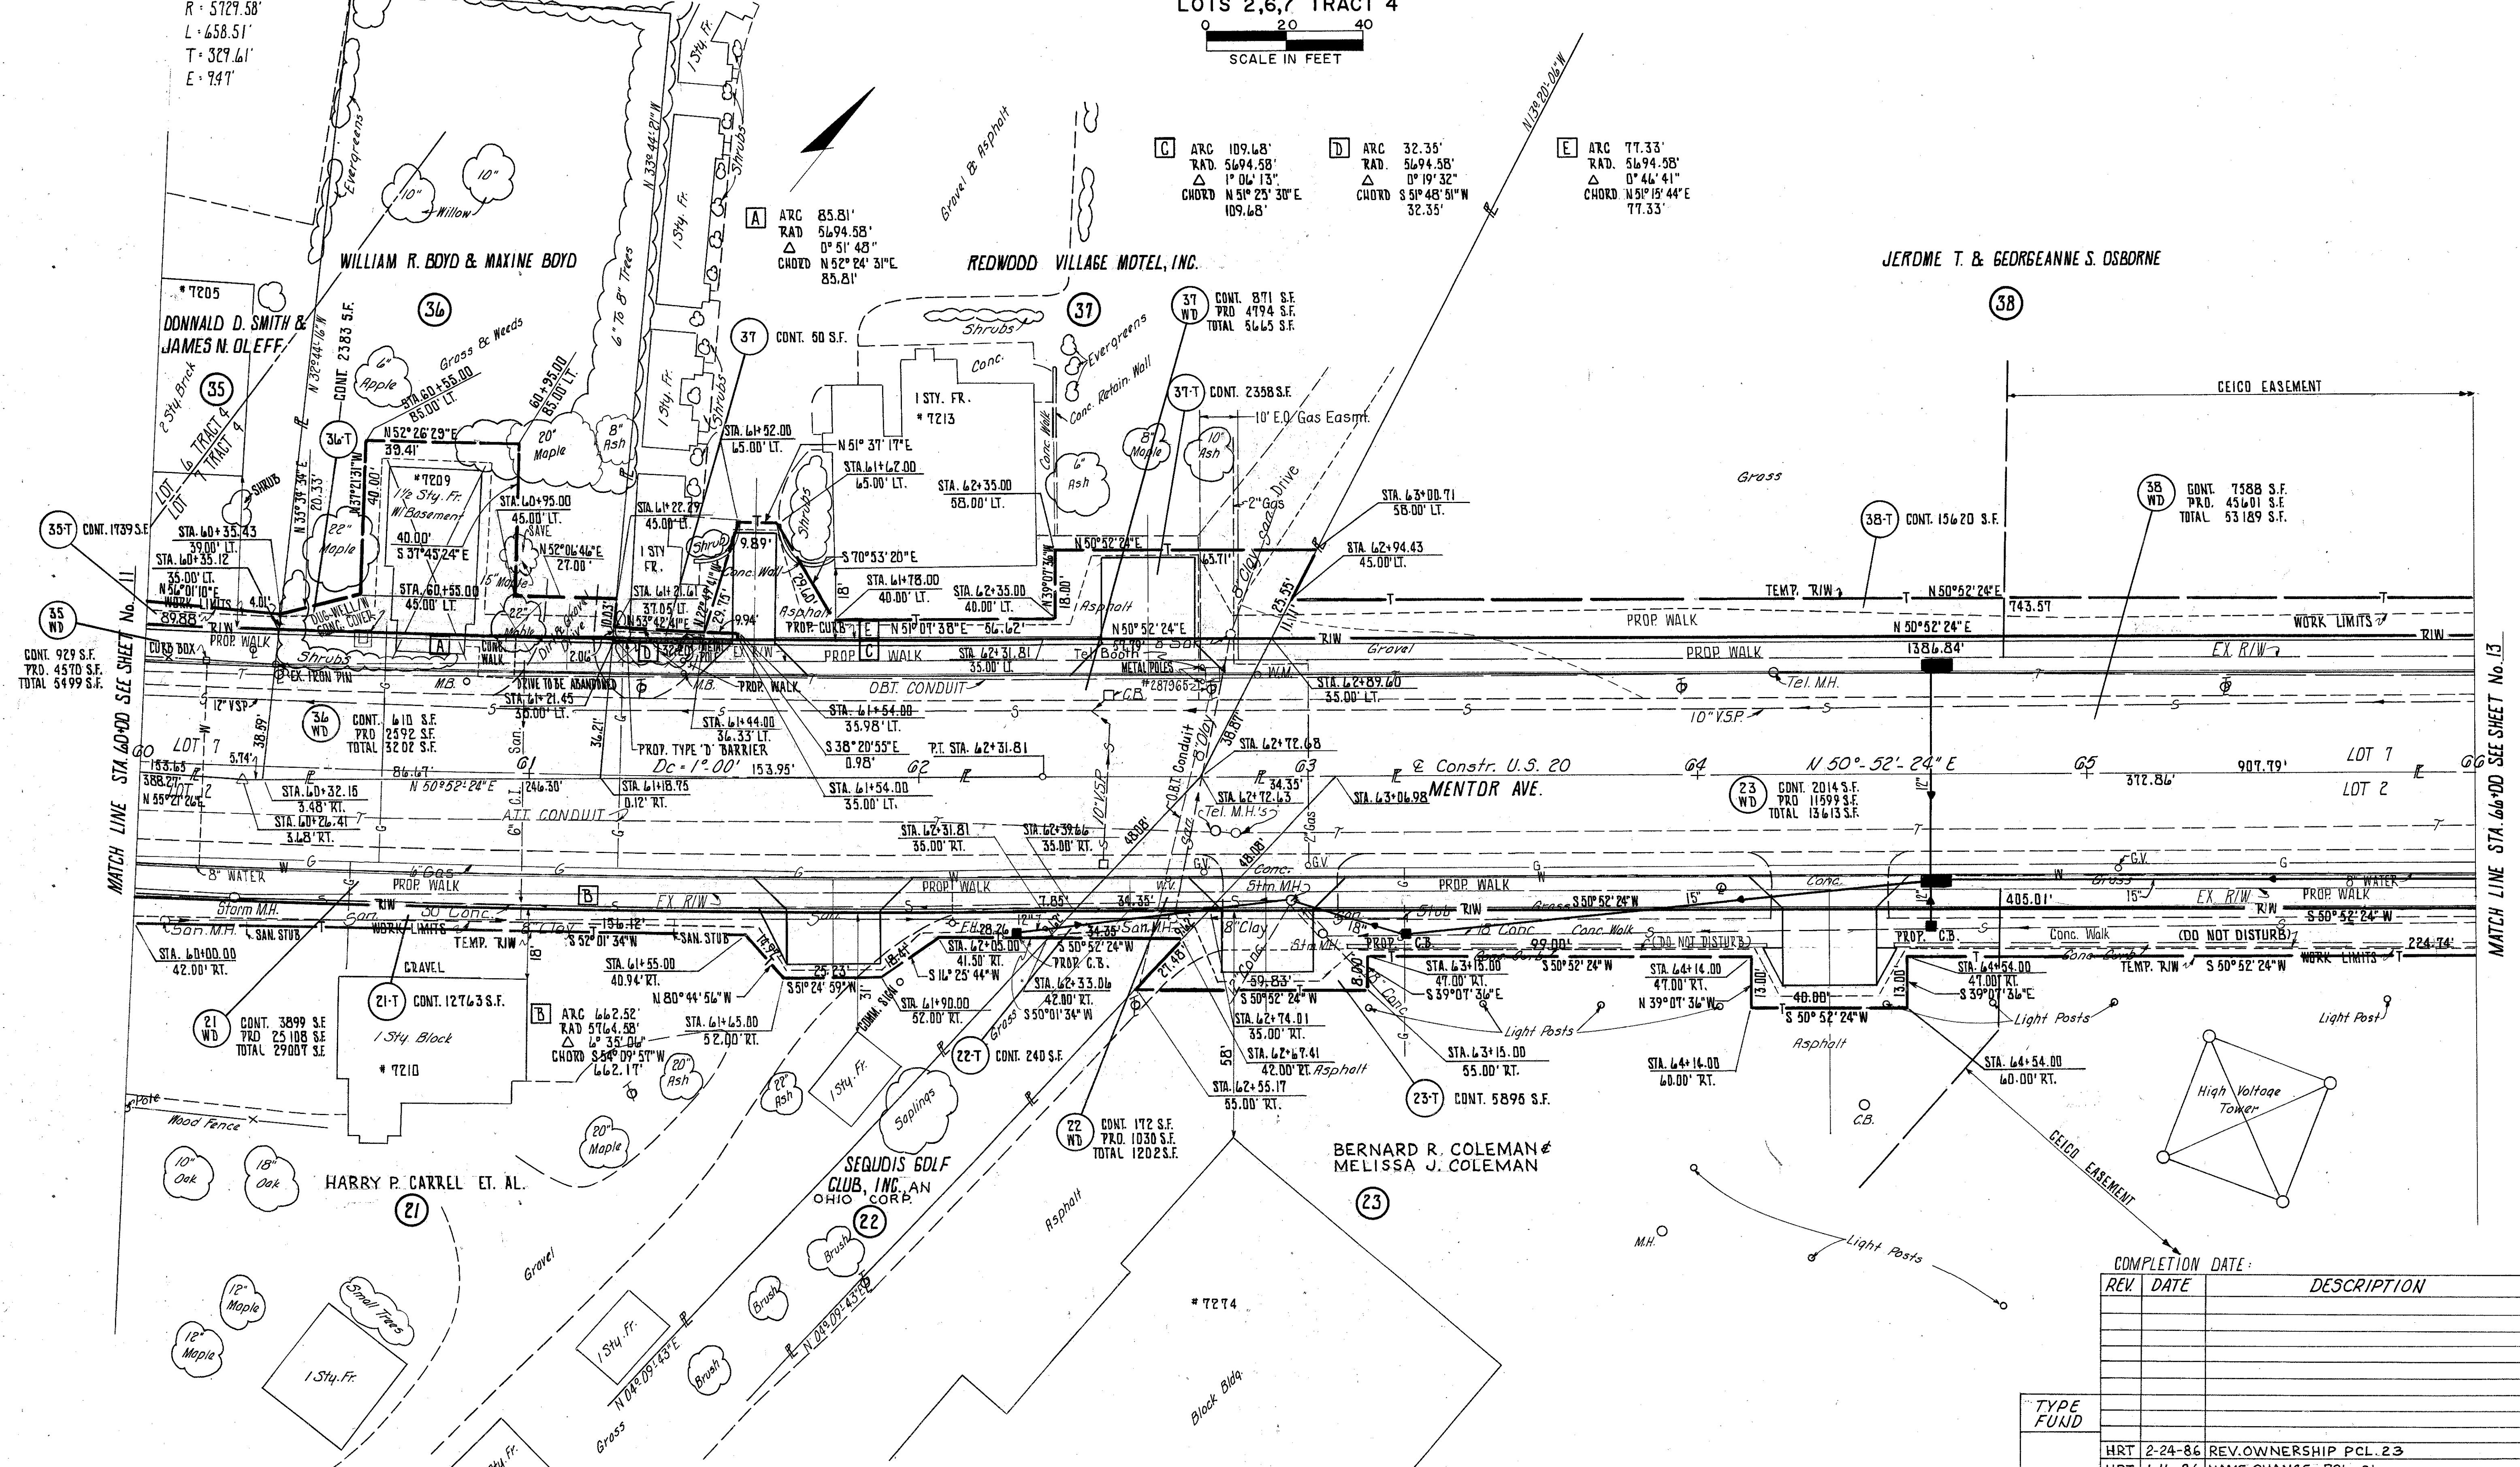

A ARC 85.81'
 RAD 5694.58'
 $\Delta 0^{\circ} 51' 48''$
 CHORD N 52^{\circ} 24' 31"E
 85.81'

C ARC 109.68'
 RAD 5694.58'
 $\Delta 1^{\circ} 04' 13''$
 CHORD N 51^{\circ} 25' 30"E
 109.68'

D ARC 32.35'
 RAD 5694.58'
 $\Delta 0^{\circ} 19' 32''$
 CHORD S 51^{\circ} 48' 51"W
 32.35'

E ARC 77.33'
 RAD 5694.58'
 $\Delta 0^{\circ} 44' 41''$
 CHORD N 51^{\circ} 15' 44"E
 77.33'

MATCH LINE STA 60+00 SEE SHEET No. 11

MATCH LINE STA 66+00 SEE SHEET No. 13

COMPLETION DATE:

REV.	DATE	DESCRIPTION

TYPE	FUND
HRT	2-24-86 REV. OWNERSHIP PCL. 23
HRT	1-16-86 NAME CHANGE - PCL. 21