



FHWA REGION	STATE	PROJECT
5	OHIO	

LAKE COUNTY
LAK-20-6.65
R/W PLANS

107
114

14
21

LAKE COUNTY
CITY OF MENTOR
LOTS 2,4,7,8 TRACT 4
MIDLAND MOOR SUBD. No.1

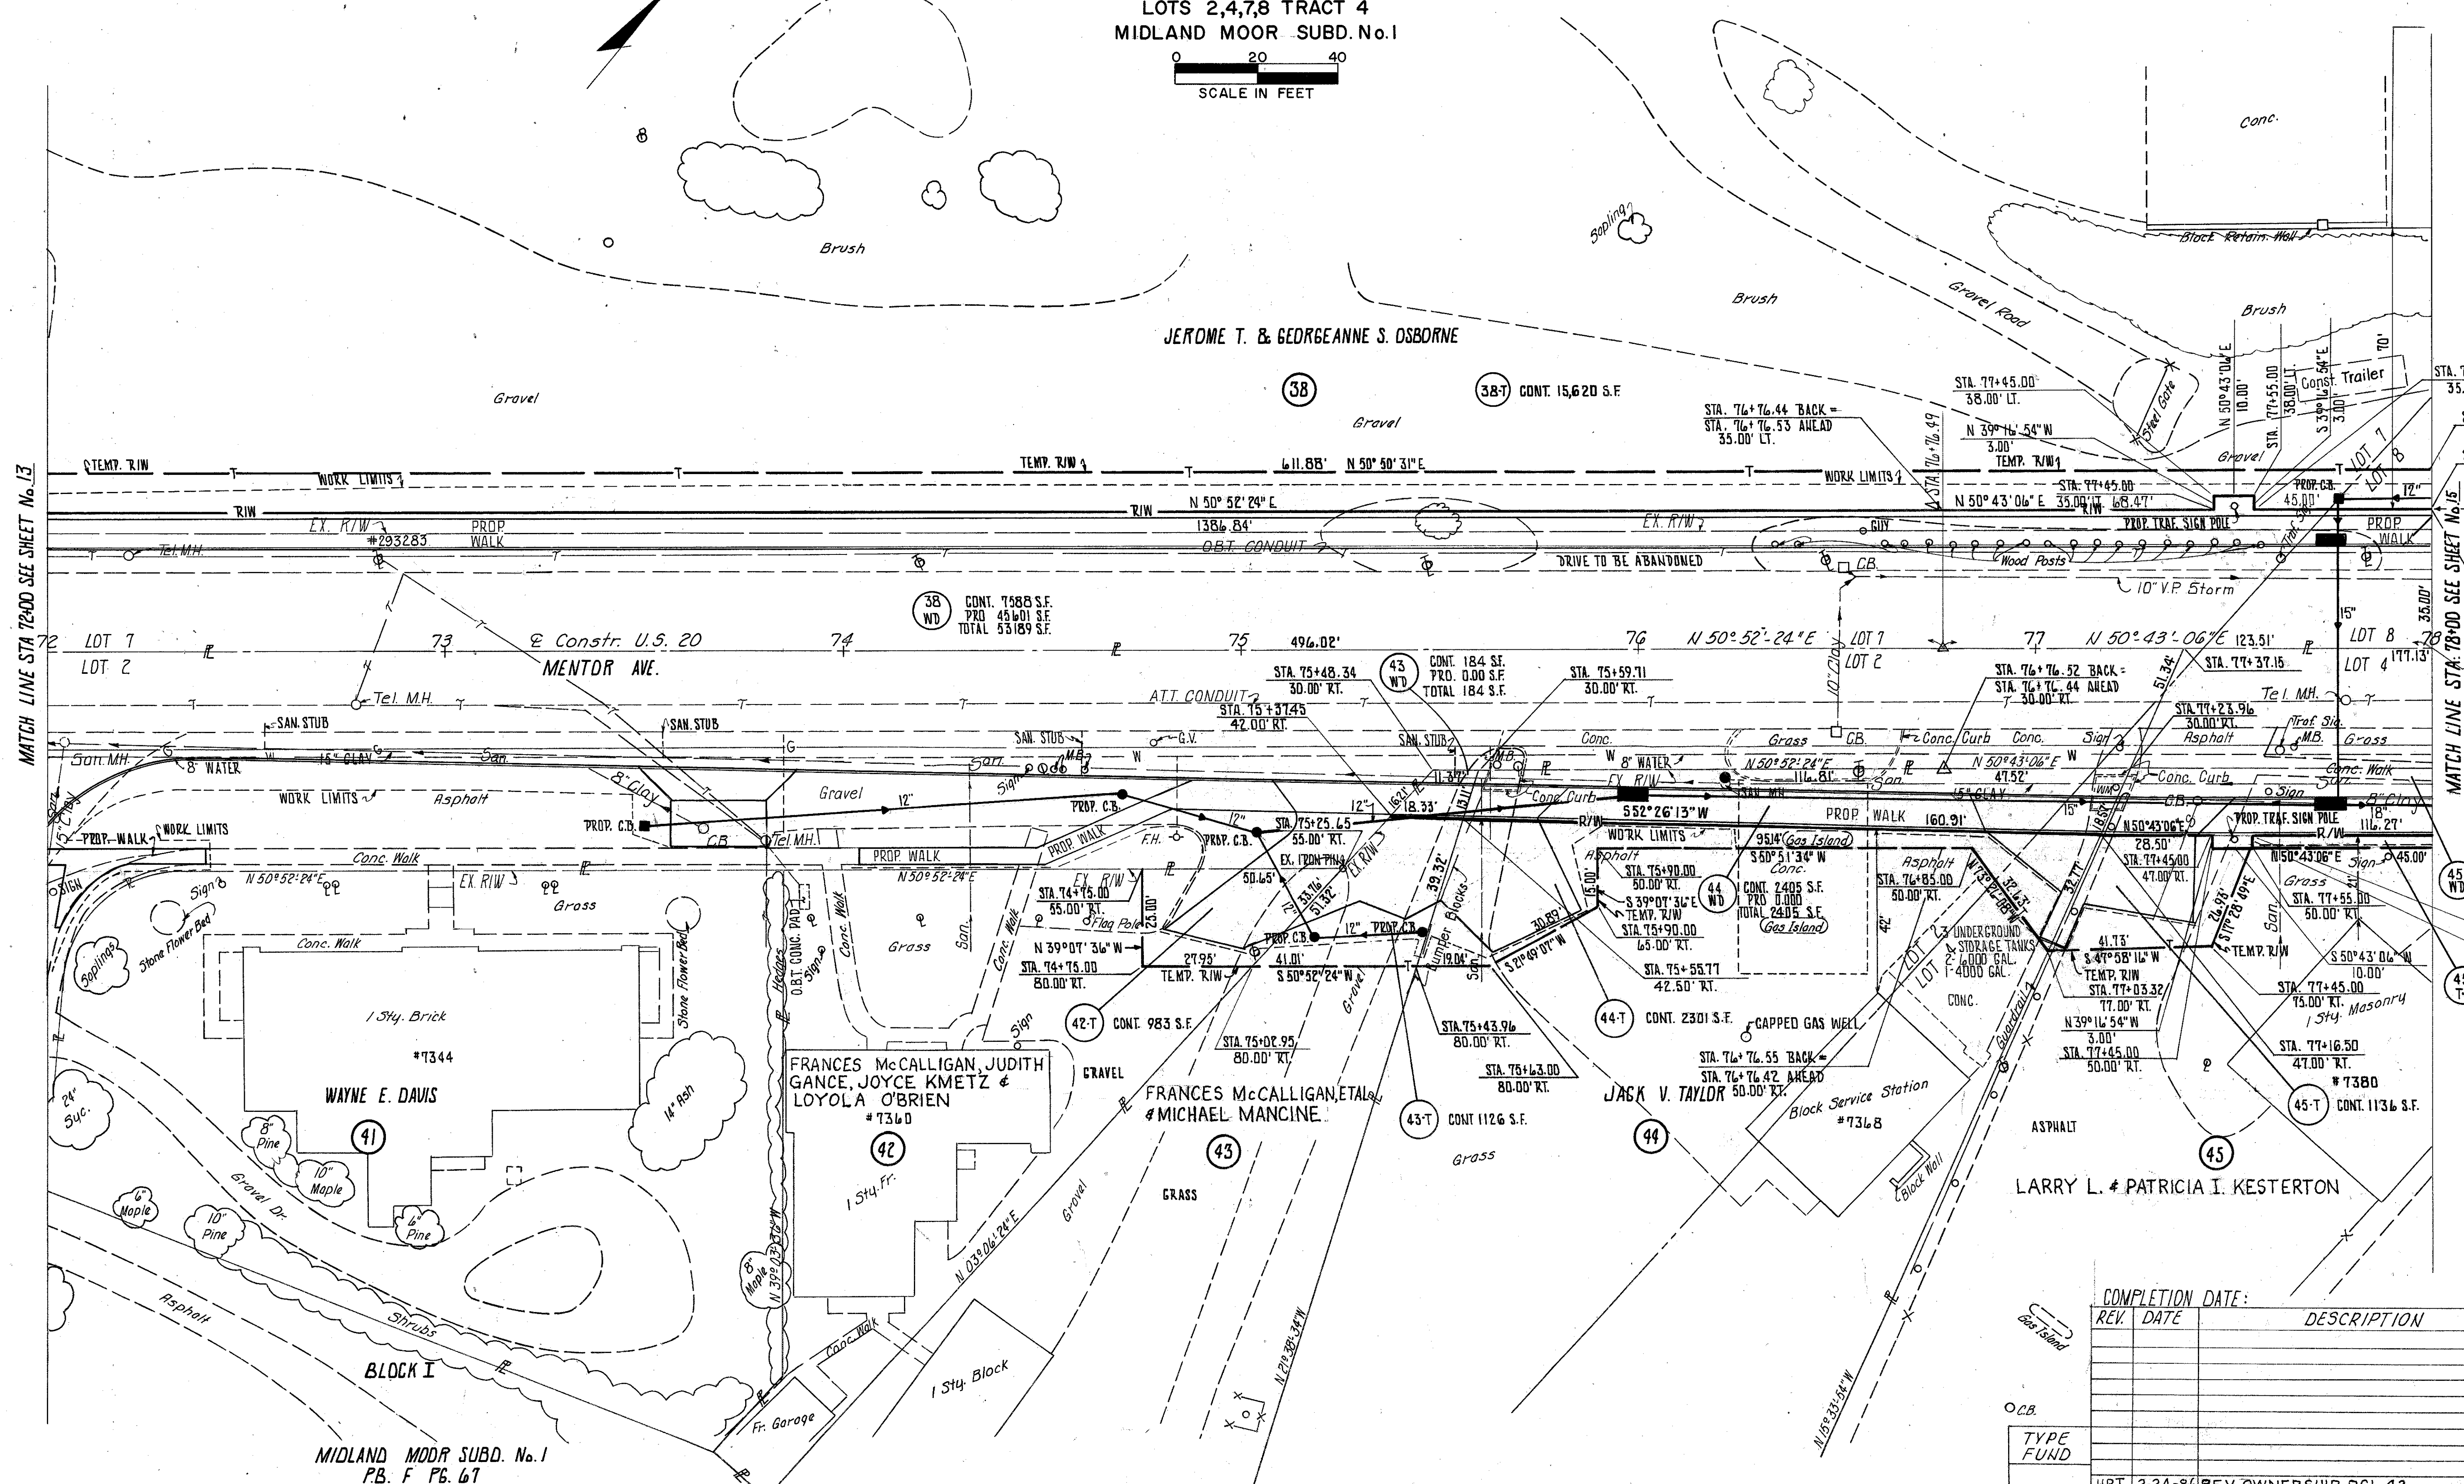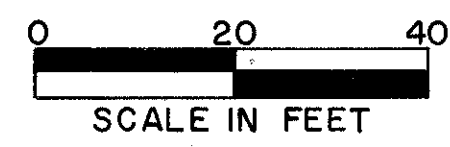

MATCH LINE STA 72+00 SEE SHEET No. 13

MATCH LINE STA 78+00 SEE SHEET No. 15

COMPLETION DATE:

REV	DATE	DESCRIPTION

TYPE	FUND
HRT	2-24-86 REV. OWNERSHIP PCL. 43
HRT	1-16-86 NAME CHANGE PCL. 42 & 45

MIDLAND MOOR SUBD. No. 1
P.B. F P.B. 67

MENTOR AVE. STA. 72+00 TO STA. 78+00 R/W