


FINAL SURVEY REPORT
NOTE BOOK REFERENCE
DATE OF SURVEY
BY
CHECKED BY
DATE OF CHECK

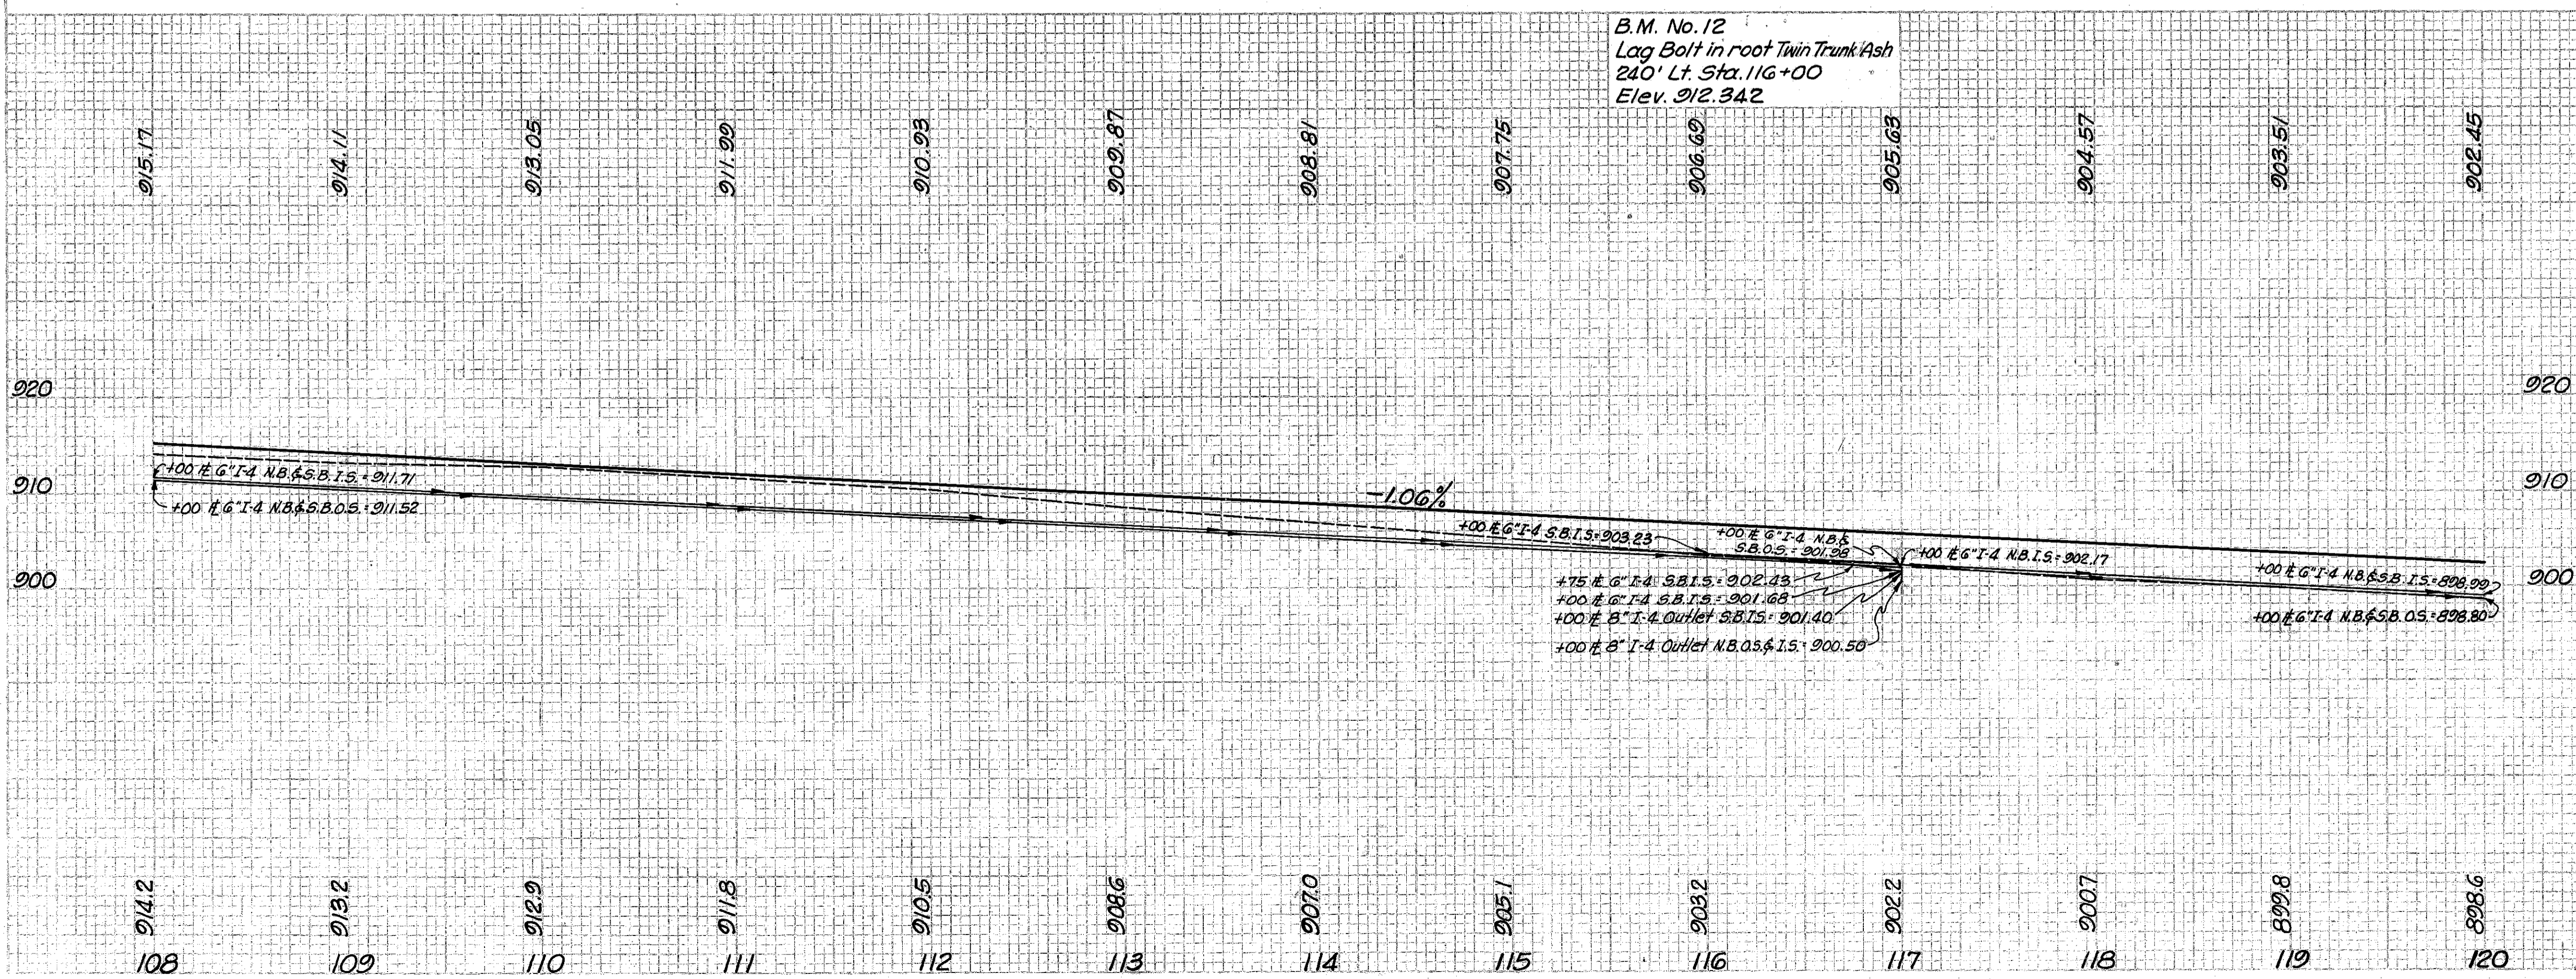

| See Sheet No. | Ref. No. | Station | Side & | I-2 | | I-4 | | I-5 | | I-5-29 | |
|---------------|----------|---------|--------|---------------------|------------|---------------------|------------|----------------------|------------------------|--------|--|
| | | | | Line 11 Storm Sewer | Underdrain | Line 11 Storm Sewer | Underdrain | Class 11 Storm Sewer | Drainage of Structures | | |
| 345 | 1-D | 108+00 | Lt. | 72" | 8" | 10' | 1 | 1 | 1 | 0.30 | |
| | | 108+100 | Lt. | | | 1700' | 1 | | | | |
| | | 117+04 | Lt. | | | 582' | | | | | |
| 345 | 2-0 | 108+00 | Rt. | | | 1876' | 2 | | | 0.60 | |
| | | 108+100 | Rt. | | | 592' | | | | | |
| | | 117+04 | Rt. | | | | | | | | |
| | | 108+100 | Lt. | | | | | | | 2213 | |
| | | 117+04 | Lt. | | | | | | | 356 | |
| | | 113+50 | Rt. | | | | | | | 711 | |
| | | 117+50 | Rt. | | | | | | | | |
| | | | | Totals | | 72 | | 3 | | 32.80 | |

MICHAEL BAKER, JR., CONSULTING ENGINEERS
ROCHESTER, PENNSYLVANIA

STATE OF OHIO
DEPARTMENT OF HIGHWAYS
STATE HIGHWAY NO. 1
C-41
PLAN AND PROFILE
STA. 108+00 TO STA. 120+00

| | | | | | |
|----------|-------|--------|---------|---------------|---------|
| Designed | Drawn | Traced | Checked | Reviewed Date | Revised |
| B.P. | B.P. | K.G. | L.I. | | |

PLAN & PROFILE STA. 108+00 TO STA. 120+00