


Seeding
End Width sq. yds.

| FED. RD. DIVISION | STATE | PROJECT |
|-------------------|-------|-------------|
| 2 | OHIO | I-1103 (18) |

318
458

CUYAHOGA & LAKE COUNTIES
CUY-I-15.91
LAK-I-0.00

| End Area | | Volume | |
|----------|------|--------|------|
| Cut | Fill | Cut | Fill |
| 0 | 1577 | | |
| 0 | 1747 | | |
| 0 | 905 | | |
| 0 | 2220 | | |
| 0 | 294 | | |
| 0 | 522 | | |
| 0 | 153 | | |
| 0 | 414 | | |

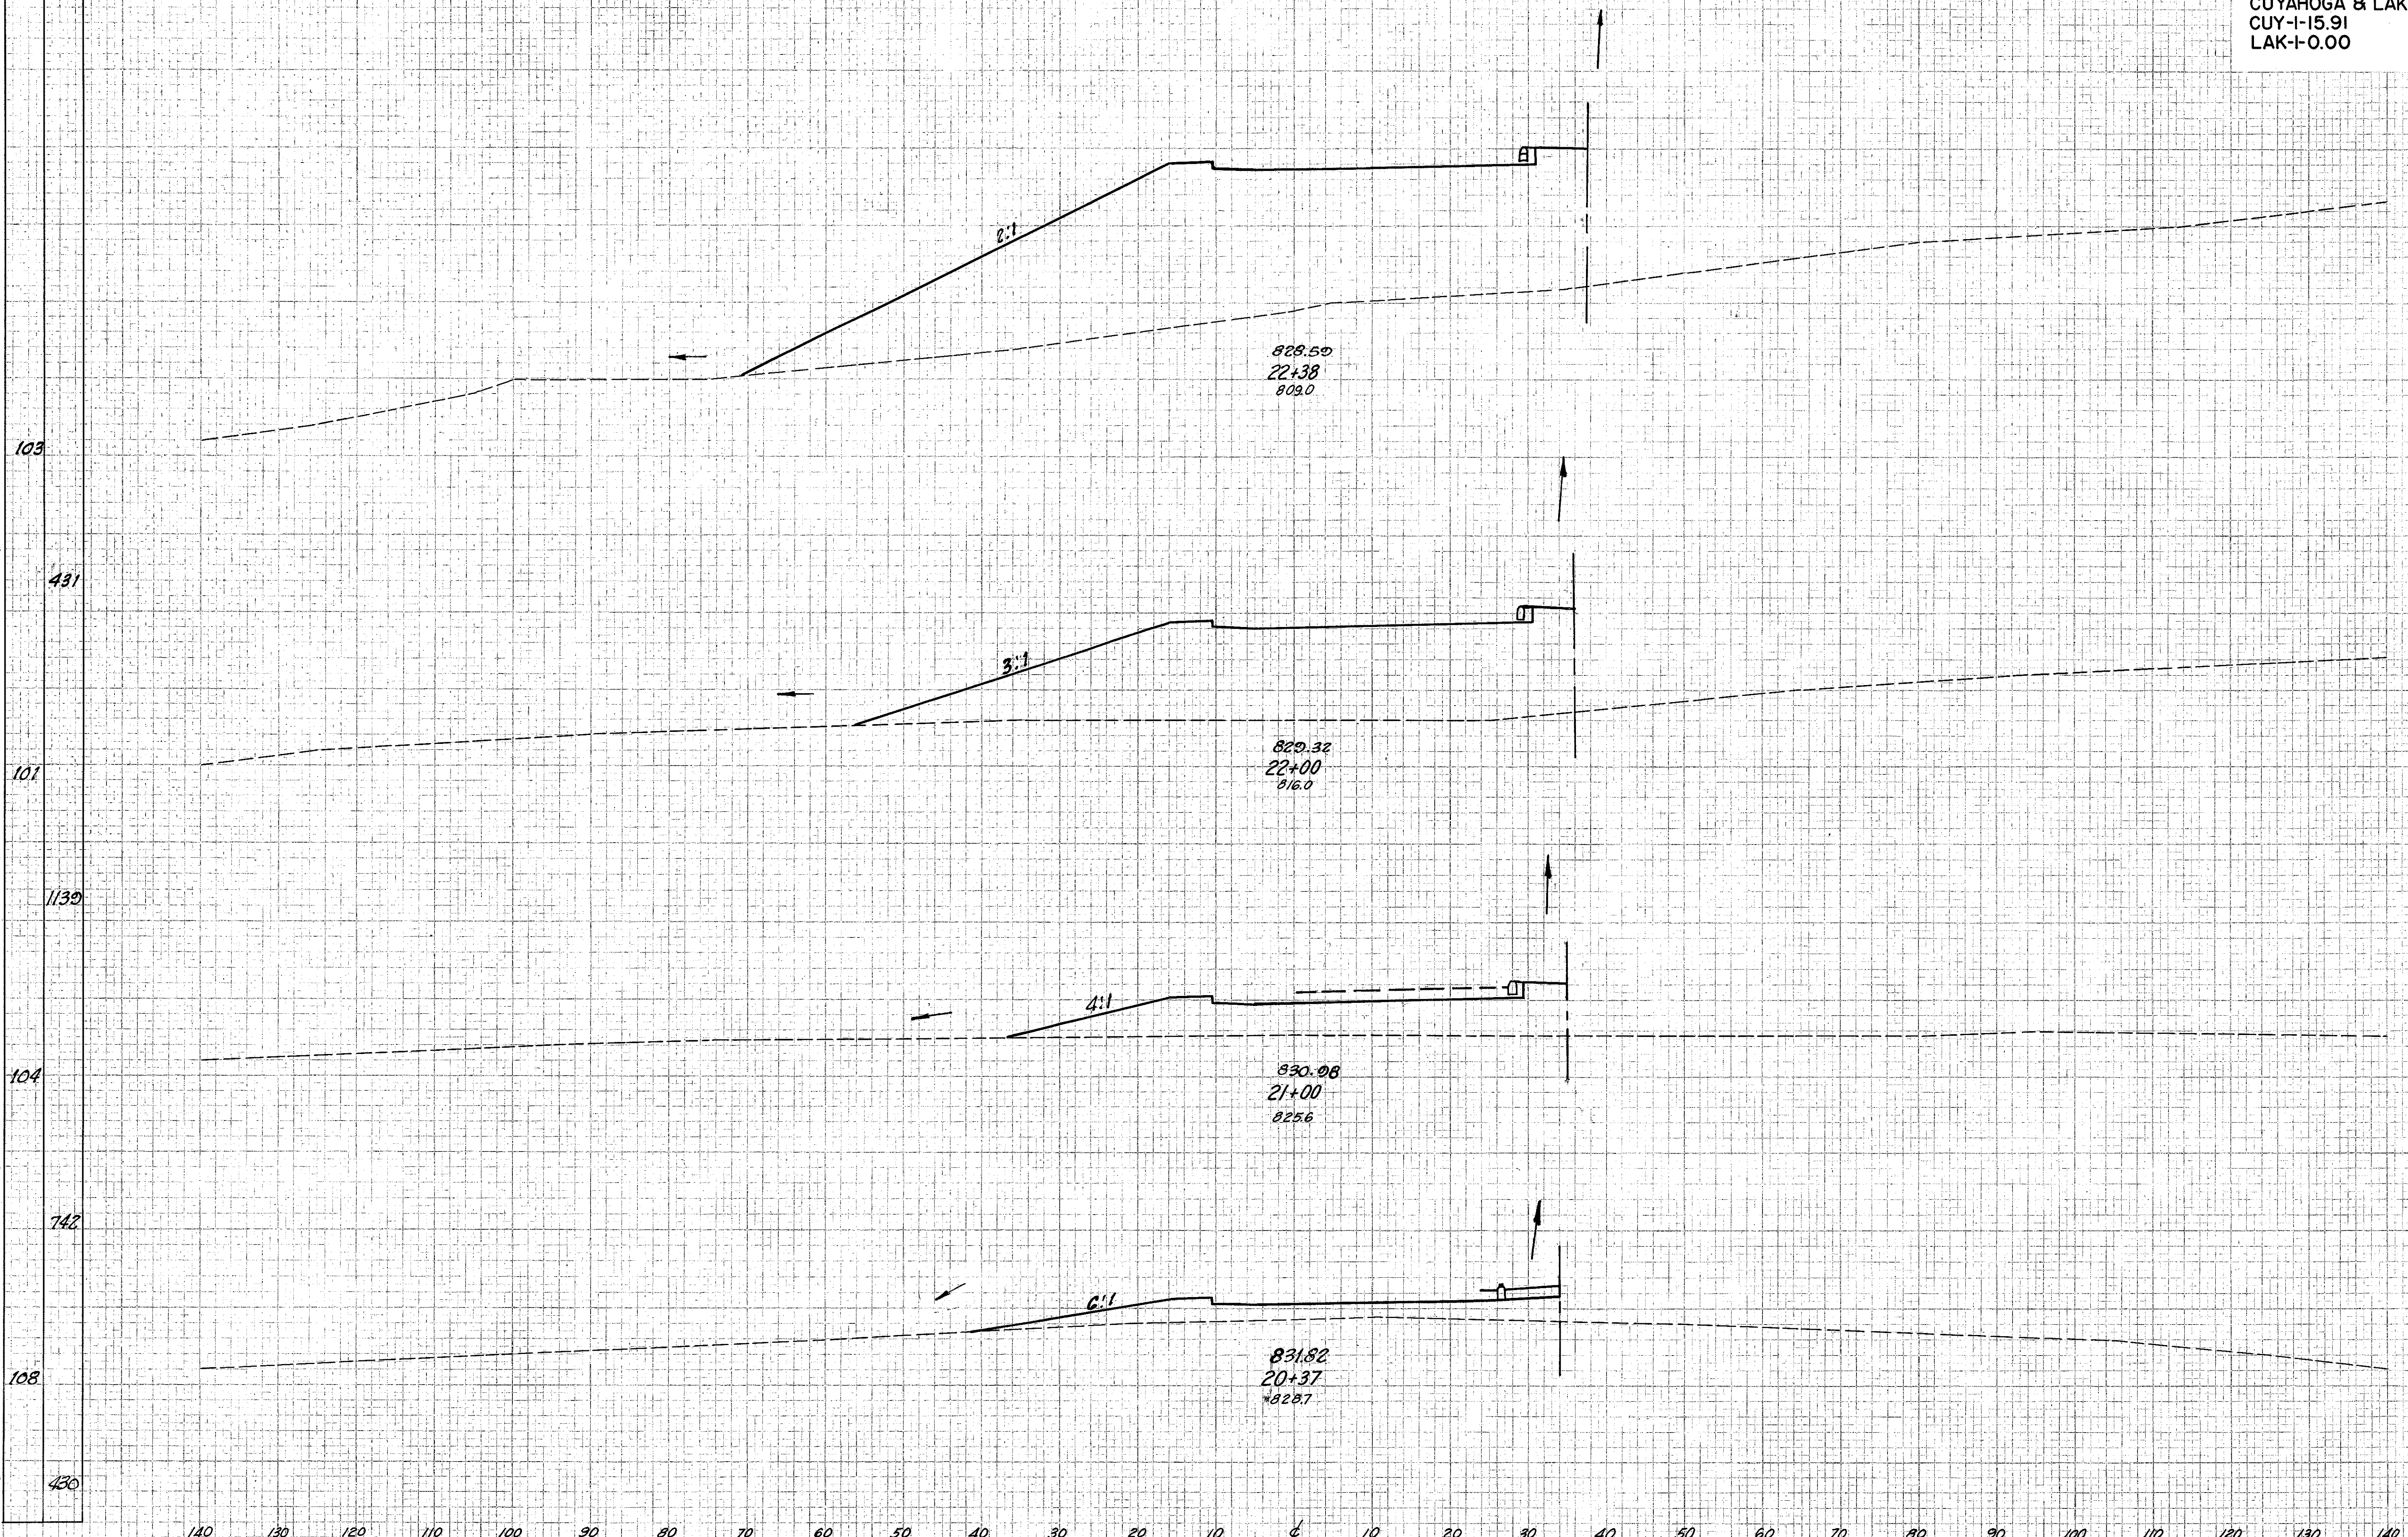

FINAL SURVEY
DATE: 11/10/03
BY: [illegible]

ORIGINAL SURVEY
DATE: 11/10/03
BY: [illegible]