


Seeding	End Sq. Width	Sq. Yds.
	140	1469
	130	145
	120	1033
	110	203
	100	2011
	90	321
	80	3089
	70	235

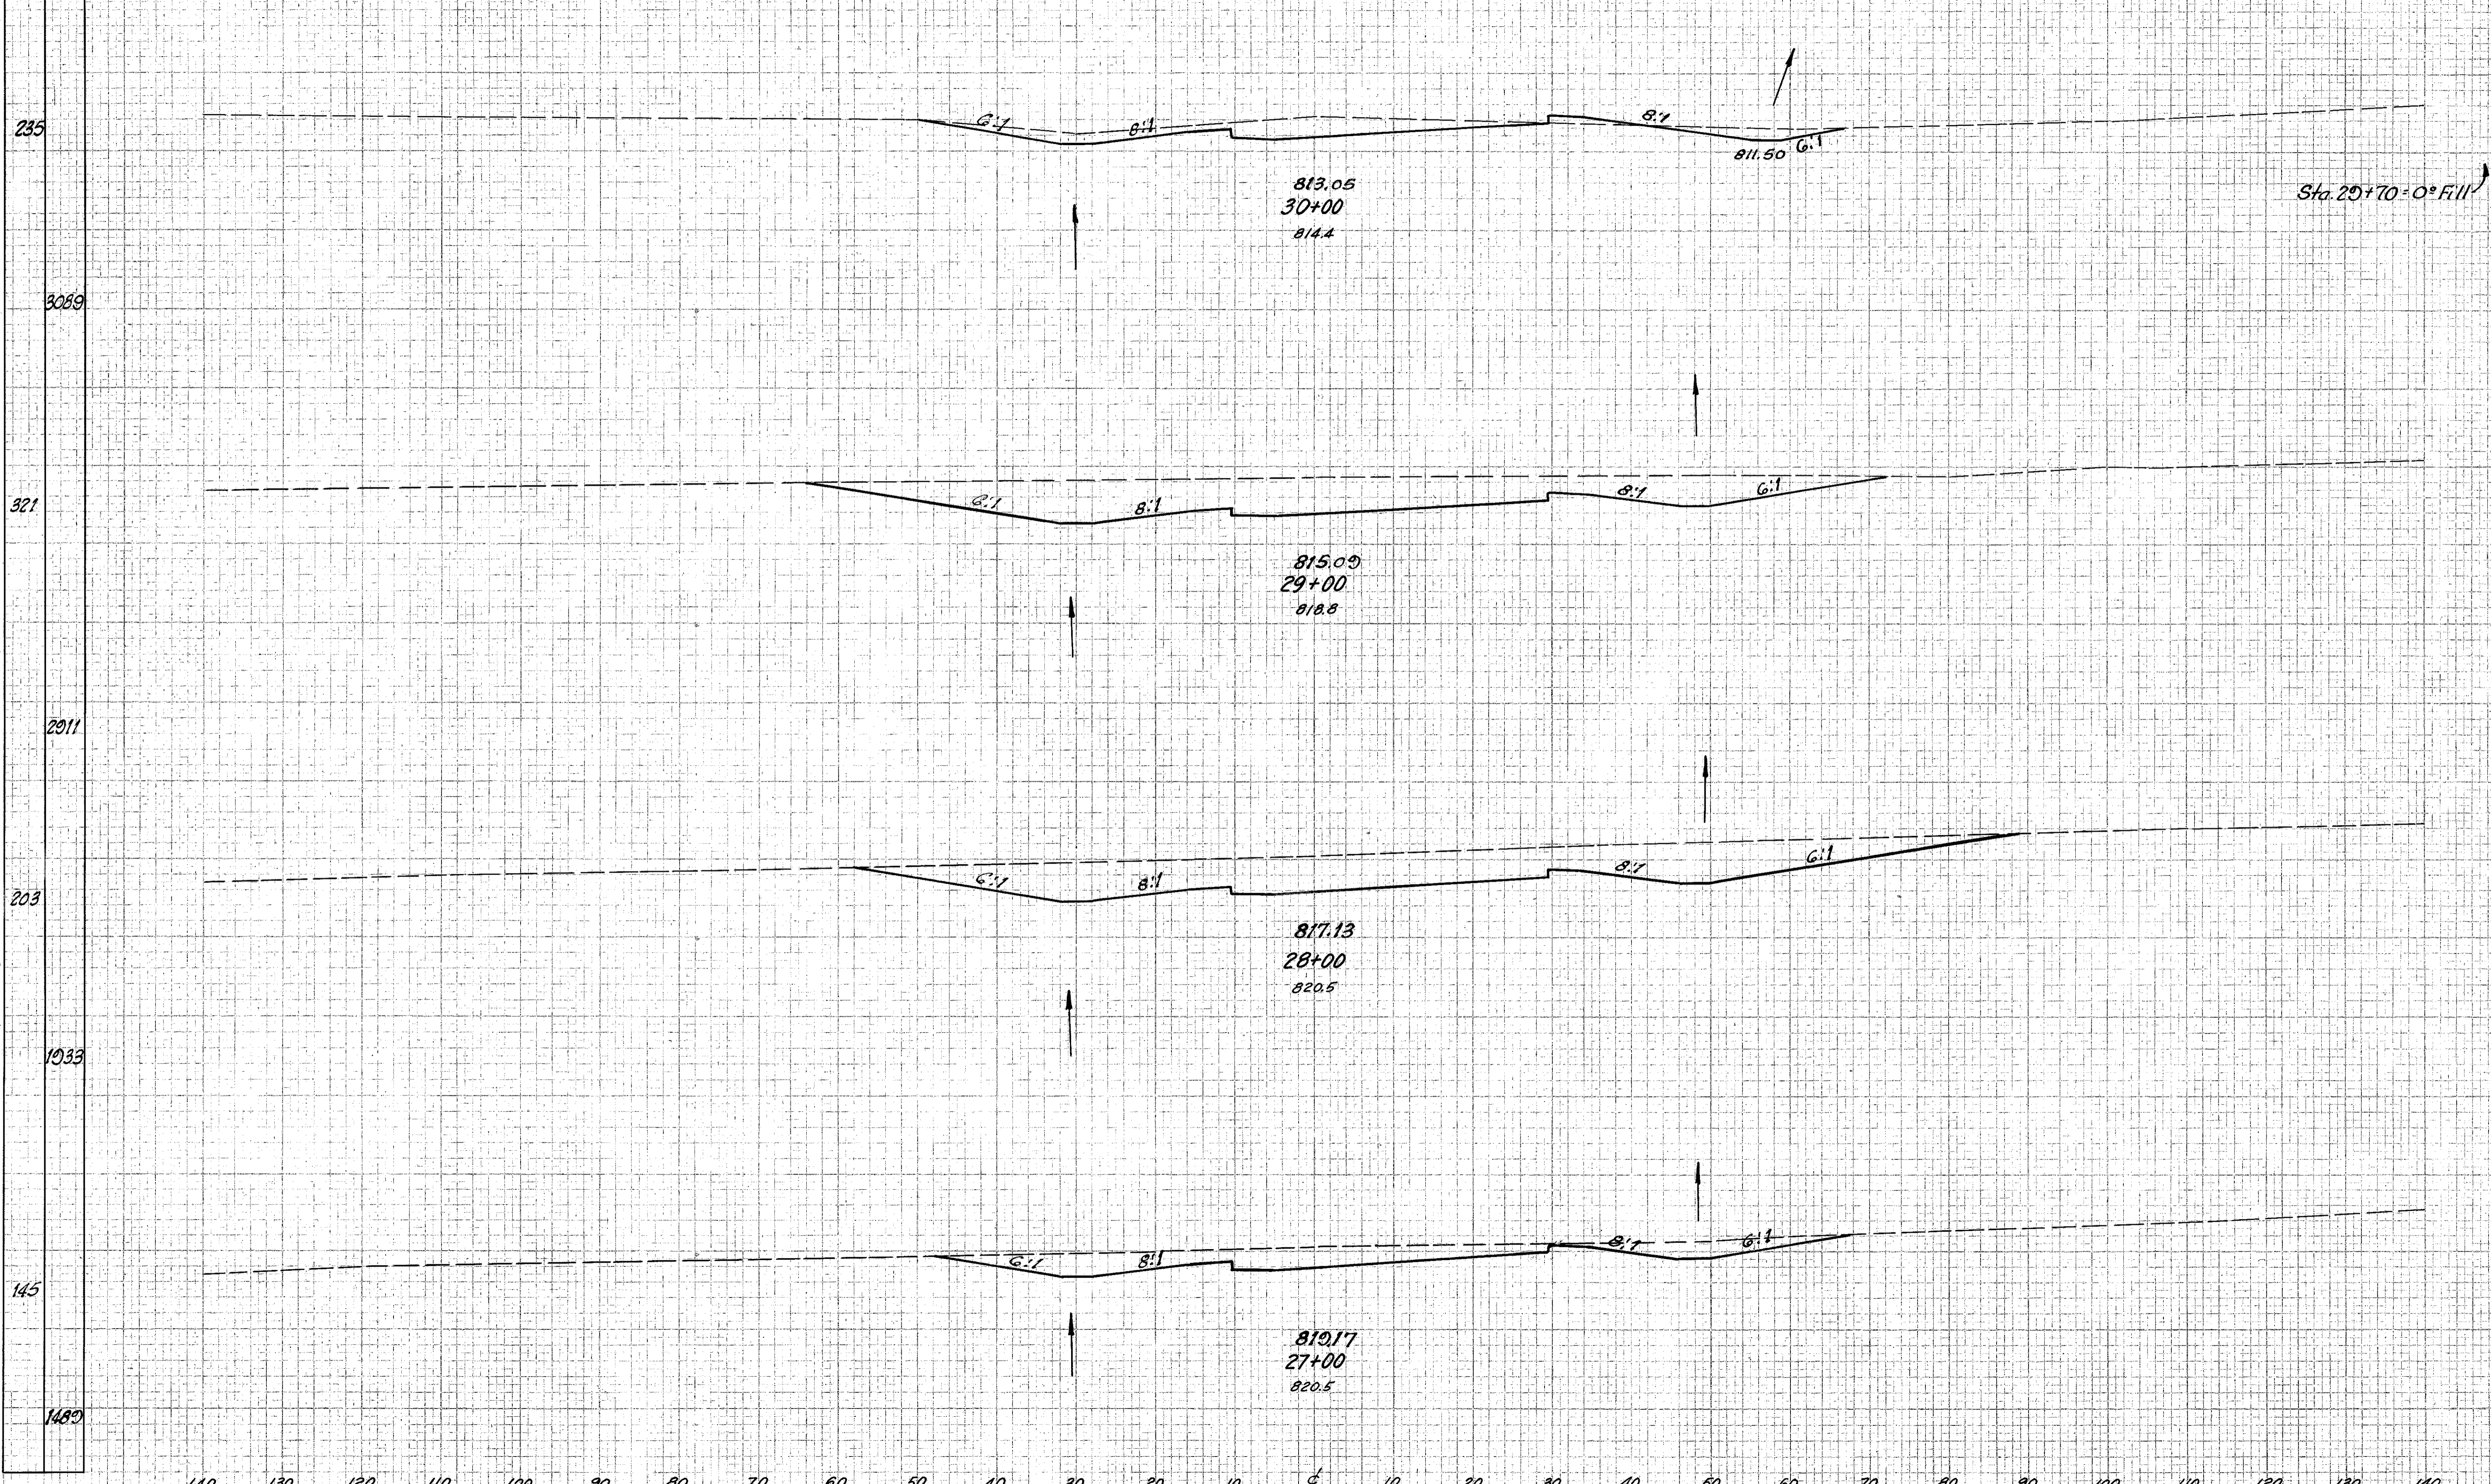

End Area		Volume	
Cut	Fill	Cut	Fill
104	6		
		1081	11
480	0		
		1854	0
521	0		
		1344	0
205	0		
		1206	0

FINAL SURVEY
 DATE: 10/20/00
 BY: [Signature]