





CUYAHOGA & LAKE COUNTIES
 CUY-1-15.91
 LAK-1-0.00

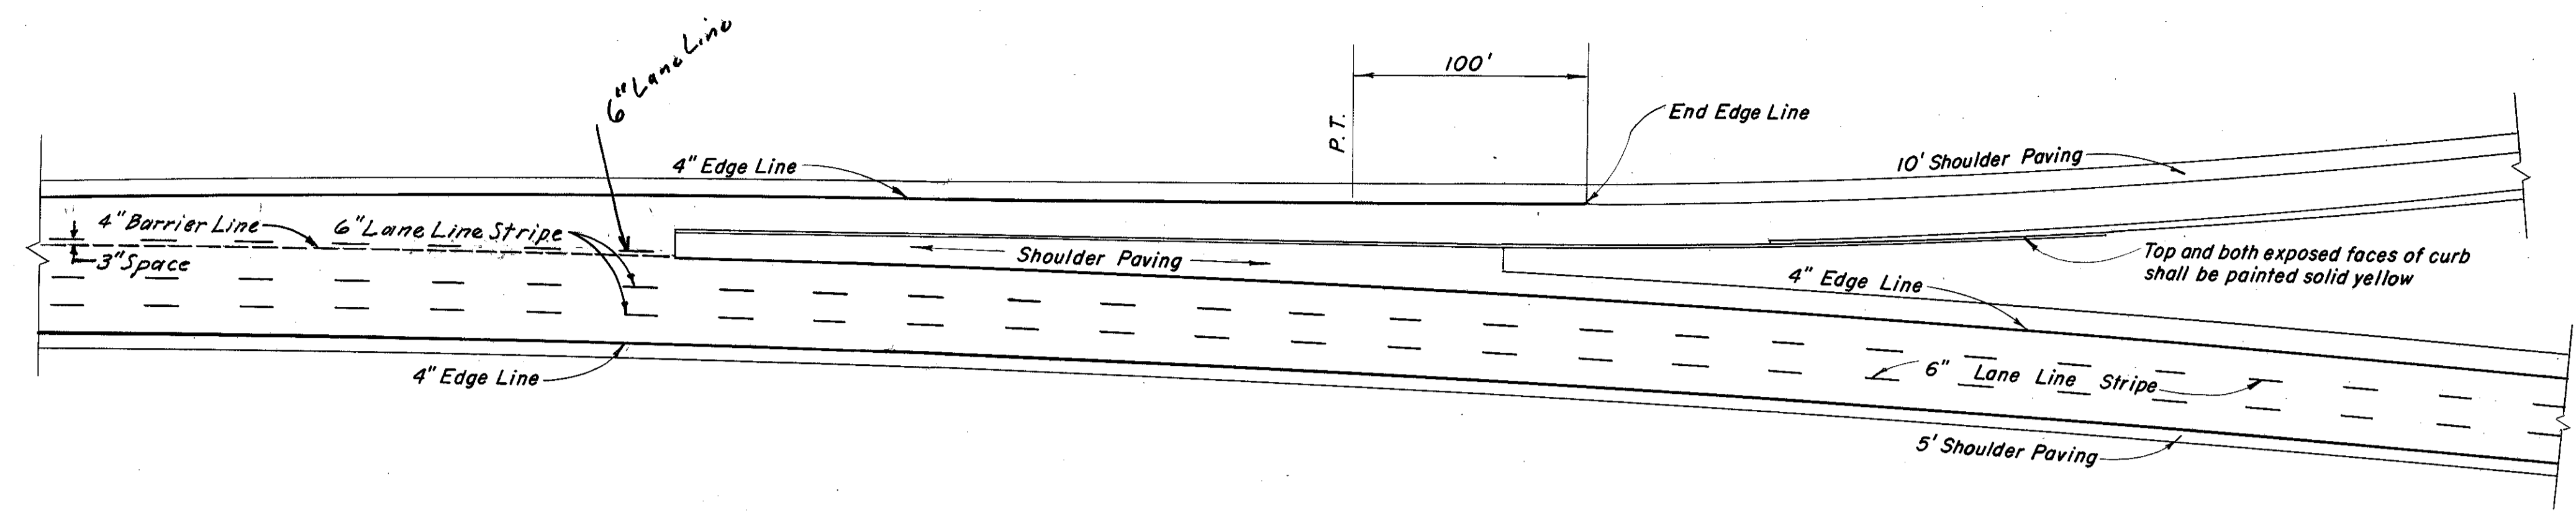

ENTRANCE TERMINAL

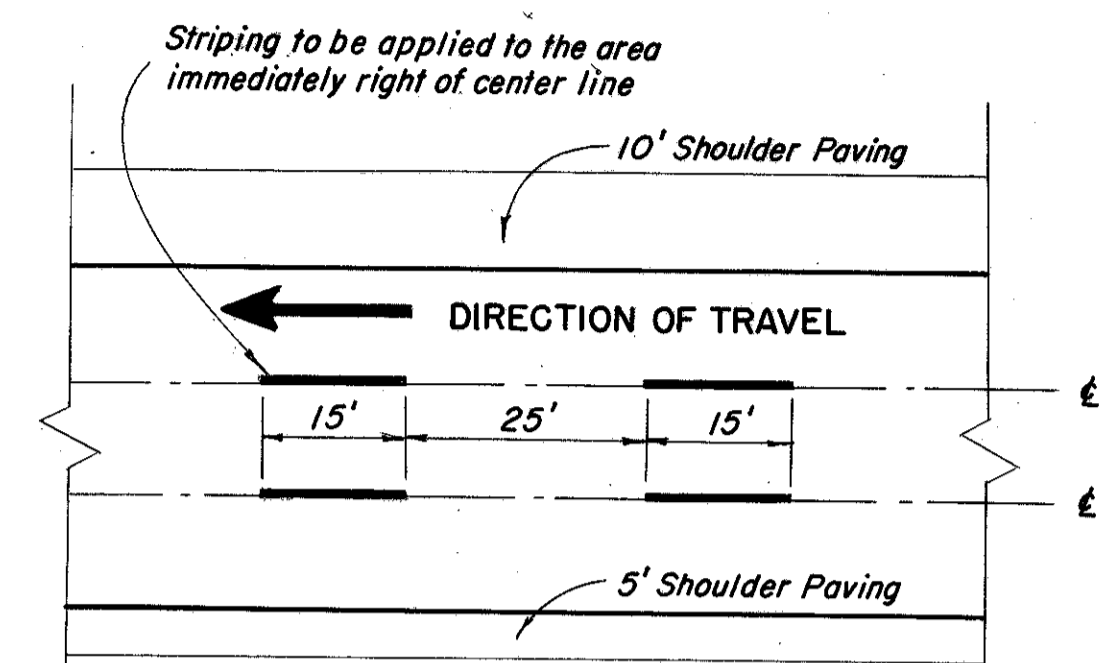

TYPICAL LANE LINE STRIPING

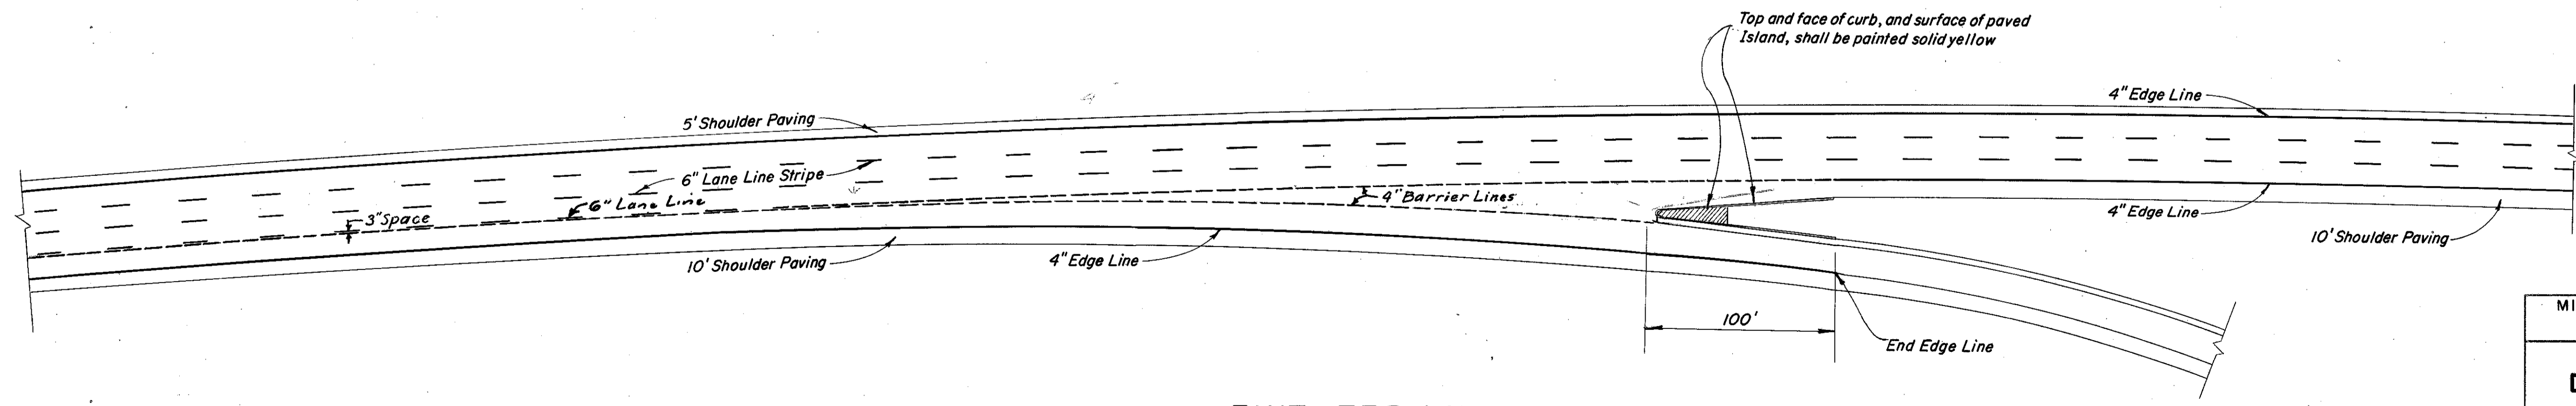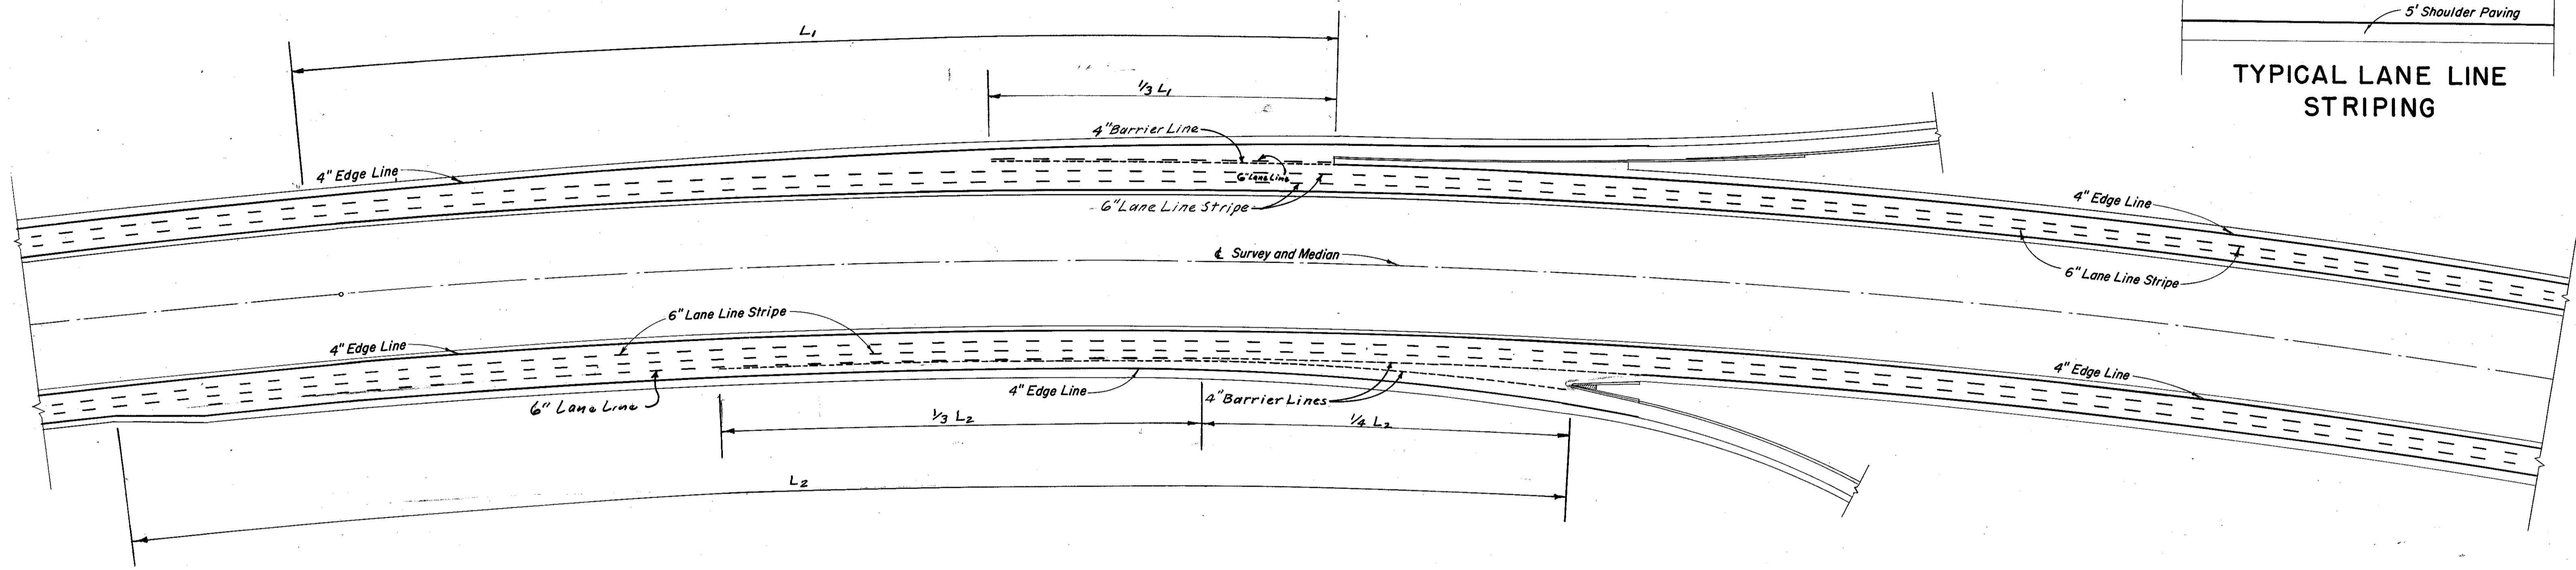

EXIT TERMINAL

MICHAEL BAKER JR., CONSULTING ENGINEERS
 ROCHESTER, PENNSYLVANIA
 STATE OF OHIO
 DEPARTMENT OF HIGHWAYS
 STATE HIGHWAY NO. 1
 C-41
 PAVEMENT MARKING DETAIL

Designed	Drawn	Traced	Checked	Reviewed Date	Revised
R.B.	A.L.H.	E.P.C.	B.P.		