


MAYFIELD TWP.
O.L. 34 TRACT 1
T-8-N R-10-W



FED. RD. DIVISION	STATE	PROJECT	437 458
2	OHIO	ACI-271-6(5)260	

CUYAHOGA & LAKE COUNTIES
CUY-1-15.91
LAK-1-0.00
LIMITED ACCESS

R/W
8 of 29

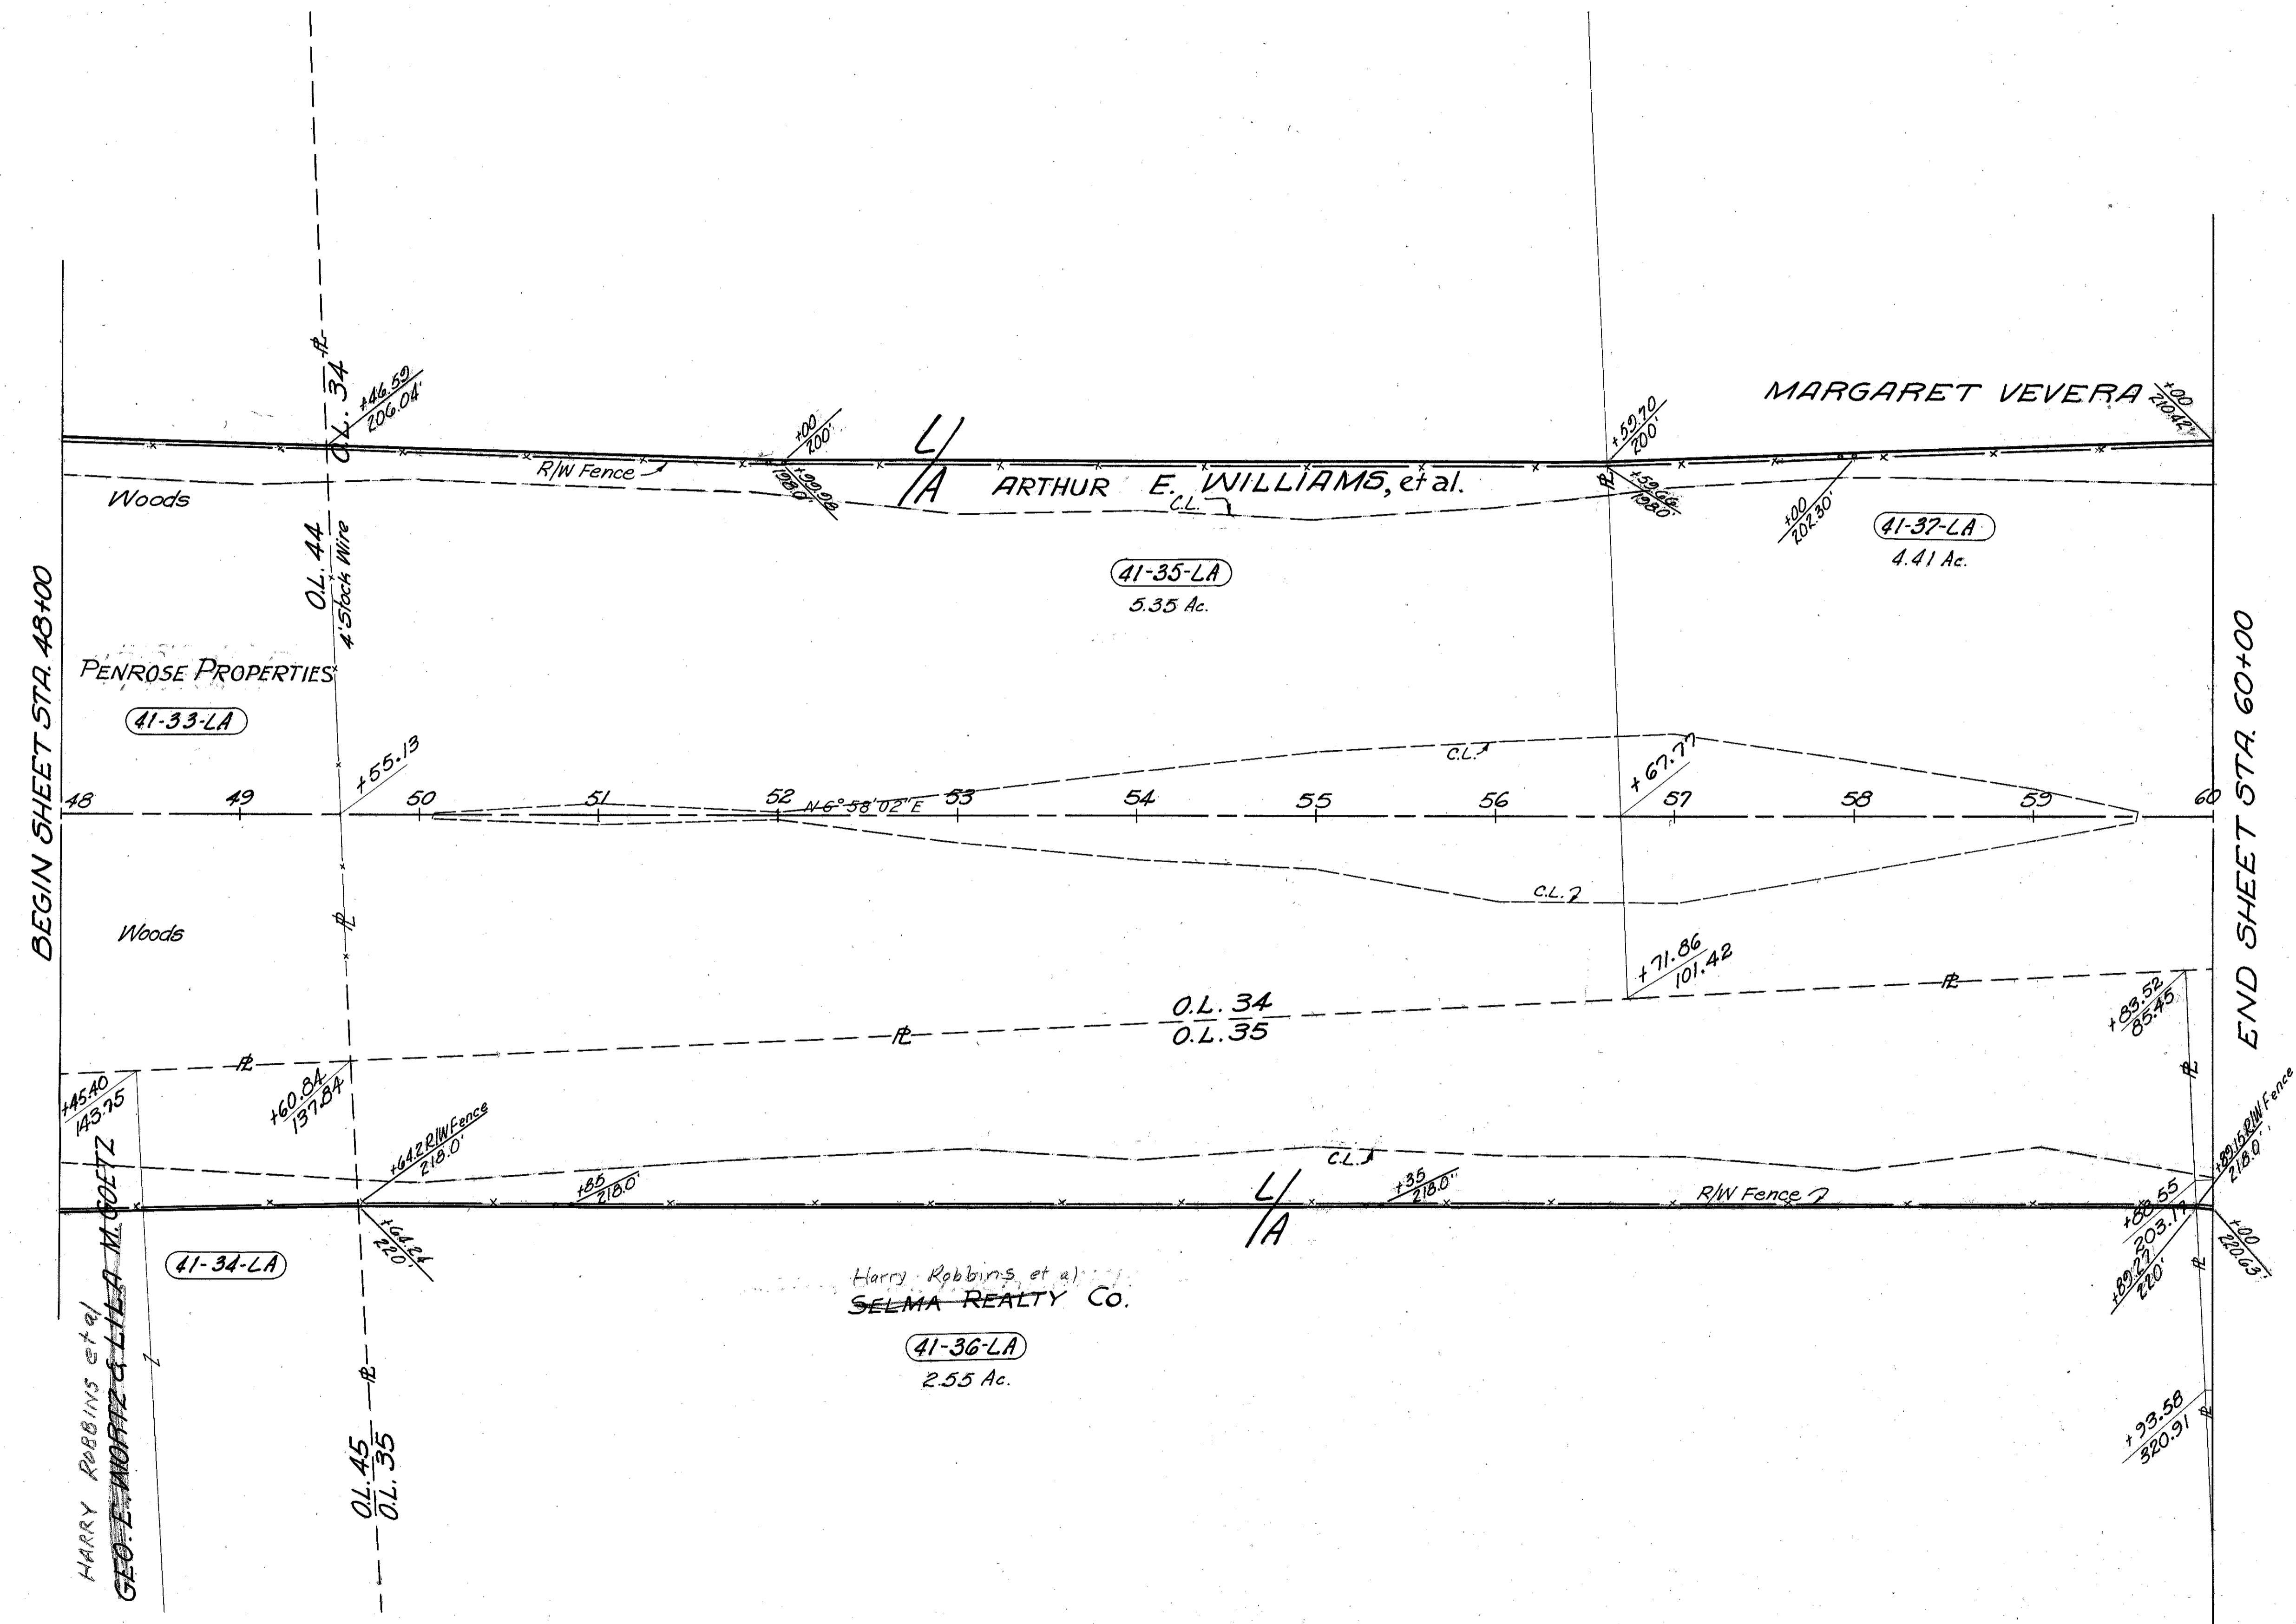

NO STRUCTURES TO BE REMOVED.

2396 L.F. TYPE "D" FENCE
Scale: 1" = 50'

MICHAEL BAKER JR., CONSULTING ENGINEERS ROCHESTER, PENNSYLVANIA					
DATE: 7-29-59 9-16-60					
STATE OF OHIO DEPARTMENT OF HIGHWAYS RIGHT OF WAY PLANS STATE HIGHWAY NO. 1 C-41 STA. 48+00 TO STA. 60+00					
Designed	Drawn	Traced	Checked	Reviewed Date	Revised
J.P.	AL.H.	K.L.G.	B.P.		