


CUYAHOGA & LAKE COUNTIES
 CUY-1-15.91
 LAK-1- 0.00
 LIMITED ACCESS

R/W
 15 of 29

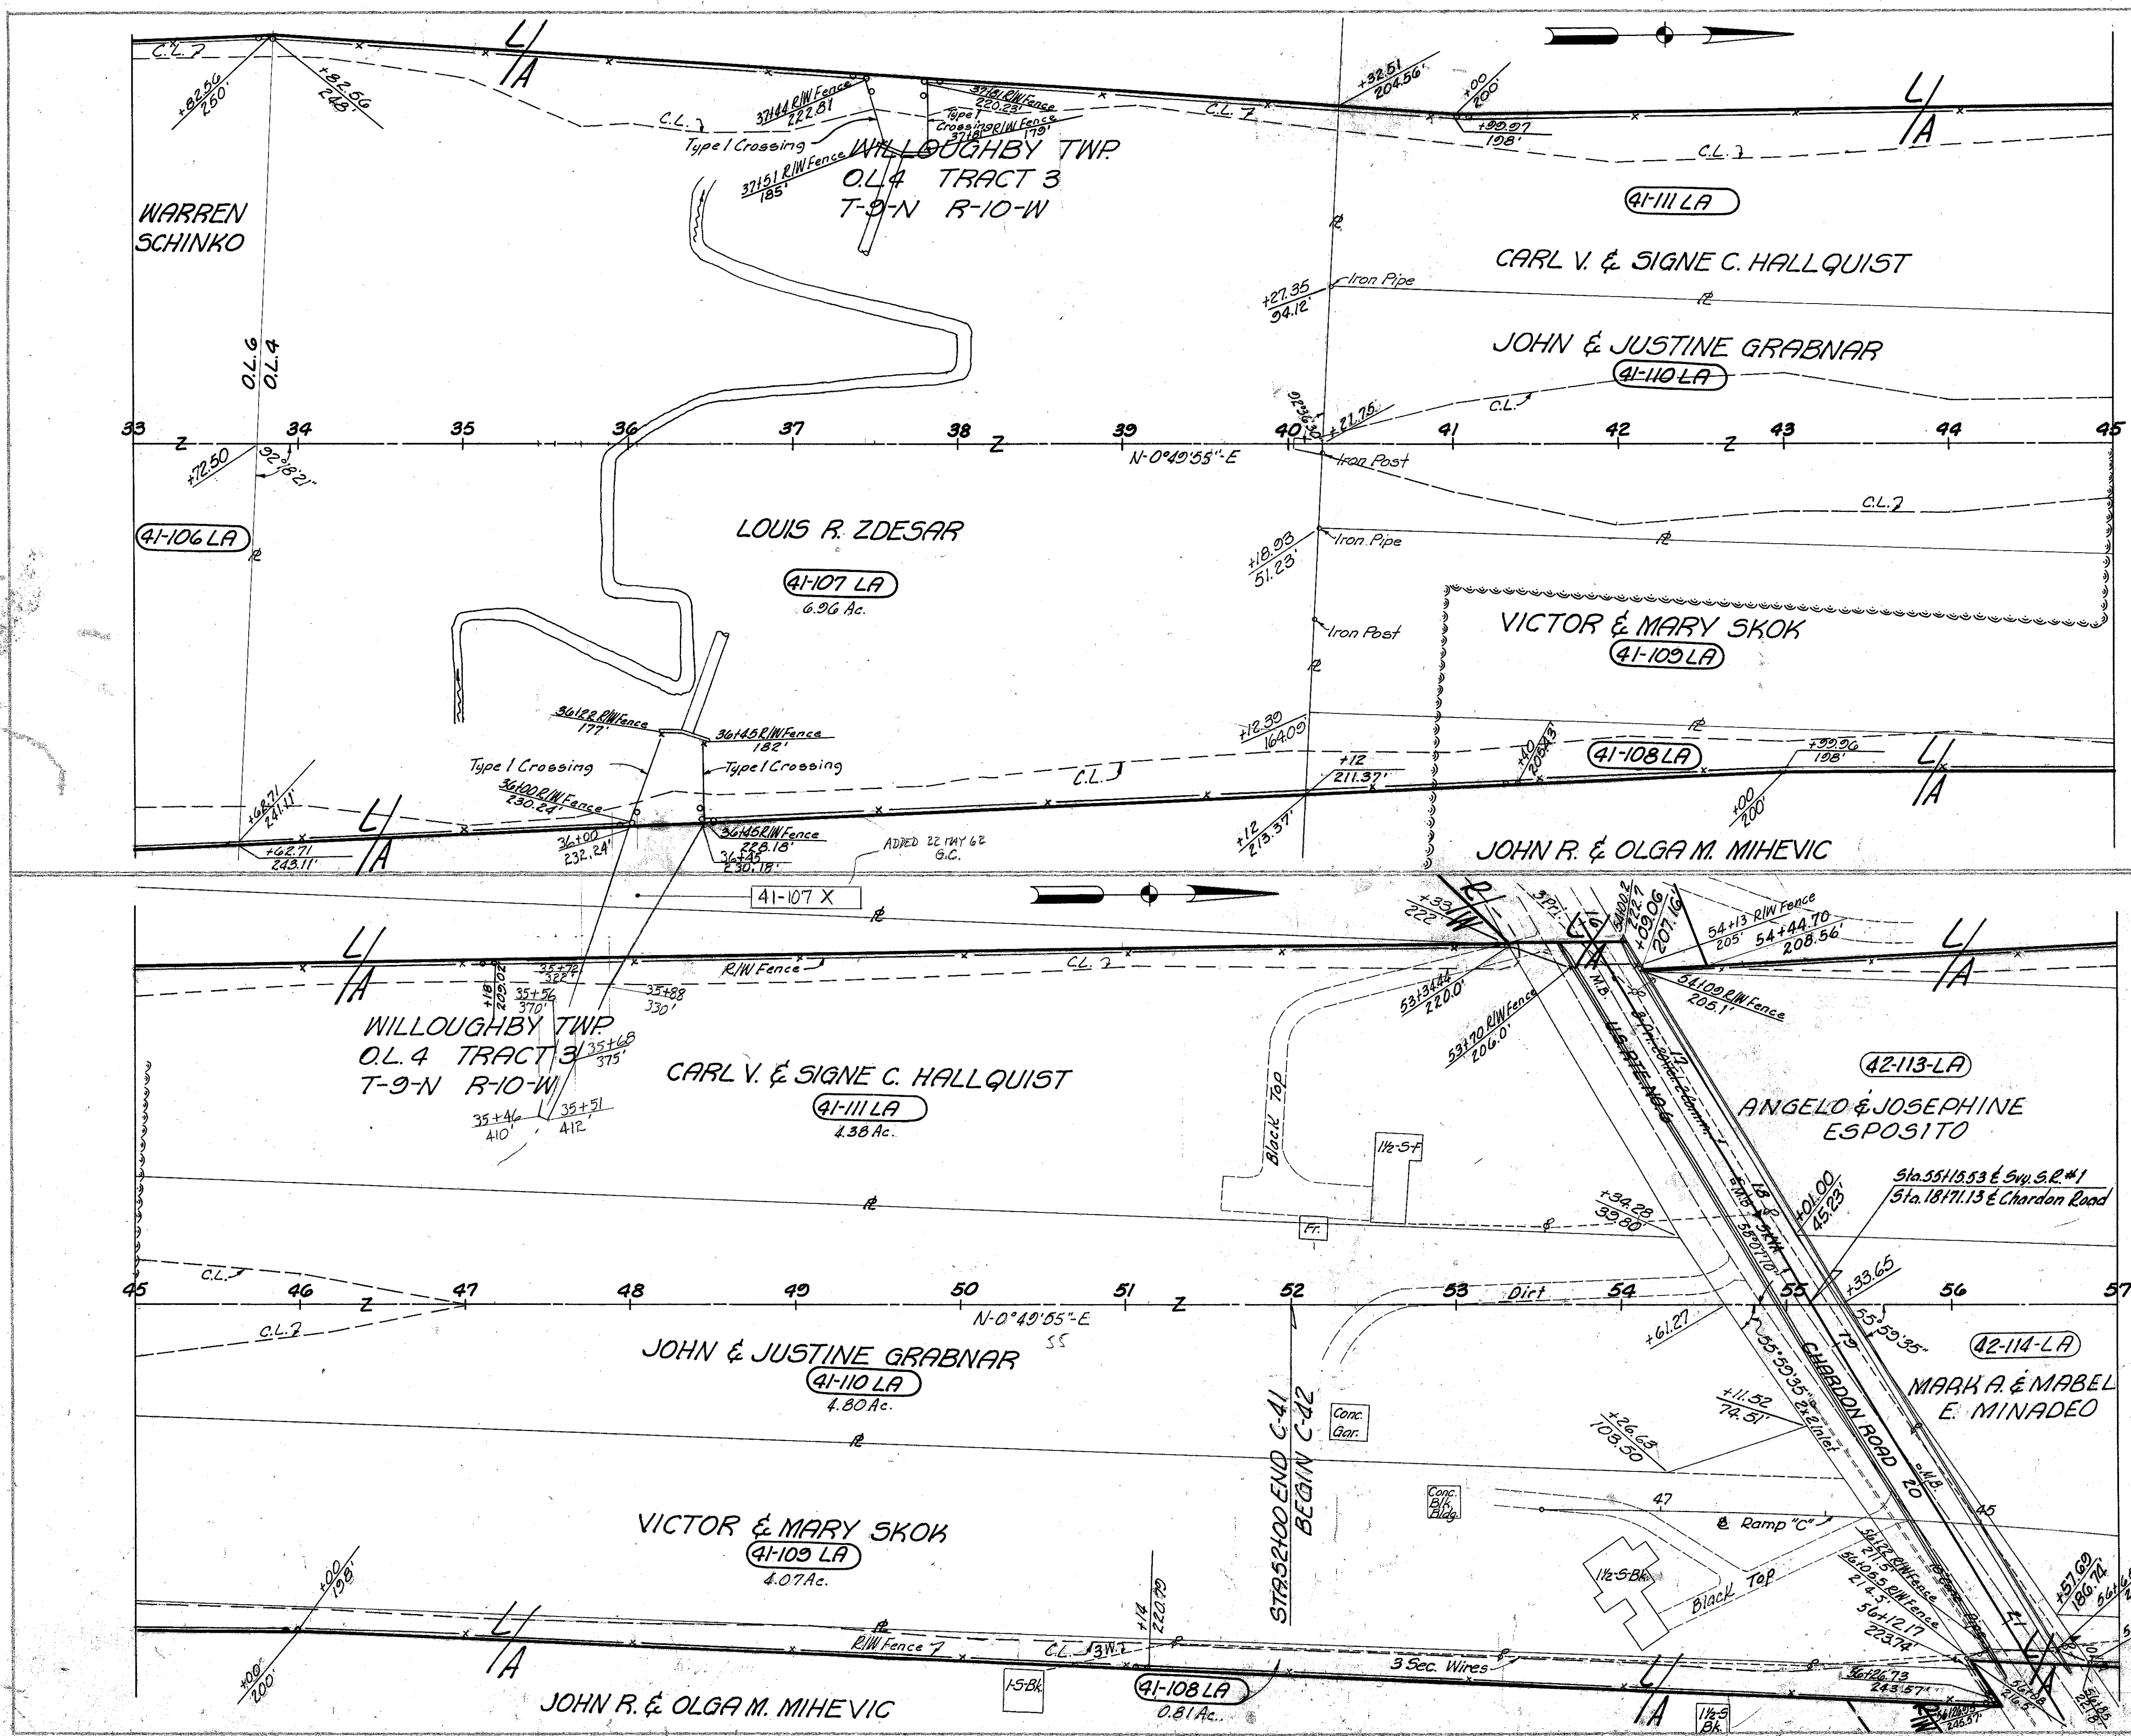

- STRUCTURES TO BE REMOVED**
- PARCEL NO. 41-111LA
1-1 1/2 STORY FRAME RESIDENCE
1-FRAME SHED
 - PARCEL NO. 41-110-LA
1- CONCRETE GARAGE
 - PARCEL NO. 41-109-LA
1-1 1/2 STORY BRICK RESIDENCE
1- CONCRETE BLOCK BUILDING

SEC. C-41, ACI-271-6(5)260 = 3919 L.F. TYPE "D" FENCE
 SEC. C-42, ACI-90-1(20)18 = 942 L.F. TYPE "D" FENCE
 Scale: 1" = 50'

MICHAEL BAKER JR., CONSULTING ENGINEERS ROCHESTER, PENNSYLVANIA					
STATE OF OHIO DEPARTMENT OF HIGHWAYS RIGHT OF WAY PLANS STATE HIGHWAY NO. 1 C-41 STA. 33+00 TO STA. 57+00					
DATE: 7-29-59 Revised: 10-19-59 9-16-60	Designed J.P.	Drawn A.L.H.	Traced K.L.G.	Checked B.P.	Reviewed, Date