

NOTE: SEE EXTRA AREA SHEET NOS 14 AND 16 FOR ADDITIONAL INTERSECTION DETAILS & QUANTITIES.



NOTE: FOR DRIVEWAY DETAILS & QUANTITIES, SEE SHEET NO 21

NOTE: FOR SUMMARY OF QUANTITIES, ITEM 659 SEEDING & MULCHING, ITEM 202 SIDEWALK REMOVED & DISPOSED OF, ITEM 604 MON. ADJ. TO GRADE, ITEM 608 4" CONCRETE SIDEWALK AND 100% CITY OF PAINESVILLE PARTICIPATION IN ITEMS 604, ITEMS 202 & ITEMS 608, SEE SHEET NO 7.

669.38
667.55
664.73
662.73
661.26
660.14
659.39
658.66
658.10
657.31
656.71

PAVEMENT								
Ref No	Station		Side R or L	ITEM 202	ITEM 305	ITEM A02	ITEM A07	ITEM 310
	FROM	TO		REMOVAL & DISPOSAL OF EXISTING PAVEMENT	9" PORTLAND CEMENT CONCRETE BASE COURSE	2 1/2" ASPHALTIC CONCRETE	BITUMINOUS TACK COAT @ 0.10 Gals. per SQ. YD.	
				SQ. YDS.	SQ. YDS.	CU. YDS.	GALS.	CU. YDS.
I-P	13+60	13+87	L & R	29	29	2	3	4.8
TOTAL				29	29	* 2	3	4.8

* TO BE LAID IN (2) - 1/4" COURSES.

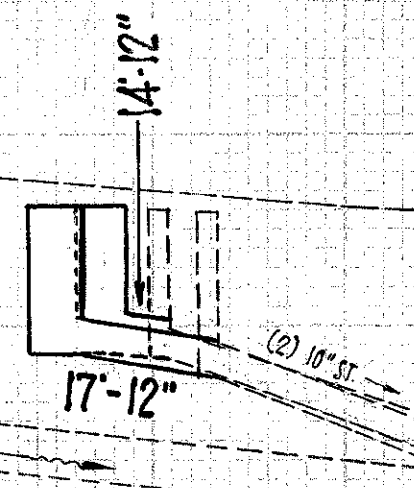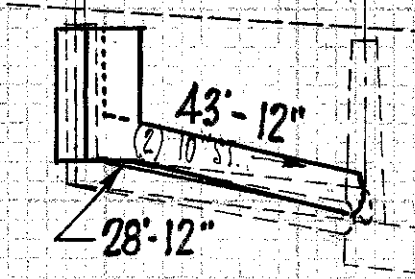

STORM SEWERS										
Ref. No	Station	Side R or L	ITEM 603		ITEM 604		ITEM 202		TOTAL	
			Type	Length	Type	Length	Item	Quantity		
I-S	13+57	L-R	43	43	STORM M.H. ADJUSTED TO GRADE	1	C.B. AND/OR INLET REMOVED	4	4	
2-S	13+58	R	28	28	ST. NO. 3 C.B. MODIFIED	1	ADJUSTED TO GRADE	1	1	
3-S	14+70	L-R	17	17	ST. NO. 3 C.B. MODIFIED	1	ADJUSTED TO GRADE	1	1	
4-S	14+70	R	14	14	ST. NO. 3 C.B. MODIFIED	1	ADJUSTED TO GRADE	1	1	
TOTAL									102	4