
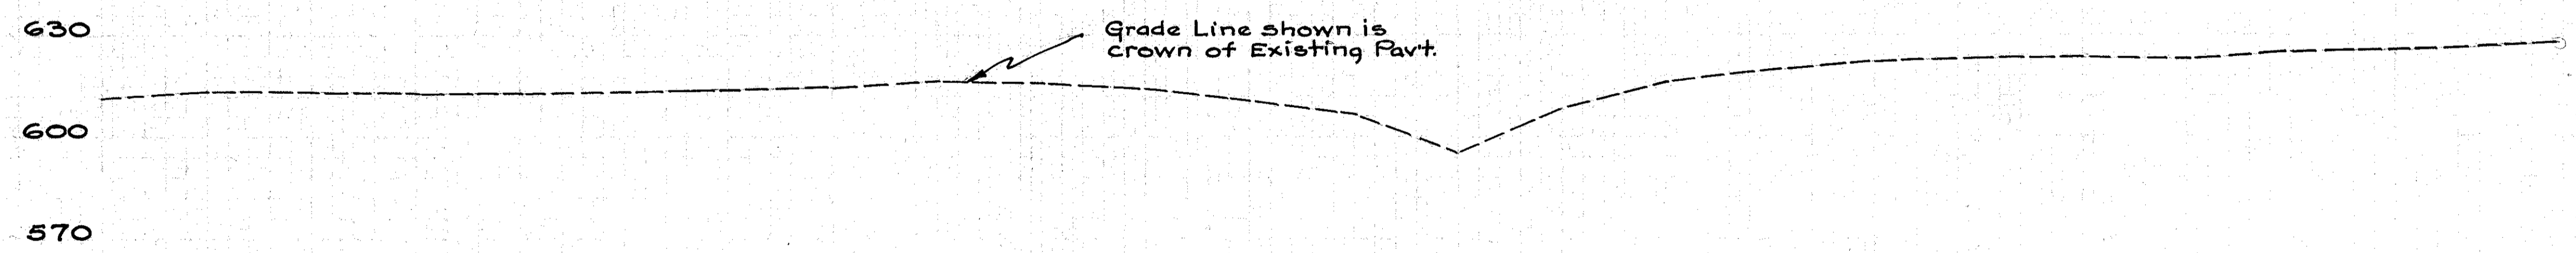


BEGIN SHEET STA. 76+00

N 46° 08' 40" W

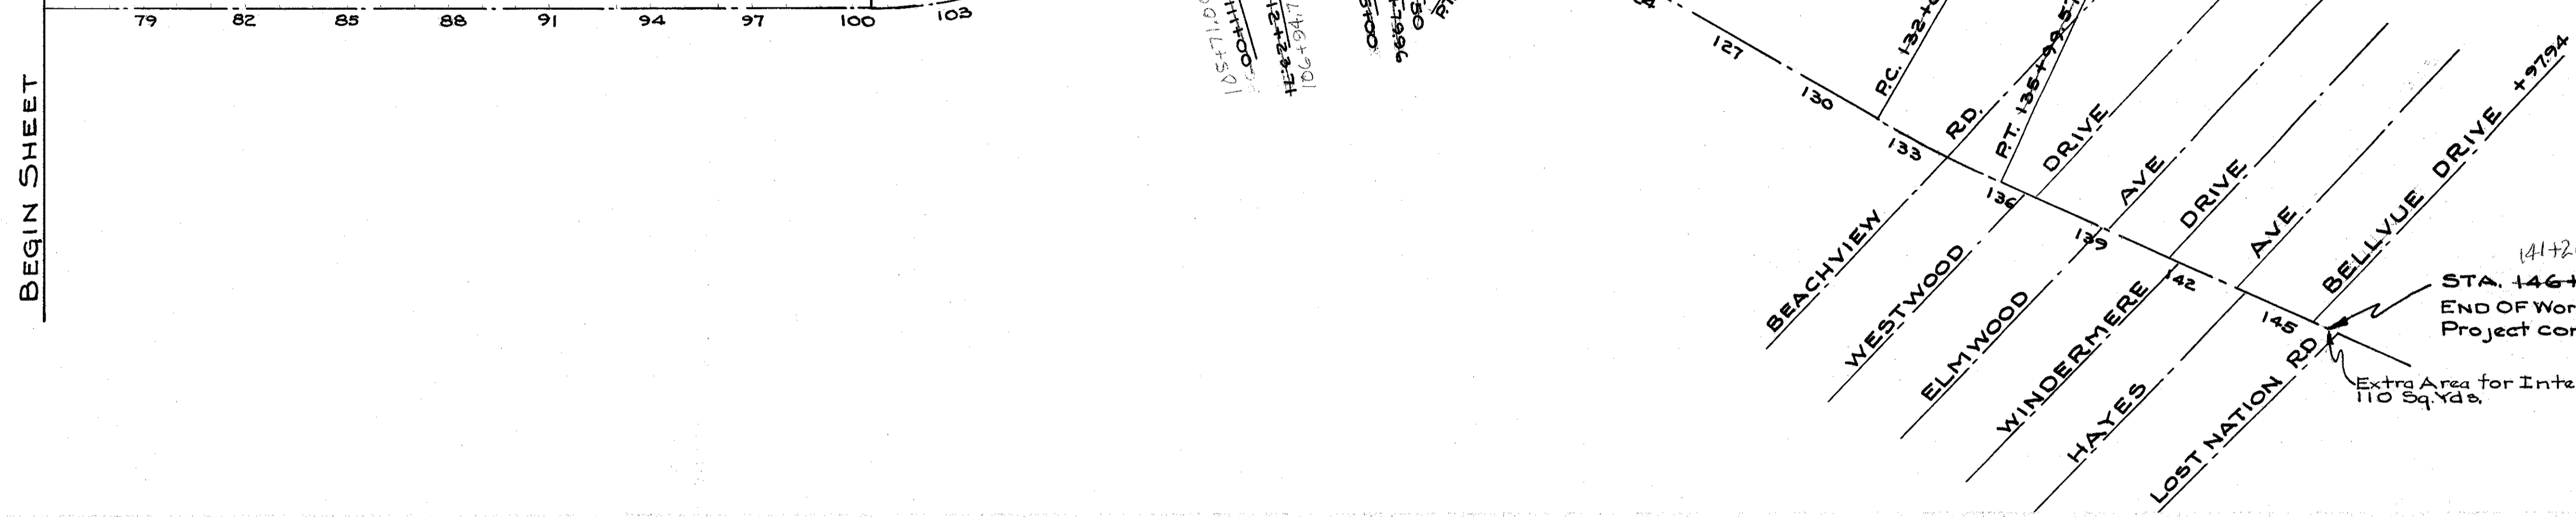

- 76 611.83
- 79 613.78
- 82 613.30
- 85 612.82
- 88 612.56
- 91 613.14
- 94 613.62
- 97 614.66
- 100 616.47
- 103 615.34
- 106 614.16
- 109 610.42
- 112 606.44
- 115 594.53
- 118 608.03
- 121 616.96
- 124 619.48
- 127 621.69
- 130 622.52
- 133 623.12
- 136 623.72
- 139 624.56
- 142 625.56
- 145 626.88
- +55 627.51