


EXTRA AREA DETAILS

SCALE 1" = 20'

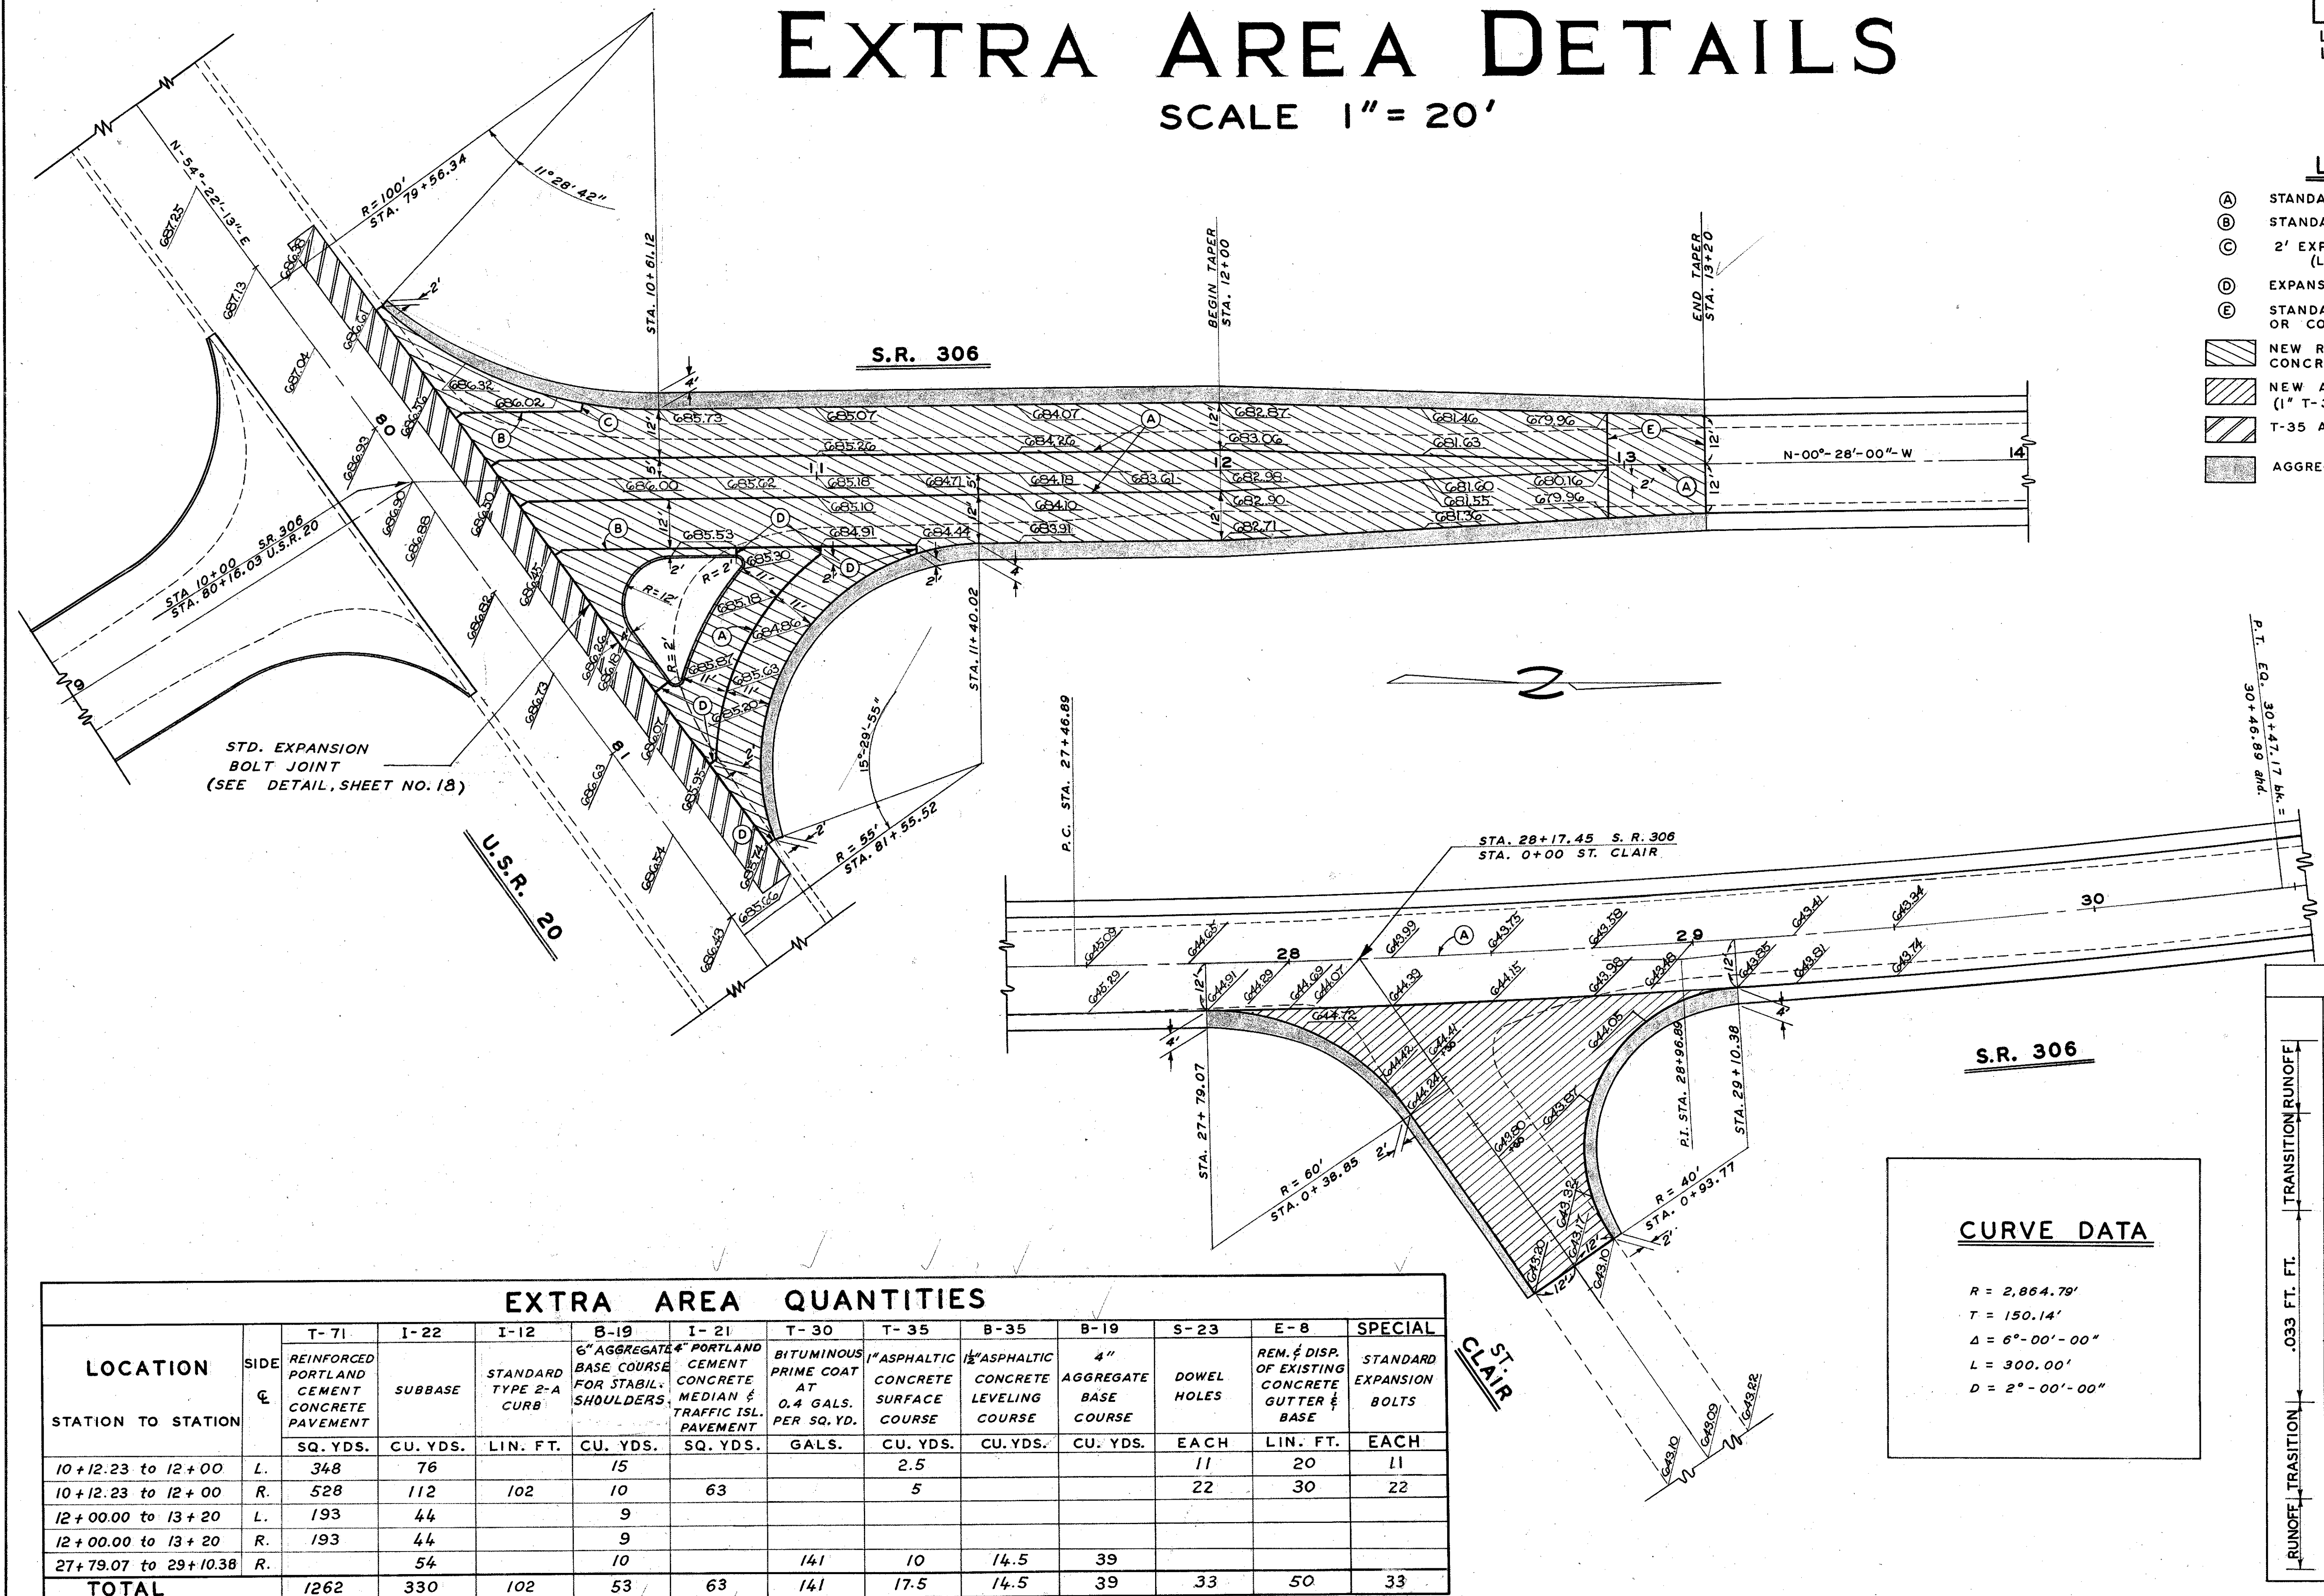

- ### LEGEND
- (A) STANDARD LONGITUDINAL JOINT.
 - (B) STANDARD KEY JOINT WITHOUT TIE BARS.
 - (C) 2' EXPANSION JOINT WITHOUT DOWELS. (LOCATED ON RADIAL LINES)
 - (D) EXPANSION JOINT WITHOUT DOWELS.
 - (E) STANDARD TRANSVERSE CONTRACTION OR CONSTRUCTION JOINTS.
 - NEW REINFORCED PORTLAND CEMENT CONCRETE PAVEMENT.
 - NEW ASPHALTIC CONCRETE PAVEMENT. (1" T-35, 1 1/2" B-35, 4" B-19, 4" I-22)
 - T-35 ASPHALT FEATHER.
 - AGGREGATE BERMS.

STD. EXPANSION BOLT JOINT (SEE DETAIL, SHEET NO. 18)

S.R. 306

CURVE DATA

R = 2,864.79'
T = 150.14'
Δ = 6°-00'-00"
L = 300.00'
D = 2°-00'-00"

SUPERELEVATION TABLE

STATION	PAVEMENT ELEVATIONS		
	LT. EDGE	℄	RT. EDGE
26+25	648.08	648.27	648.08
26+50	647.28	647.47	647.34
26+75	646.59	646.78	646.71
27+00	645.96	646.15	646.15
27+25	645.39	645.58	645.68
27+50	644.89	645.09	645.29
27+75	644.35	644.65	644.95
28+00	643.89	644.29	644.69
28+25	643.59	643.99	644.39
28+50	643.35	643.75	644.15
28+75	643.18	643.58	643.98
29+00	643.08	643.48	643.88
29+25	643.01	643.41	643.81
29+50	642.94	643.34	643.74
29+75	642.87	643.27	643.67
30+00	642.80	643.20	643.60
30+25	642.83	643.13	643.43
30+50	642.86	643.06	643.26
30+75	642.80	642.99	643.09
31+00	642.73	642.92	642.92
31+25	642.66	624.85	642.78
31+50	642.59	642.78	642.65
31+75	642.52	642.71	642.52

EXTRA AREA QUANTITIES

LOCATION STATION TO STATION	SIDE ℄	T-71	I-22	I-12	B-19	I-21	T-30	T-35	B-35	B-19	S-23	E-8	SPECIAL
		REINFORCED PORTLAND CEMENT CONCRETE PAVEMENT	SUBBASE	STANDARD TYPE 2-A CURB	6" AGGREGATE BASE COURSE FOR STABIL. SHOULDERS.	4" PORTLAND CEMENT CONCRETE MEDIAN & TRAFFIC ISL. PAVEMENT	BITUMINOUS PRIME COAT AT 0.4 GALS. PER SQ. YD.	1" ASPHALTIC CONCRETE SURFACE COURSE	1 1/2" ASPHALTIC CONCRETE LEVELING COURSE	4" AGGREGATE BASE COURSE	DOWEL HOLES	REM. & DISP. OF EXISTING CONCRETE GUTTER & BASE	STANDARD EXPANSION BOLTS
		SQ. YDS.	CU. YDS.	LIN. FT.	CU. YDS.	SQ. YDS.	GALS.	CU. YDS.	CU. YDS.	CU. YDS.	EACH	LIN. FT.	EACH
10+12.23 to 12+00	L.	348	76		15			2.5			11	20	11
10+12.23 to 12+00	R.	528	112	102	10	63		5			22	30	22
12+00.00 to 13+20	L.	193	44		9								
12+00.00 to 13+20	R.	193	44		9								
27+79.07 to 29+10.38	R.		54		10		141	10	14.5	39			
TOTAL		1262	330	102	53	63	141	17.5	14.5	39	33	50	33