
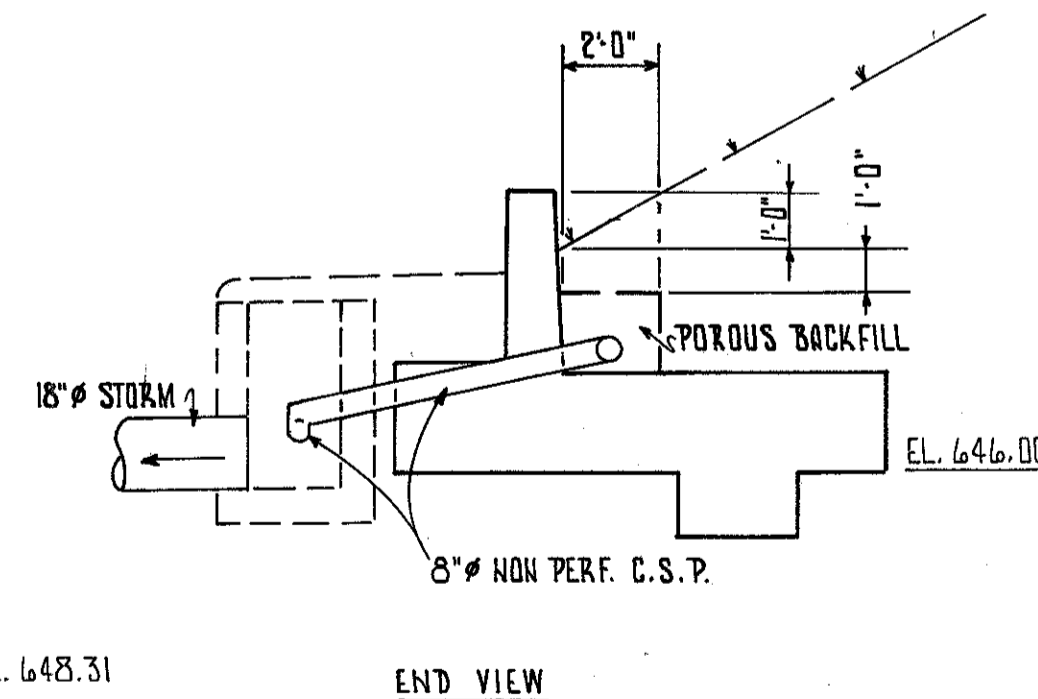
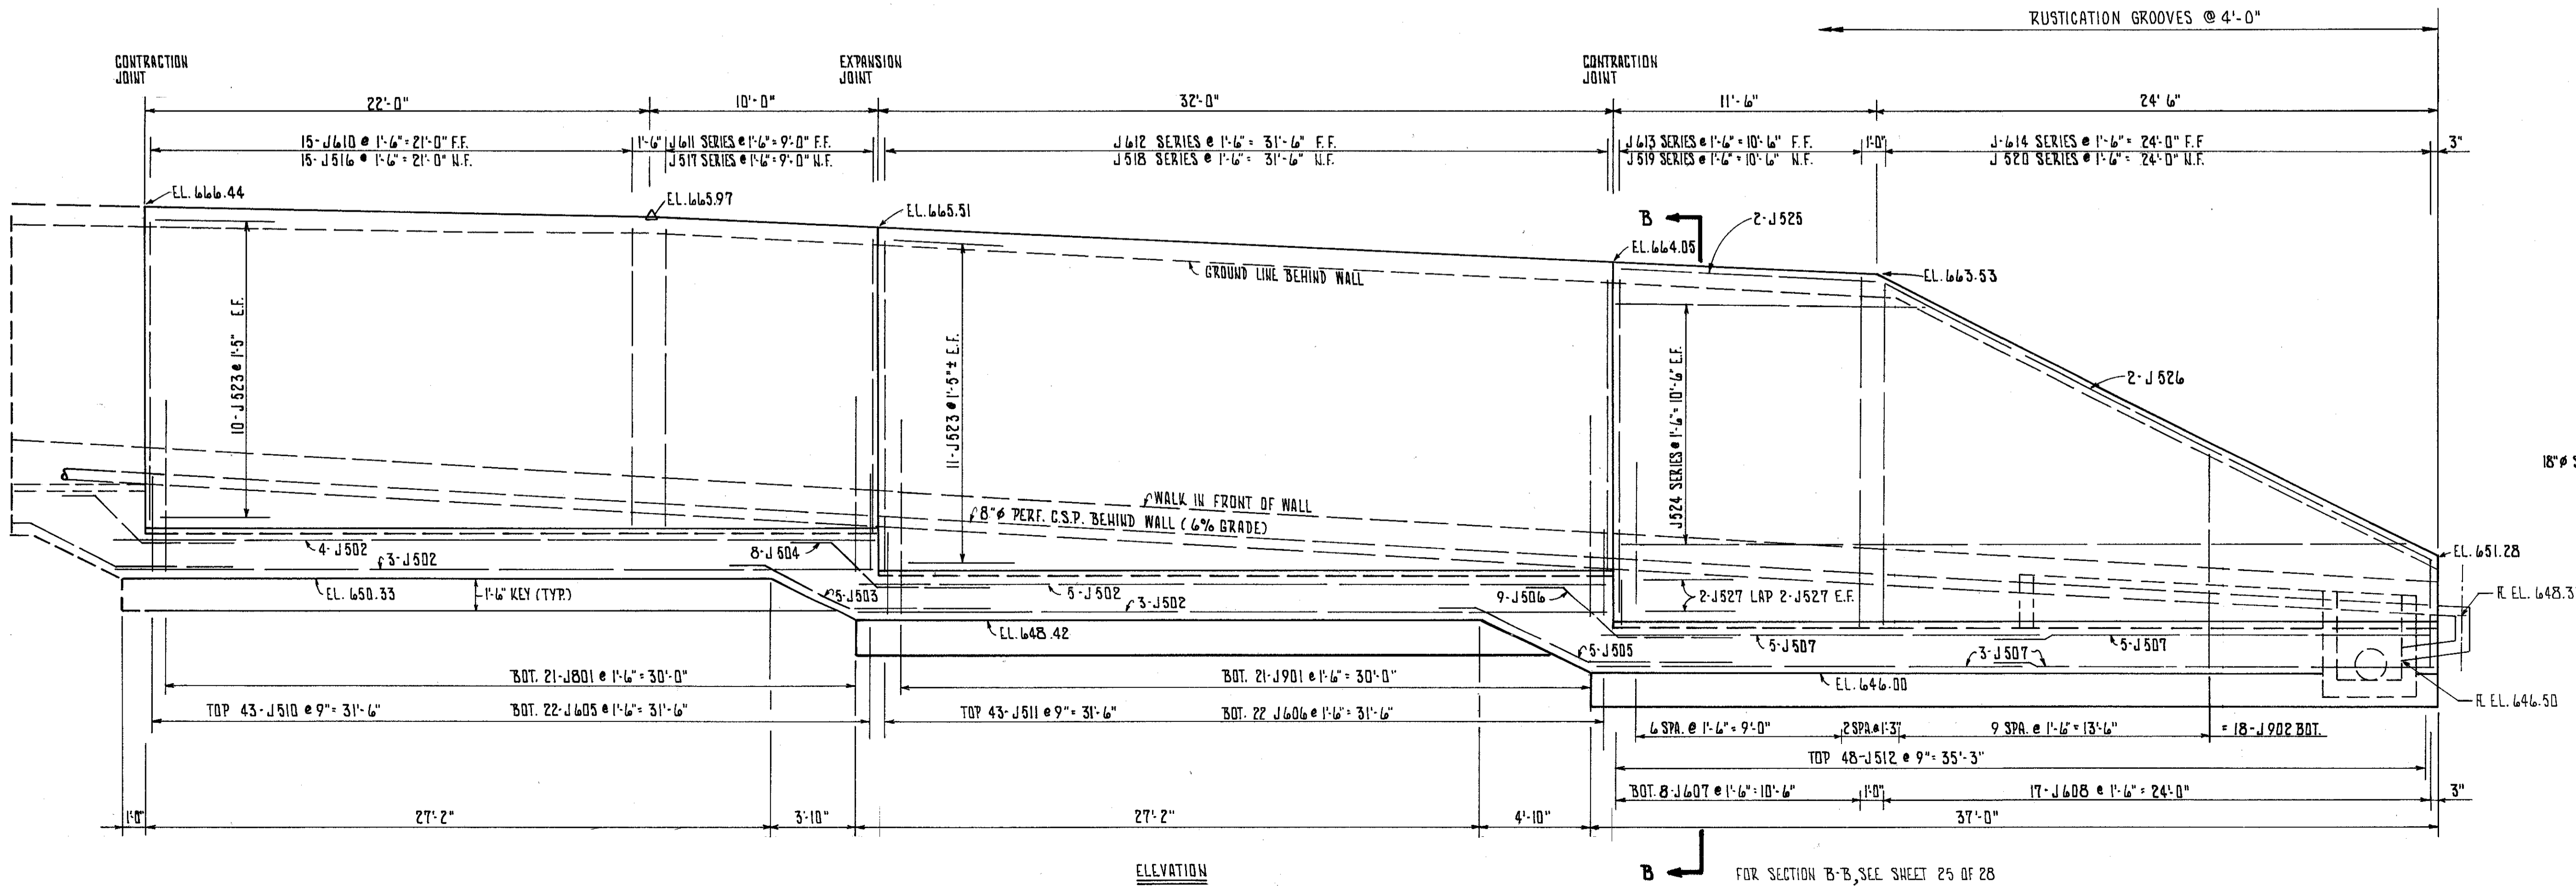


FHWA REGION	STATE	PROJECT
5	OHIO	

86  
101

LAKE COUNTY  
LAK 306-6.15

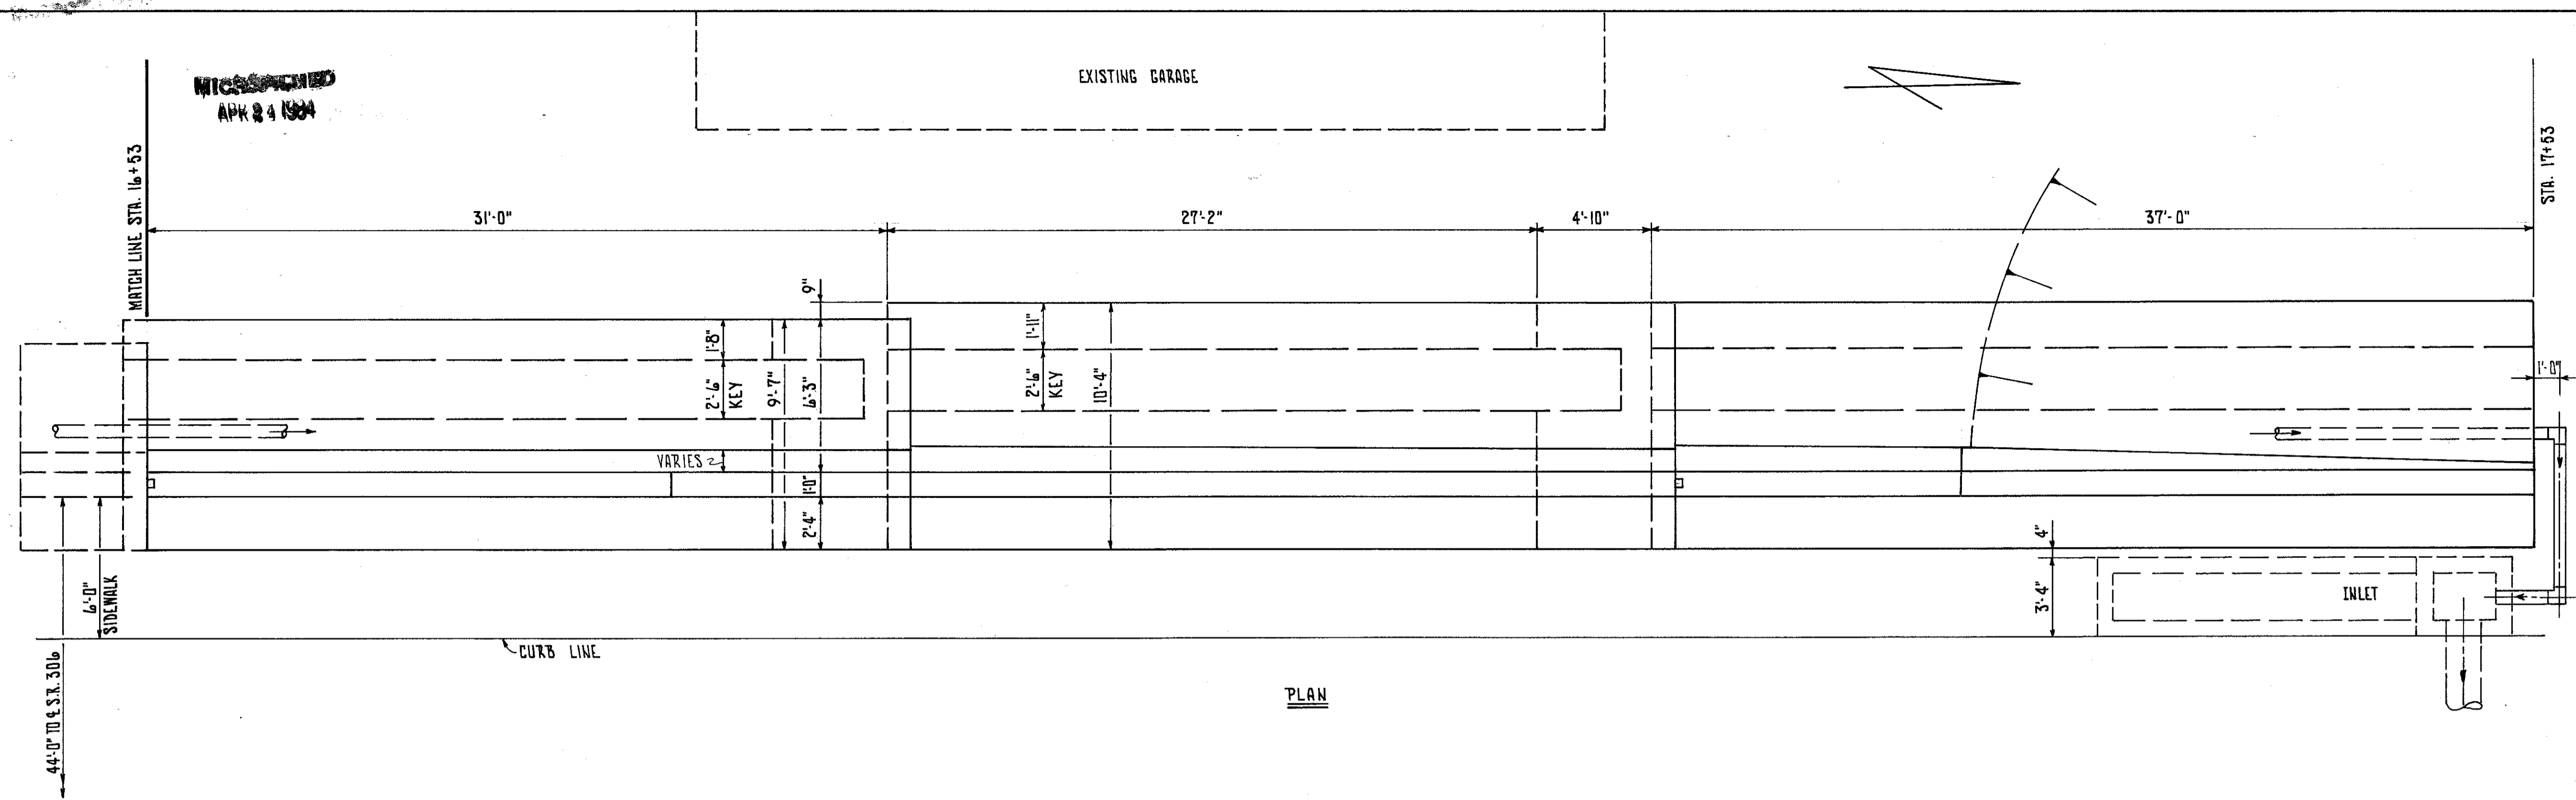

Sheet superseded by Sheet 86A, 3-27-81

FRANKLIN CONSULTANTS INC.						26 / 28
COLUMBUS, OHIO						
<b>RETAINING WALL</b>						
STA. 16 + 53 TO STA. 17 + 53						
DESIGNED	DRAWN	TRACED	CHECKED	REVIEWED	DATE	REVISED
MM	MM	PH	SM	JF	10/22/79	

BRUNING 44-132 30845-1