

SEEDING

END SQ WIDTH YDS


CALC. BY: K
DATE: 4/12/88
CHKD. BY: M
DATE: 6/20/88

LAKE COUNTY
LAK - 306 - 6.50

17
38

FINAL SURVEY SURVEYED, PLOTTED, NOTE BOOK, TEMPLATE, NO. AREAS CHECKED.

DATE, FINAL SURVEY SURVEYED, PLOTTED, NOTE BOOK, TEMPLATE, NO. AREAS CHECKED.

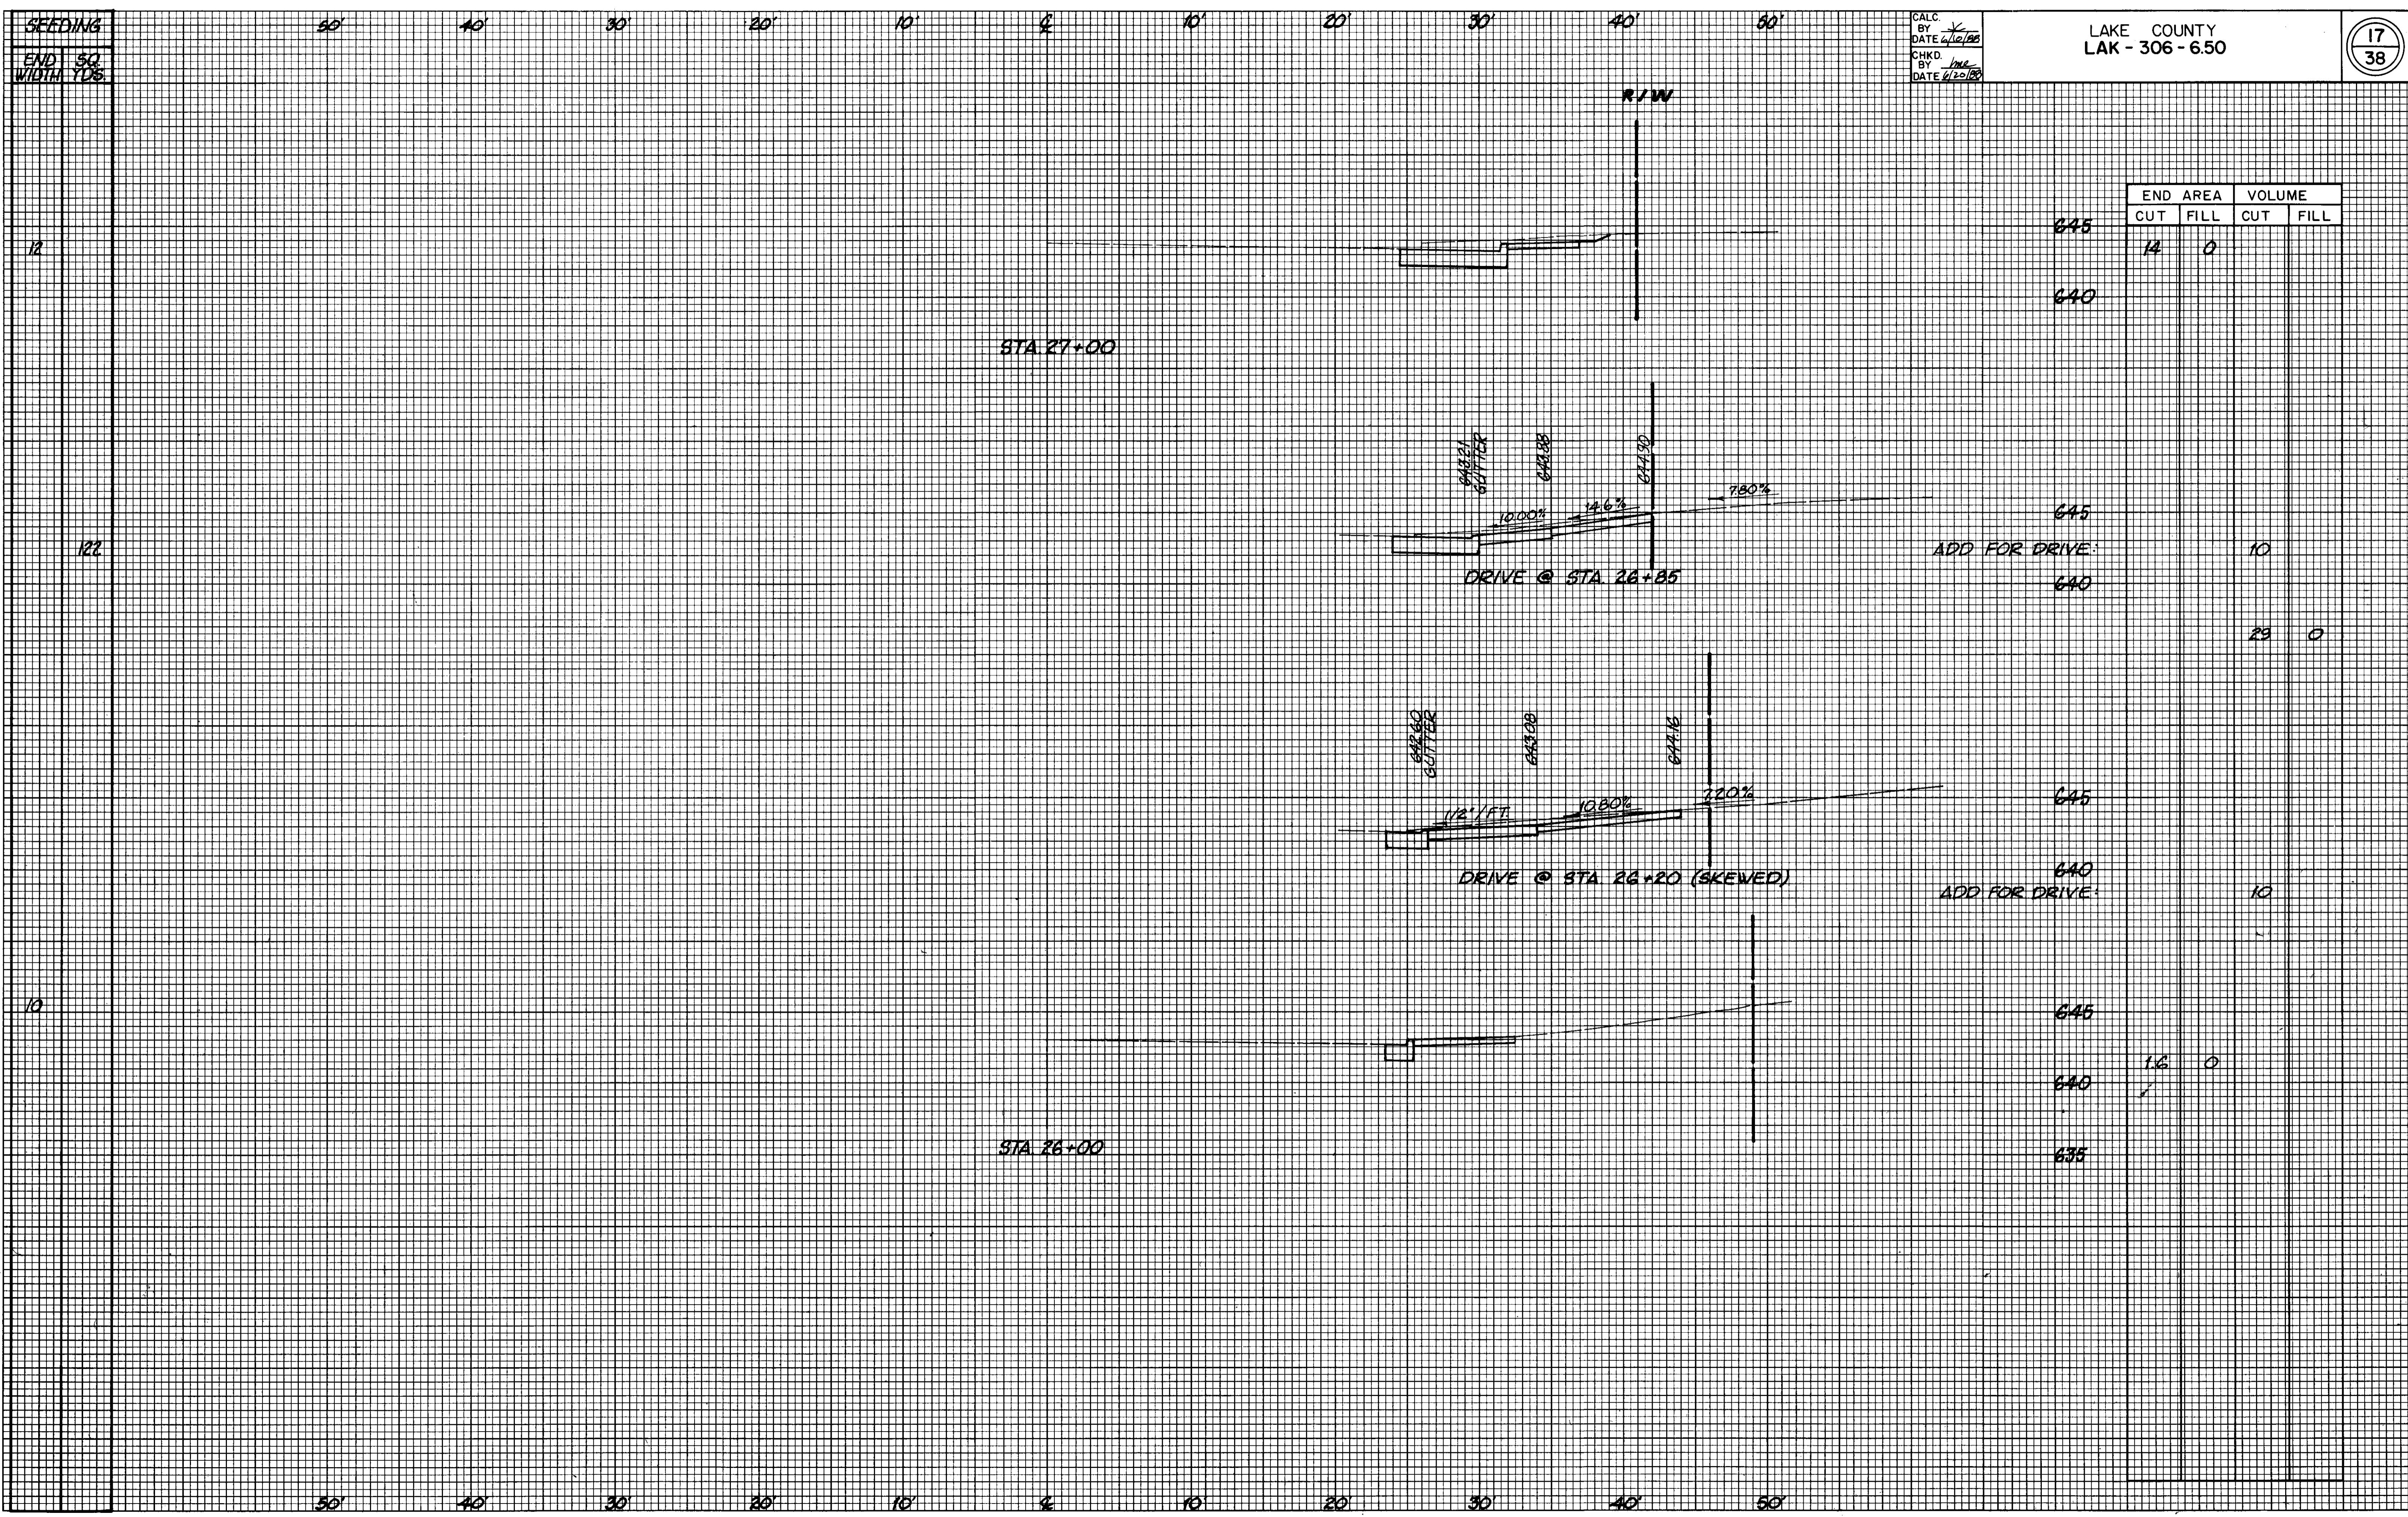

ELEVATION	END AREA		VOLUME	
	CUT	FILL	CUT	FILL
645	14	0		
640				
645				
ADD FOR DRIVE:			10	
640				
			29	0
645				
640				
ADD FOR DRIVE:			10	
645				
640	16	0		
635				