

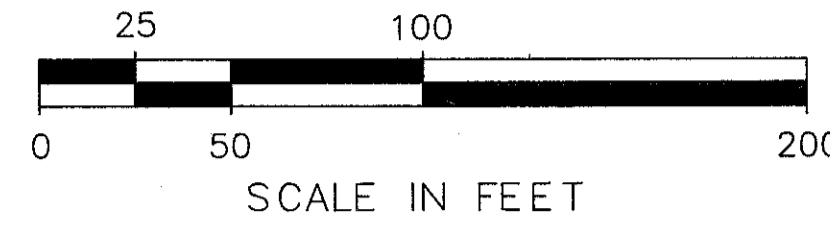


# LIGHTING CIRCUIT PLAN

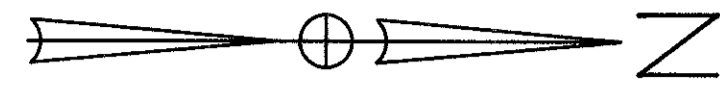

- LEGEND**
- EXISTING TOWER LIGHT
  - EXISTING PULL BOX
  - PROPOSED PULL BOX
  - EXISTING CONTROL CENTER
  - PROPOSED CONTROL CENTER
  - EXISTING ELEC. CIRCUIT
  - PROPOSED ELEC. CIRCUIT

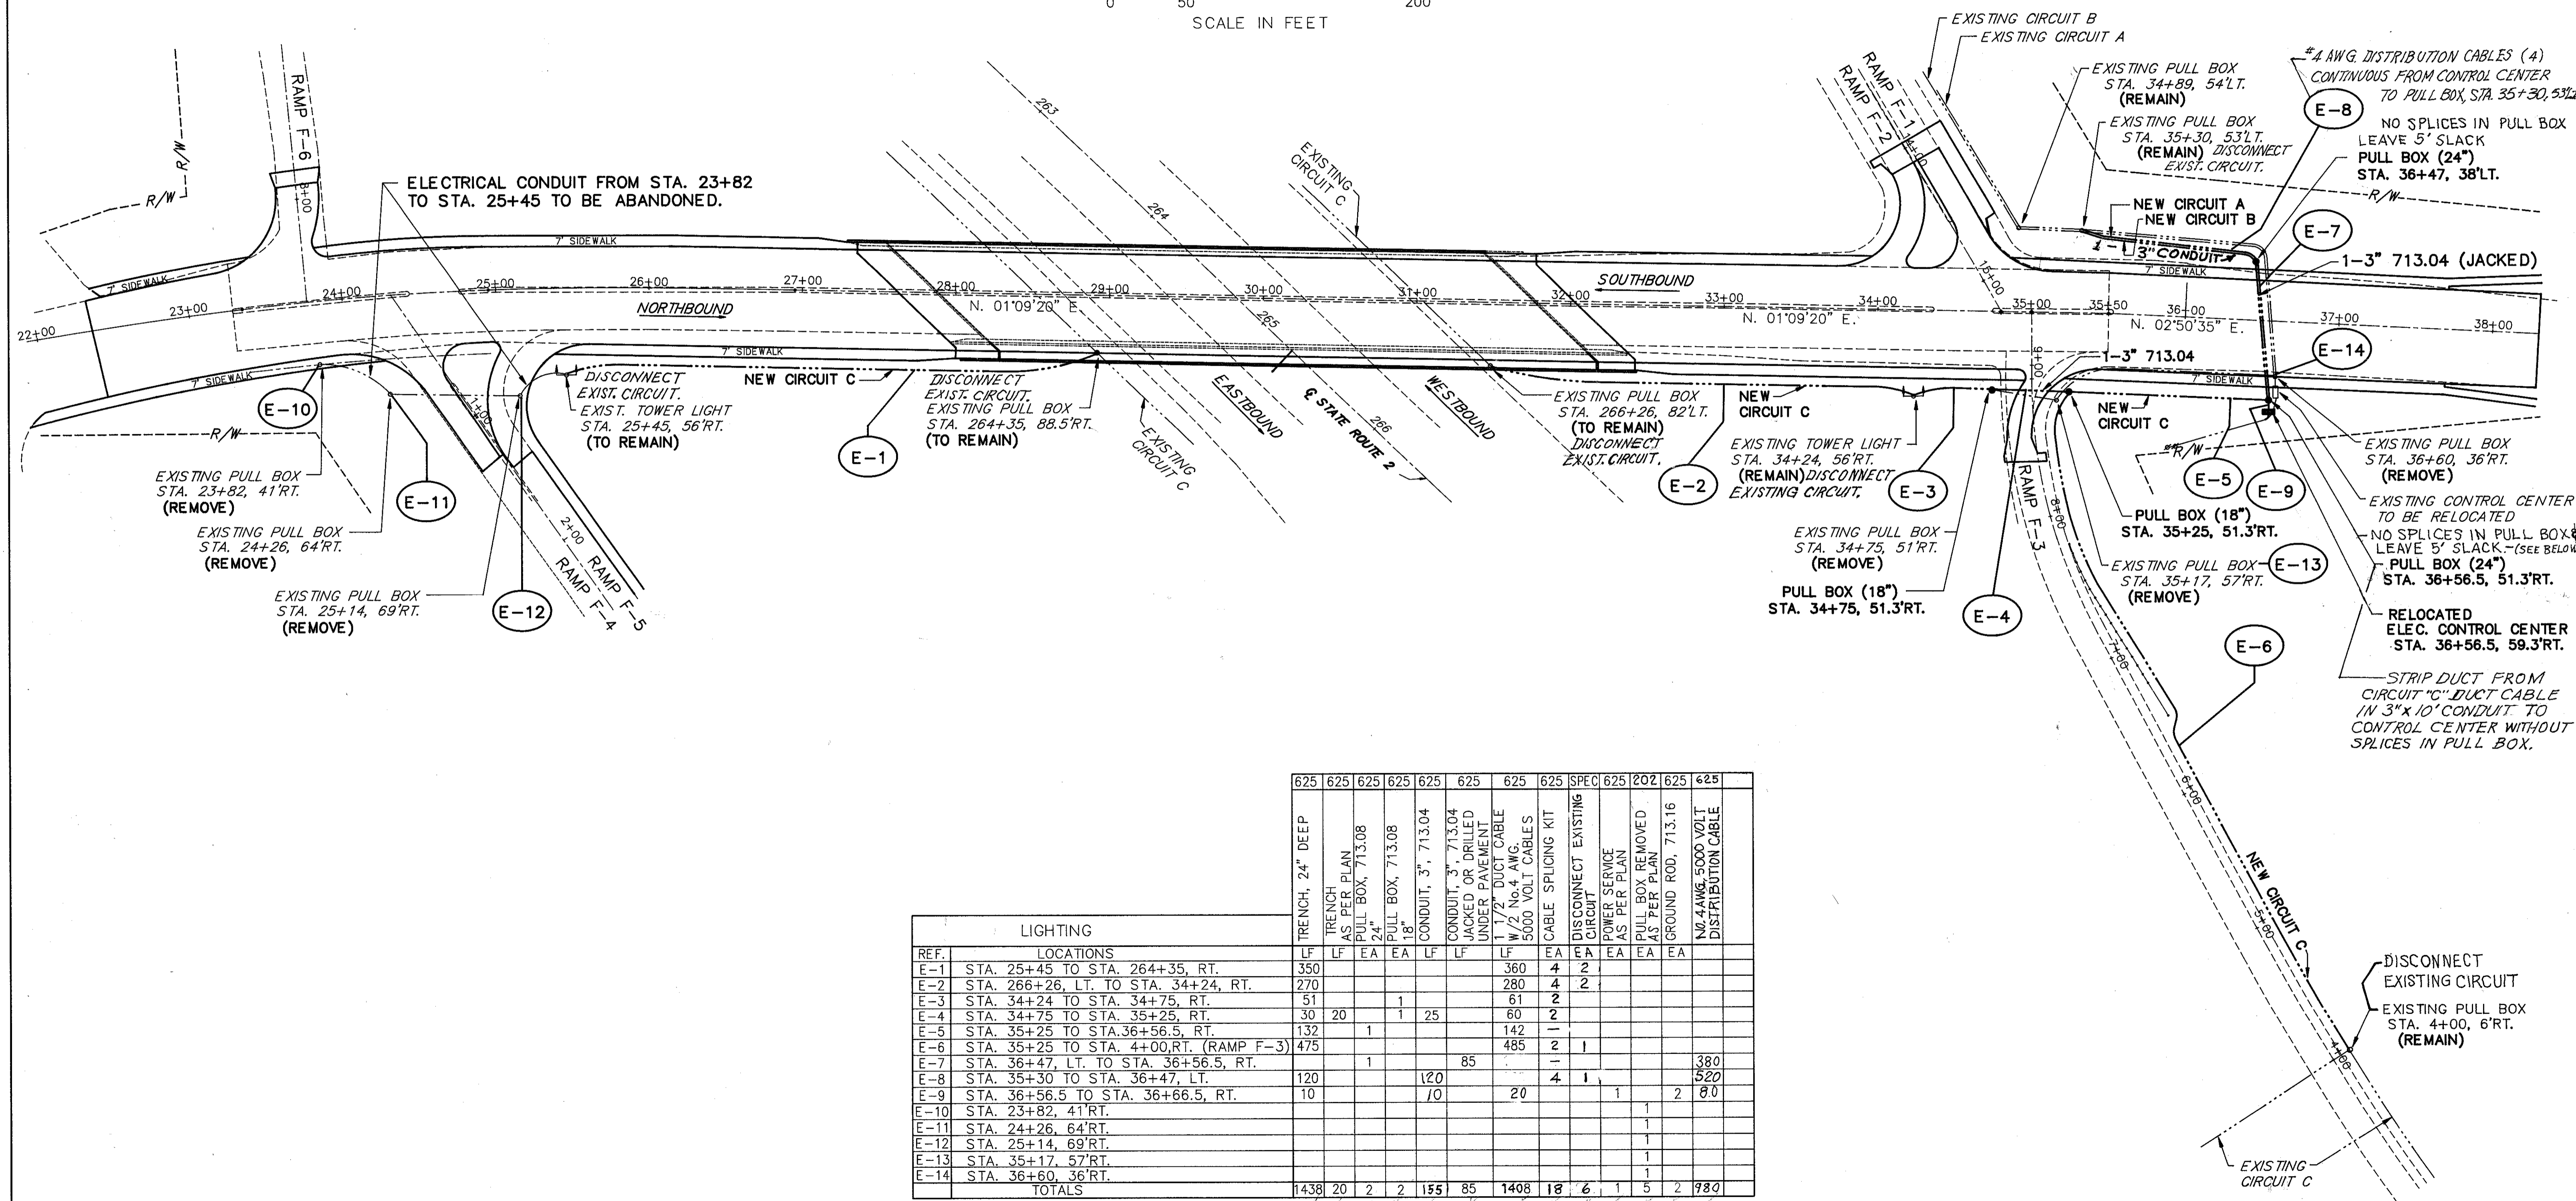

REF.	LOCATIONS	MATERIALS																
		LF	LF	EA	EA	LF	LF	EA	EA	EA	EA	EA						
E-1	STA. 25+45 TO STA. 264+35, RT.	350																
E-2	STA. 266+26, LT. TO STA. 34+24, RT.	270																
E-3	STA. 34+24 TO STA. 34+75, RT.	51				1												
E-4	STA. 34+75 TO STA. 35+25, RT.	30	20			1	25											
E-5	STA. 35+25 TO STA. 36+56.5, RT.	132				1												
E-6	STA. 35+25 TO STA. 4+00, RT. (RAMP F-3)	475																
E-7	STA. 36+47, LT. TO STA. 36+56.5, RT.																	
E-8	STA. 35+30 TO STA. 36+47, LT.	120					120											
E-9	STA. 36+56.5 TO STA. 36+66.5, RT.	10					10											
E-10	STA. 23+82, 41'RT.																	
E-11	STA. 24+26, 64'RT.																	
E-12	STA. 25+14, 69'RT.																	
E-13	STA. 35+17, 57'RT.																	
E-14	STA. 36+60, 36'RT.																	
TOTALS		1438	20	2	2	155	85	1408	18	6	1	5	2	980				