


CALC. BY
DATE
CHKD. BY
DATE

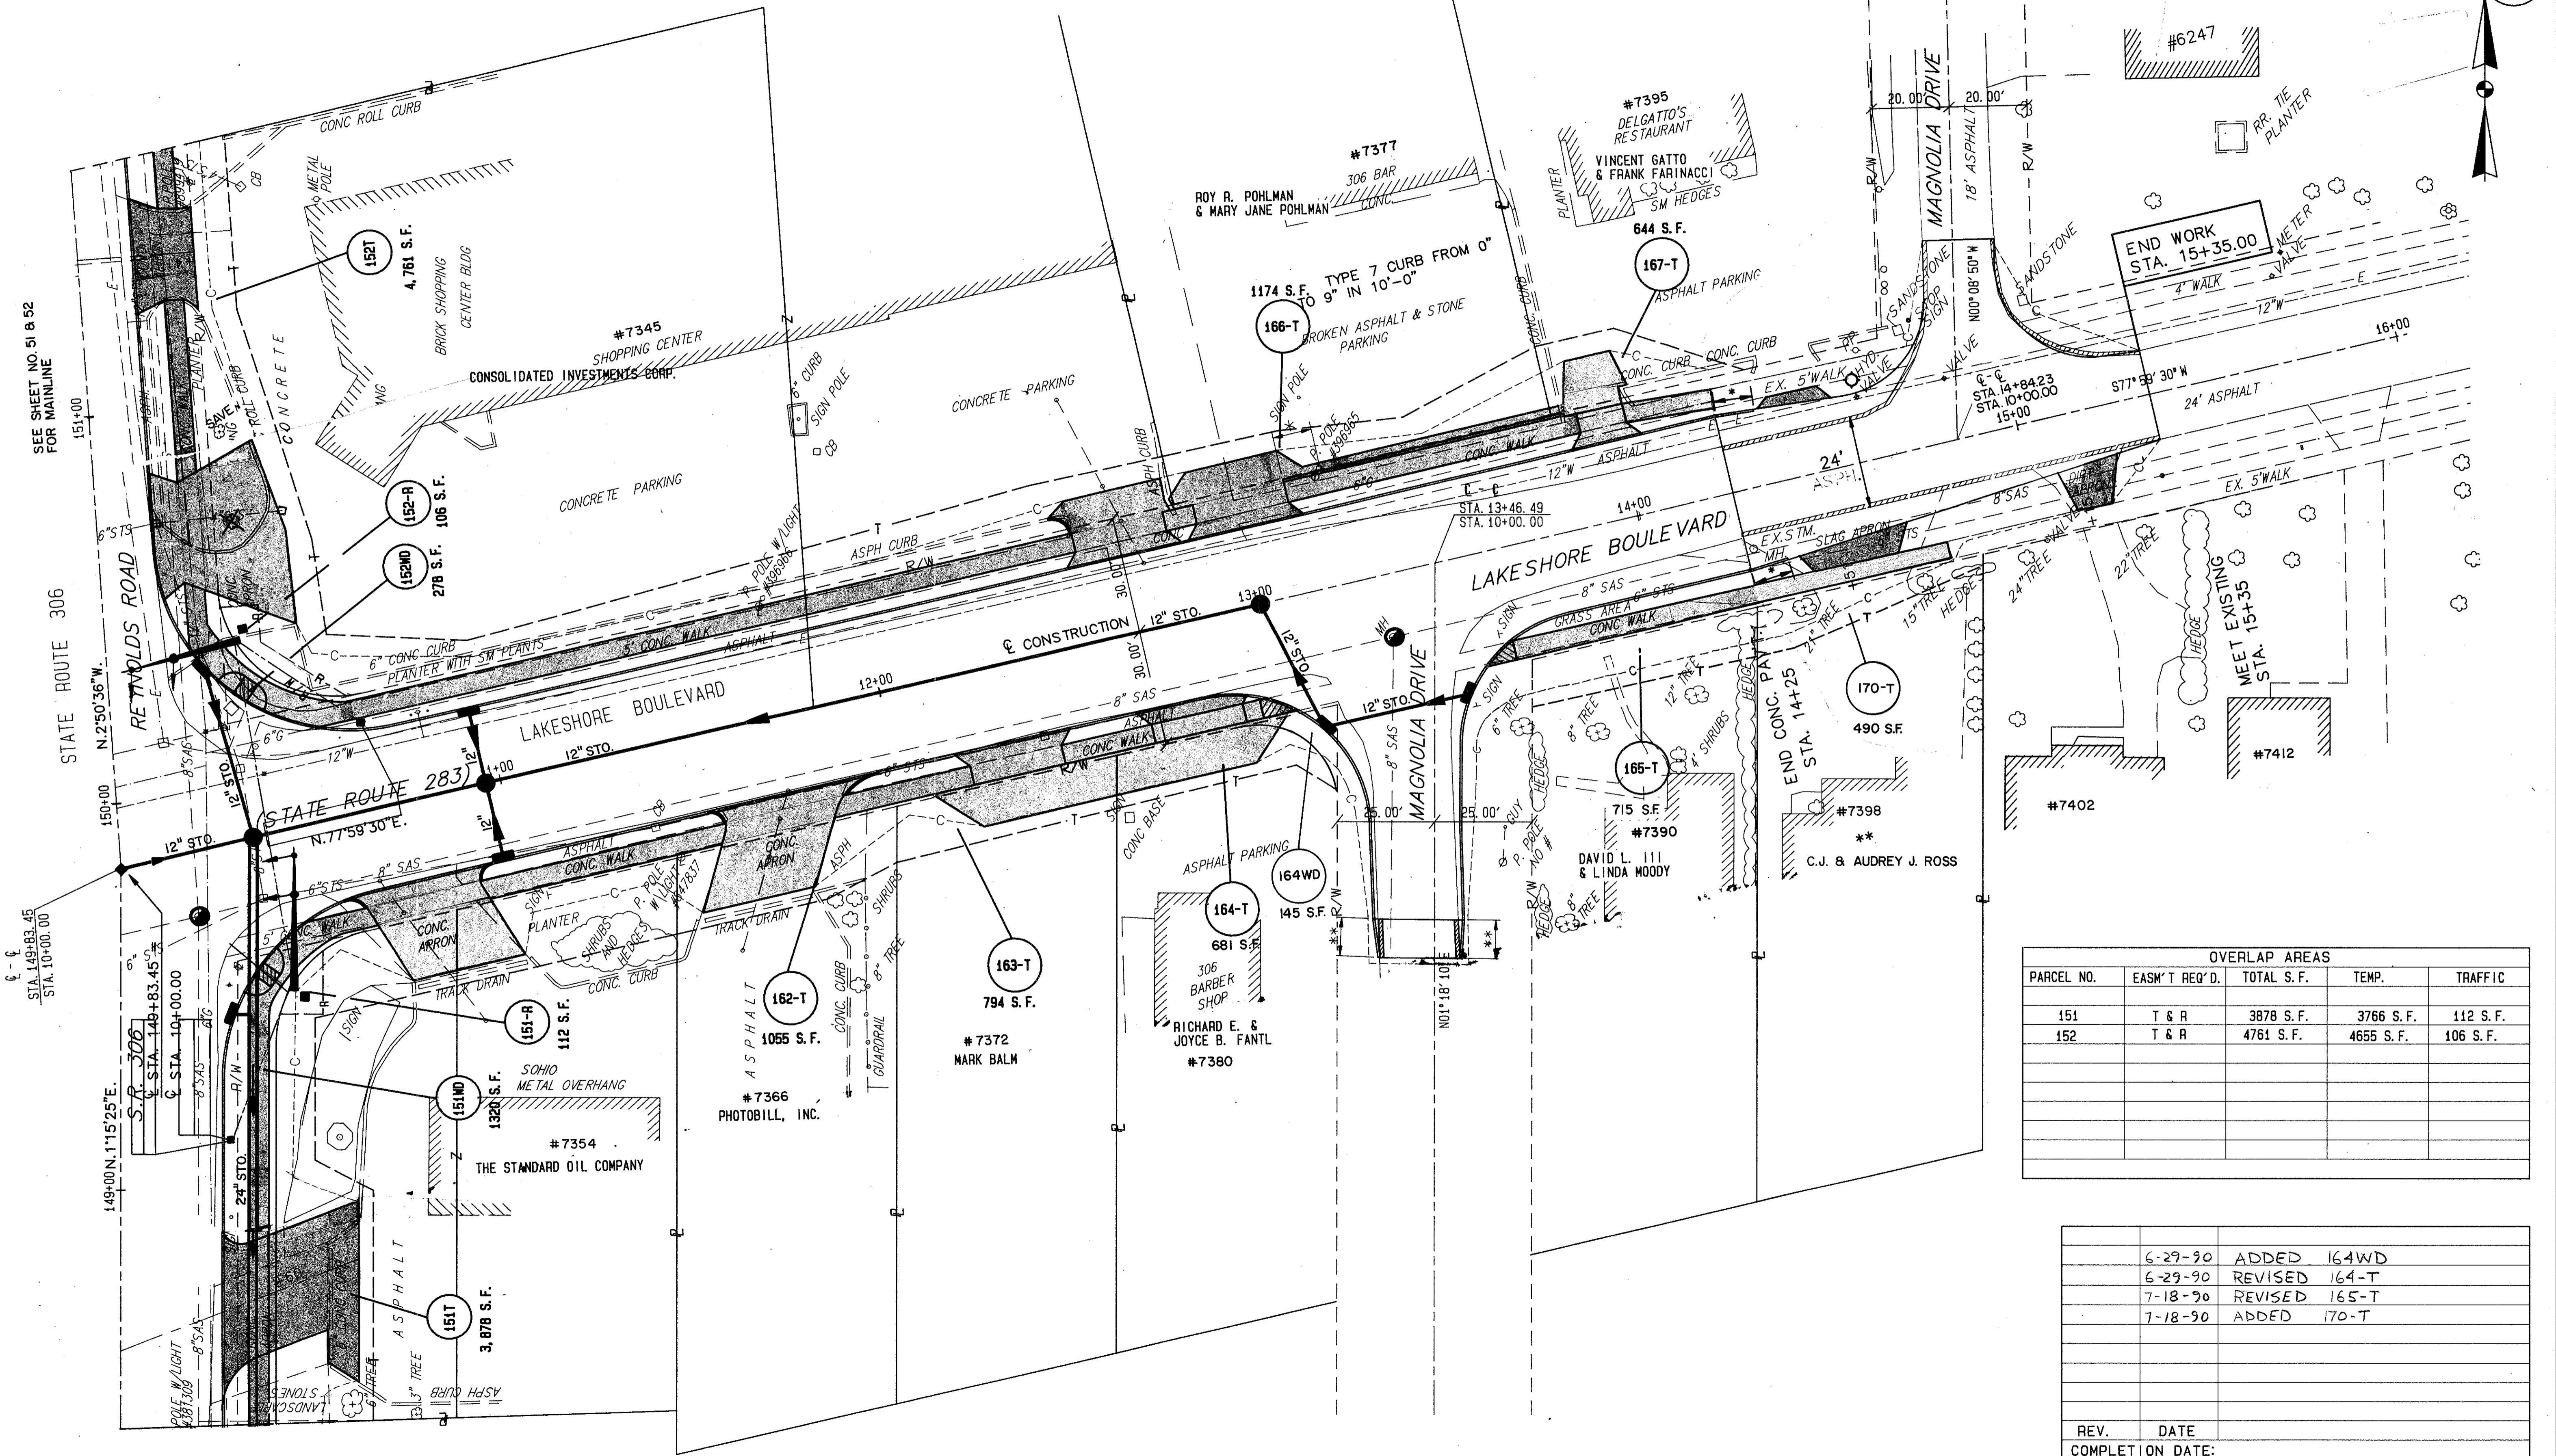

OVERLAP AREAS				
PARCEL NO.	EASMT REQ'D.	TOTAL S.F.	TEMP.	TRAFFIC
151	T & R	3878 S.F.	3766 S.F.	112 S.F.
152	T & R	4761 S.F.	4655 S.F.	106 S.F.

REV.	DATE	COMPLETION DATE:
	6-29-90	ADDED 164WD
	6-29-90	REVISED 164-T
	7-18-90	REVISED 165-T
	7-18-90	ADDED 170-T