


MICROFILMED
MAY 25 1984

LAK - 91 - 3.84

19
21
2
4

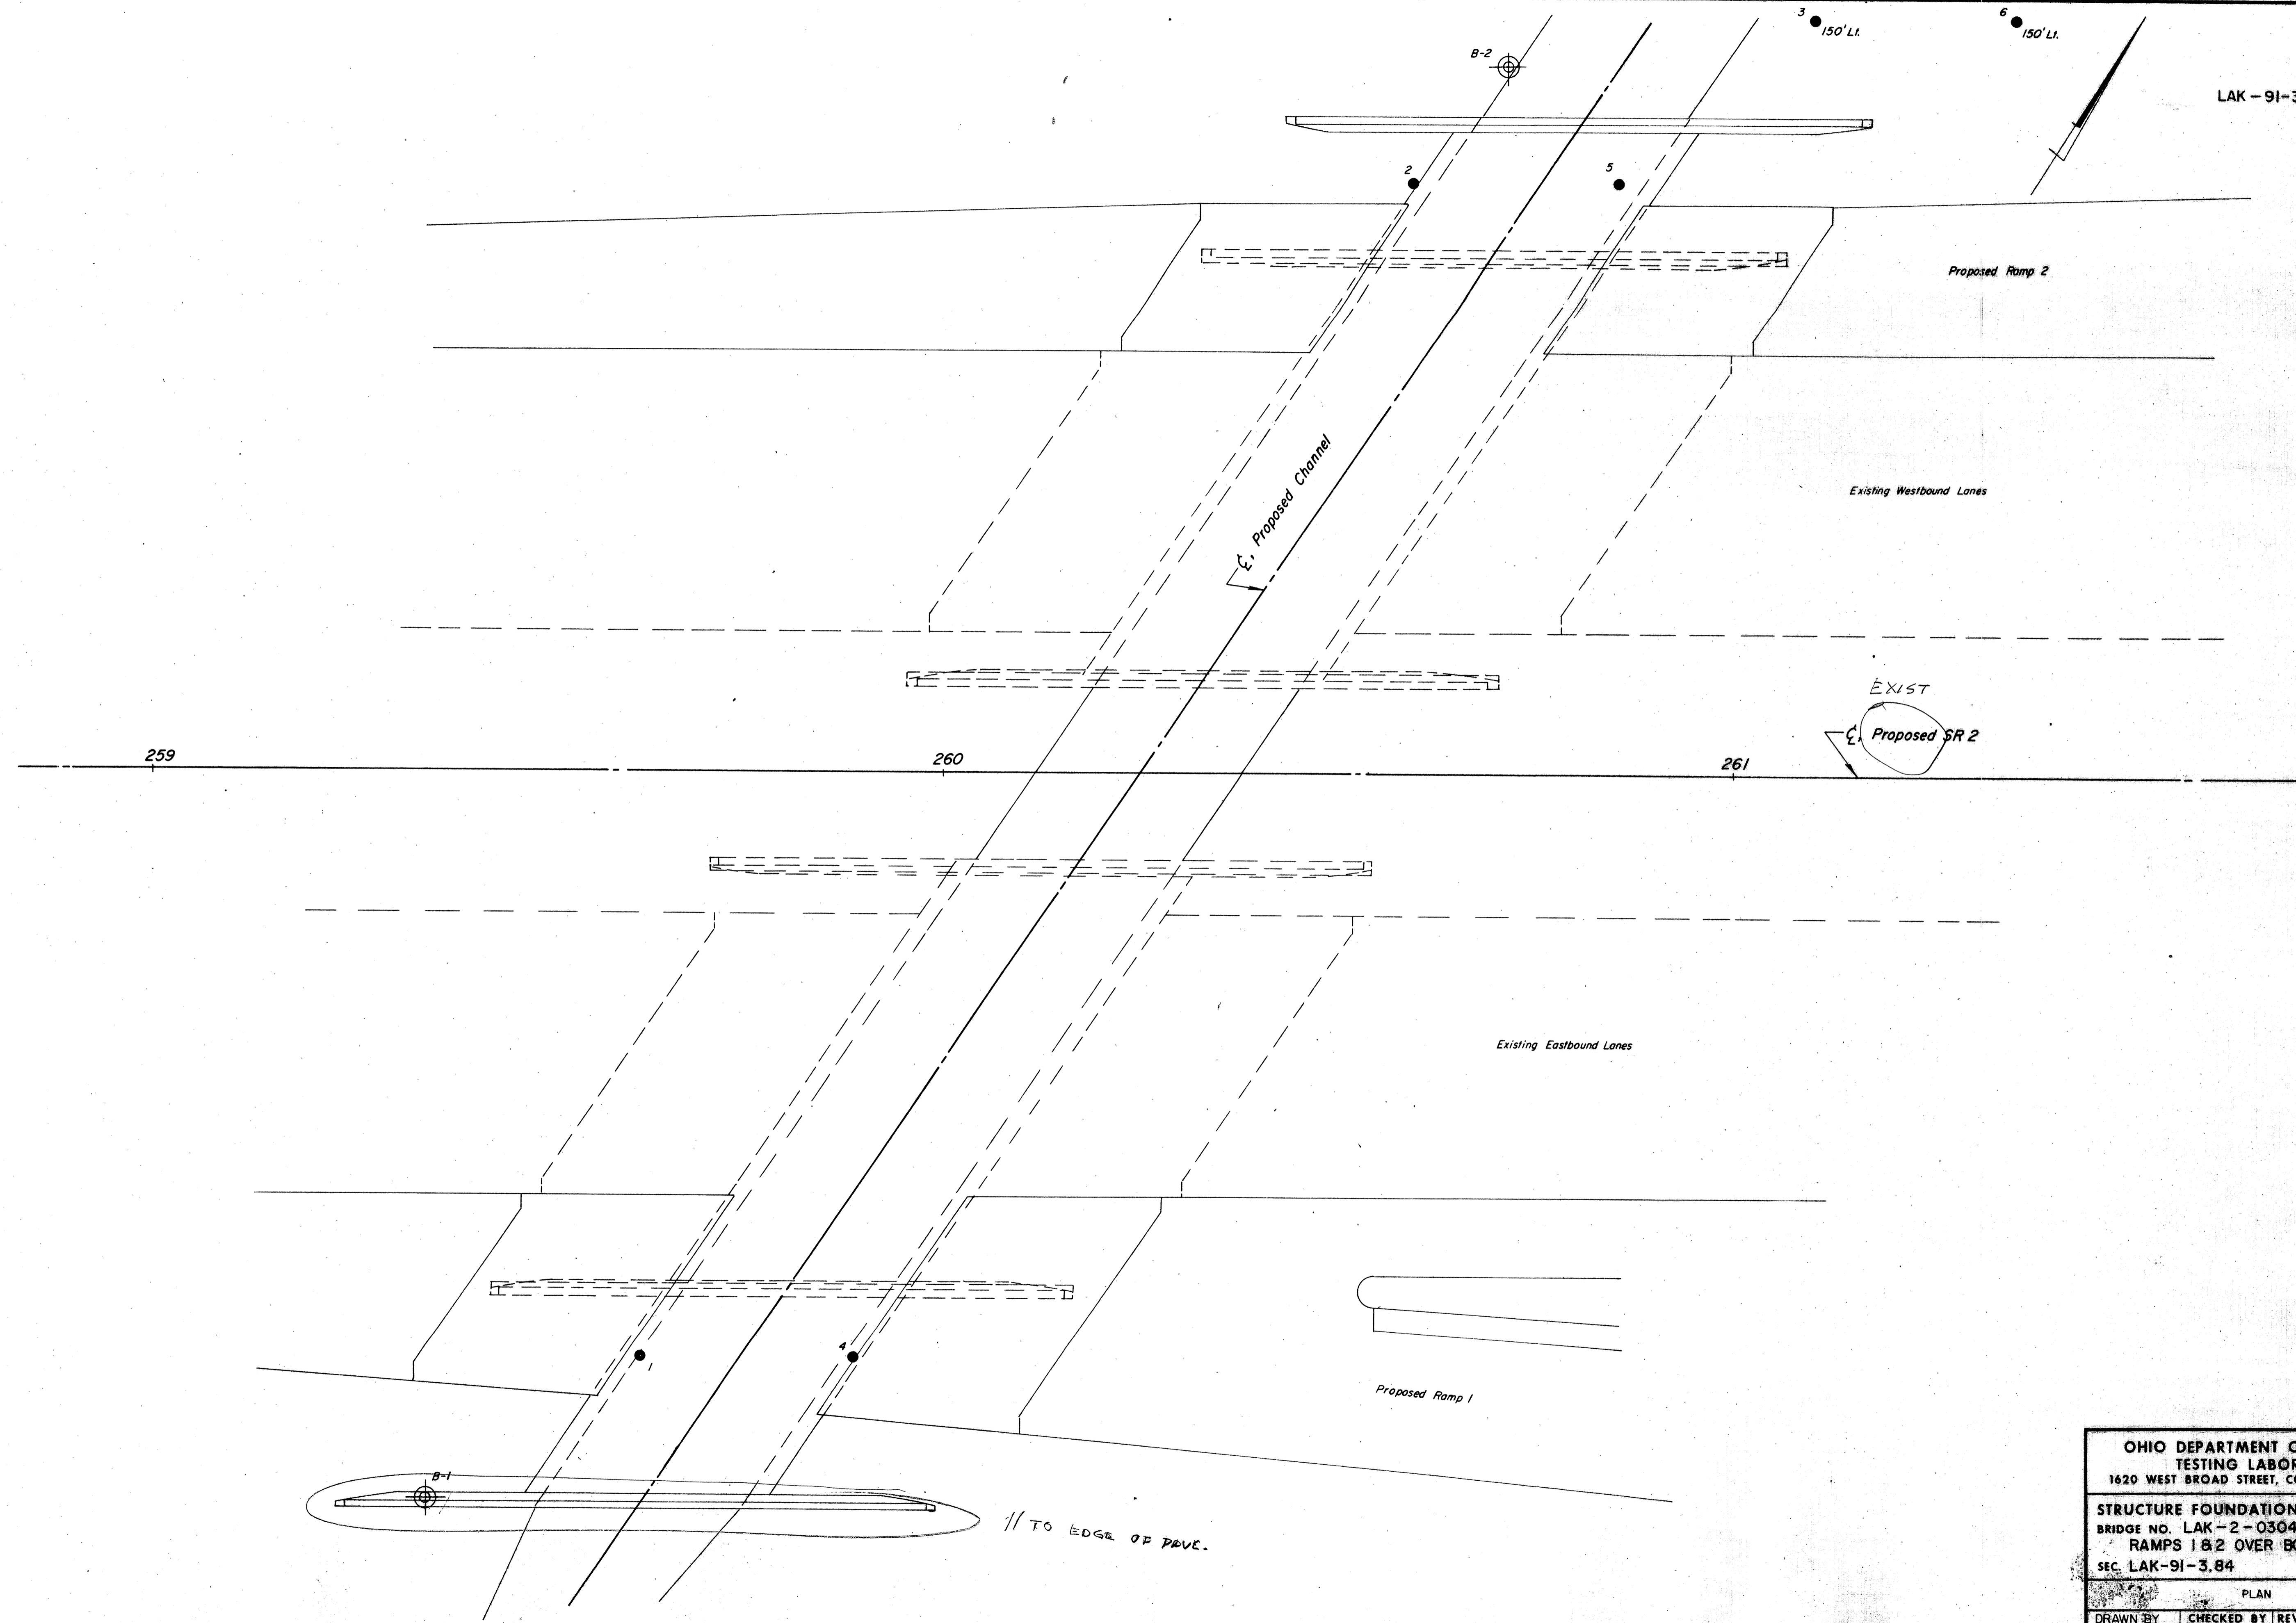

OHIO DEPARTMENT OF HIGHWAYS
 TESTING LABORATORY
 1620 WEST BROAD STREET, COLUMBUS 23, OHIO

STRUCTURE FOUNDATION INVESTIGATION
 BRIDGE NO. LAK-2-0304 L/R
 RAMPS 1 & 2 OVER BOX CULVERT
 SEC. LAK-91-3.84

PLAN			
DRAWN BY	CHECKED BY	REVIEWED BY	DATE
R.L.C.	L.N.L.	R.D.R.	5/19/65

SCALE: 1"=10'