


TRACT 10  
LOT 6

LOUIS & ROSE SALVATORE

Mentor Township  
Lots 5&6 Tract 10  
Lake County  
R9W

FED. RD. DIVISION	STATE	PROJECT	204 212
2	OHIO		

LAK-44-7.22  
R/W PLAN  
LIMITED ACCESS

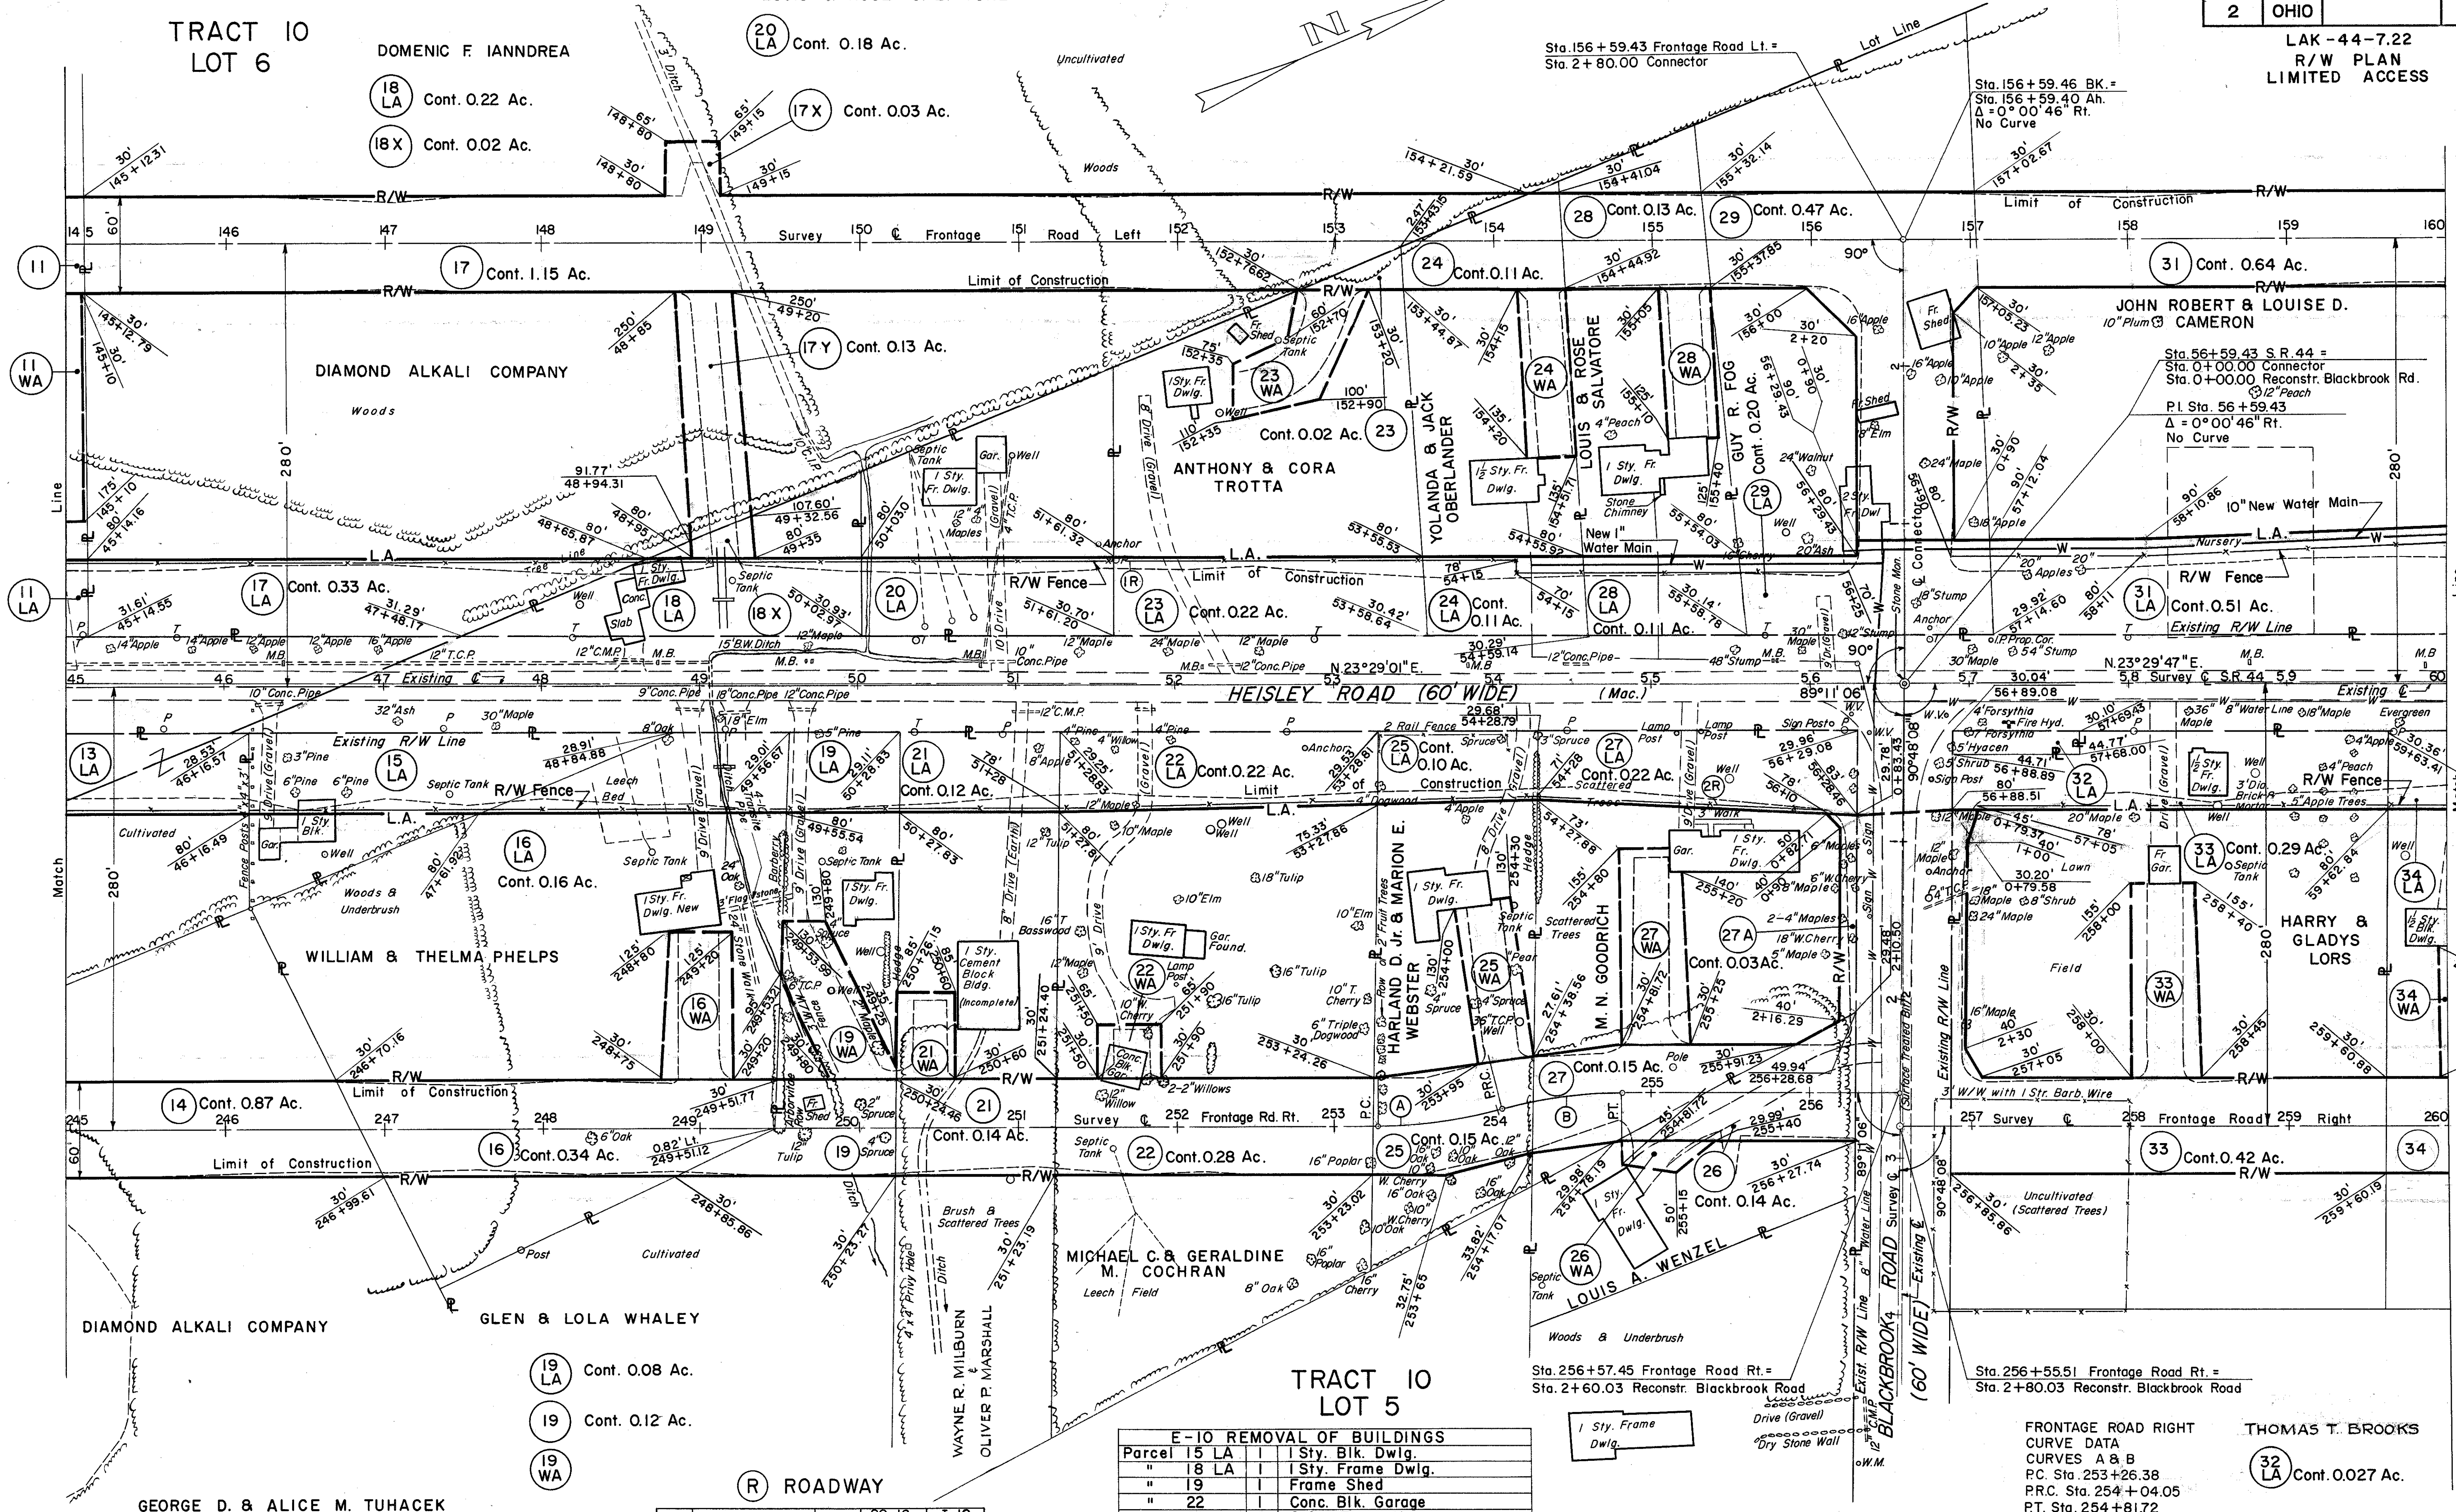

GEORGE D. & ALICE M. TUHACEK

15 LA Cont. 0.24 Ac.

19 LA Cont. 0.08 Ac.  
19 Cont. 0.12 Ac.  
19 WA

R ROADWAY

REF. NO.	STATION	SIDE	SS-18 FENCE TYPE "A"	I-10 DUMPED ROCK CH. PROT.
1R	45+00	60+00	Lt.	4.43 9
2R	45+00	60+00	Rt.	4.06 3

E-10 REMOVAL OF BUILDINGS

Parcel	Description
15 LA	1 Sty. Bk. Dwlg.
18 LA	1 Sty. Frame Dwlg.
19	Frame Shed
22	Conc. Bk. Garage
29	2 Sty. Frame House
29	Frame Sheds
33 LA	1 1/2 Sty. Frame House

Power and Telephone Lines to be relocated or adjusted by others.

FRONTAGE ROAD RIGHT  
CURVE DATA  
CURVES A & B  
P.C. Sta. 253+26.38  
P.R.C. Sta. 254+04.05  
P.T. Sta. 254+81.72  
Δ = 14° 50' 05"  
R = 300.00'  
L = 77.67'  
T = 39.05'  
Chd. = 77.46'

THOMAS T. BROOKS  
32 LA Cont. 0.027 Ac.

R/W PLAN STA. 45+00 TO STA. 60+00

A.M. Name of unknown property owner parcel 18 LA added 4-28-61  
A.M. Parcel 21 LA - Name Changed 4-28-61