


Mentor Township Lake County  
 Tract 10 Lot 5; Tract 14 Lot 1 R9W  
 Painesville Township Lake County  
 Tract 4 Lots 18 & 21 T11N R8W

REVISIONS		
A.M.	From approx. Sta. 24+40 (West), WIDTH OF S.R. 283	
	Changed from 80' to 60'	5-18-61
A.M.	Parcel 41-T. Acreage changed from 0.11 to 0.15	5-18-61
A.M.	Parcel 46. Acreage changed from 0.09 to 0.11	5-18-61

FED. NO. DIVISION	STATE	PROJECT	
2	OHIO		205 212

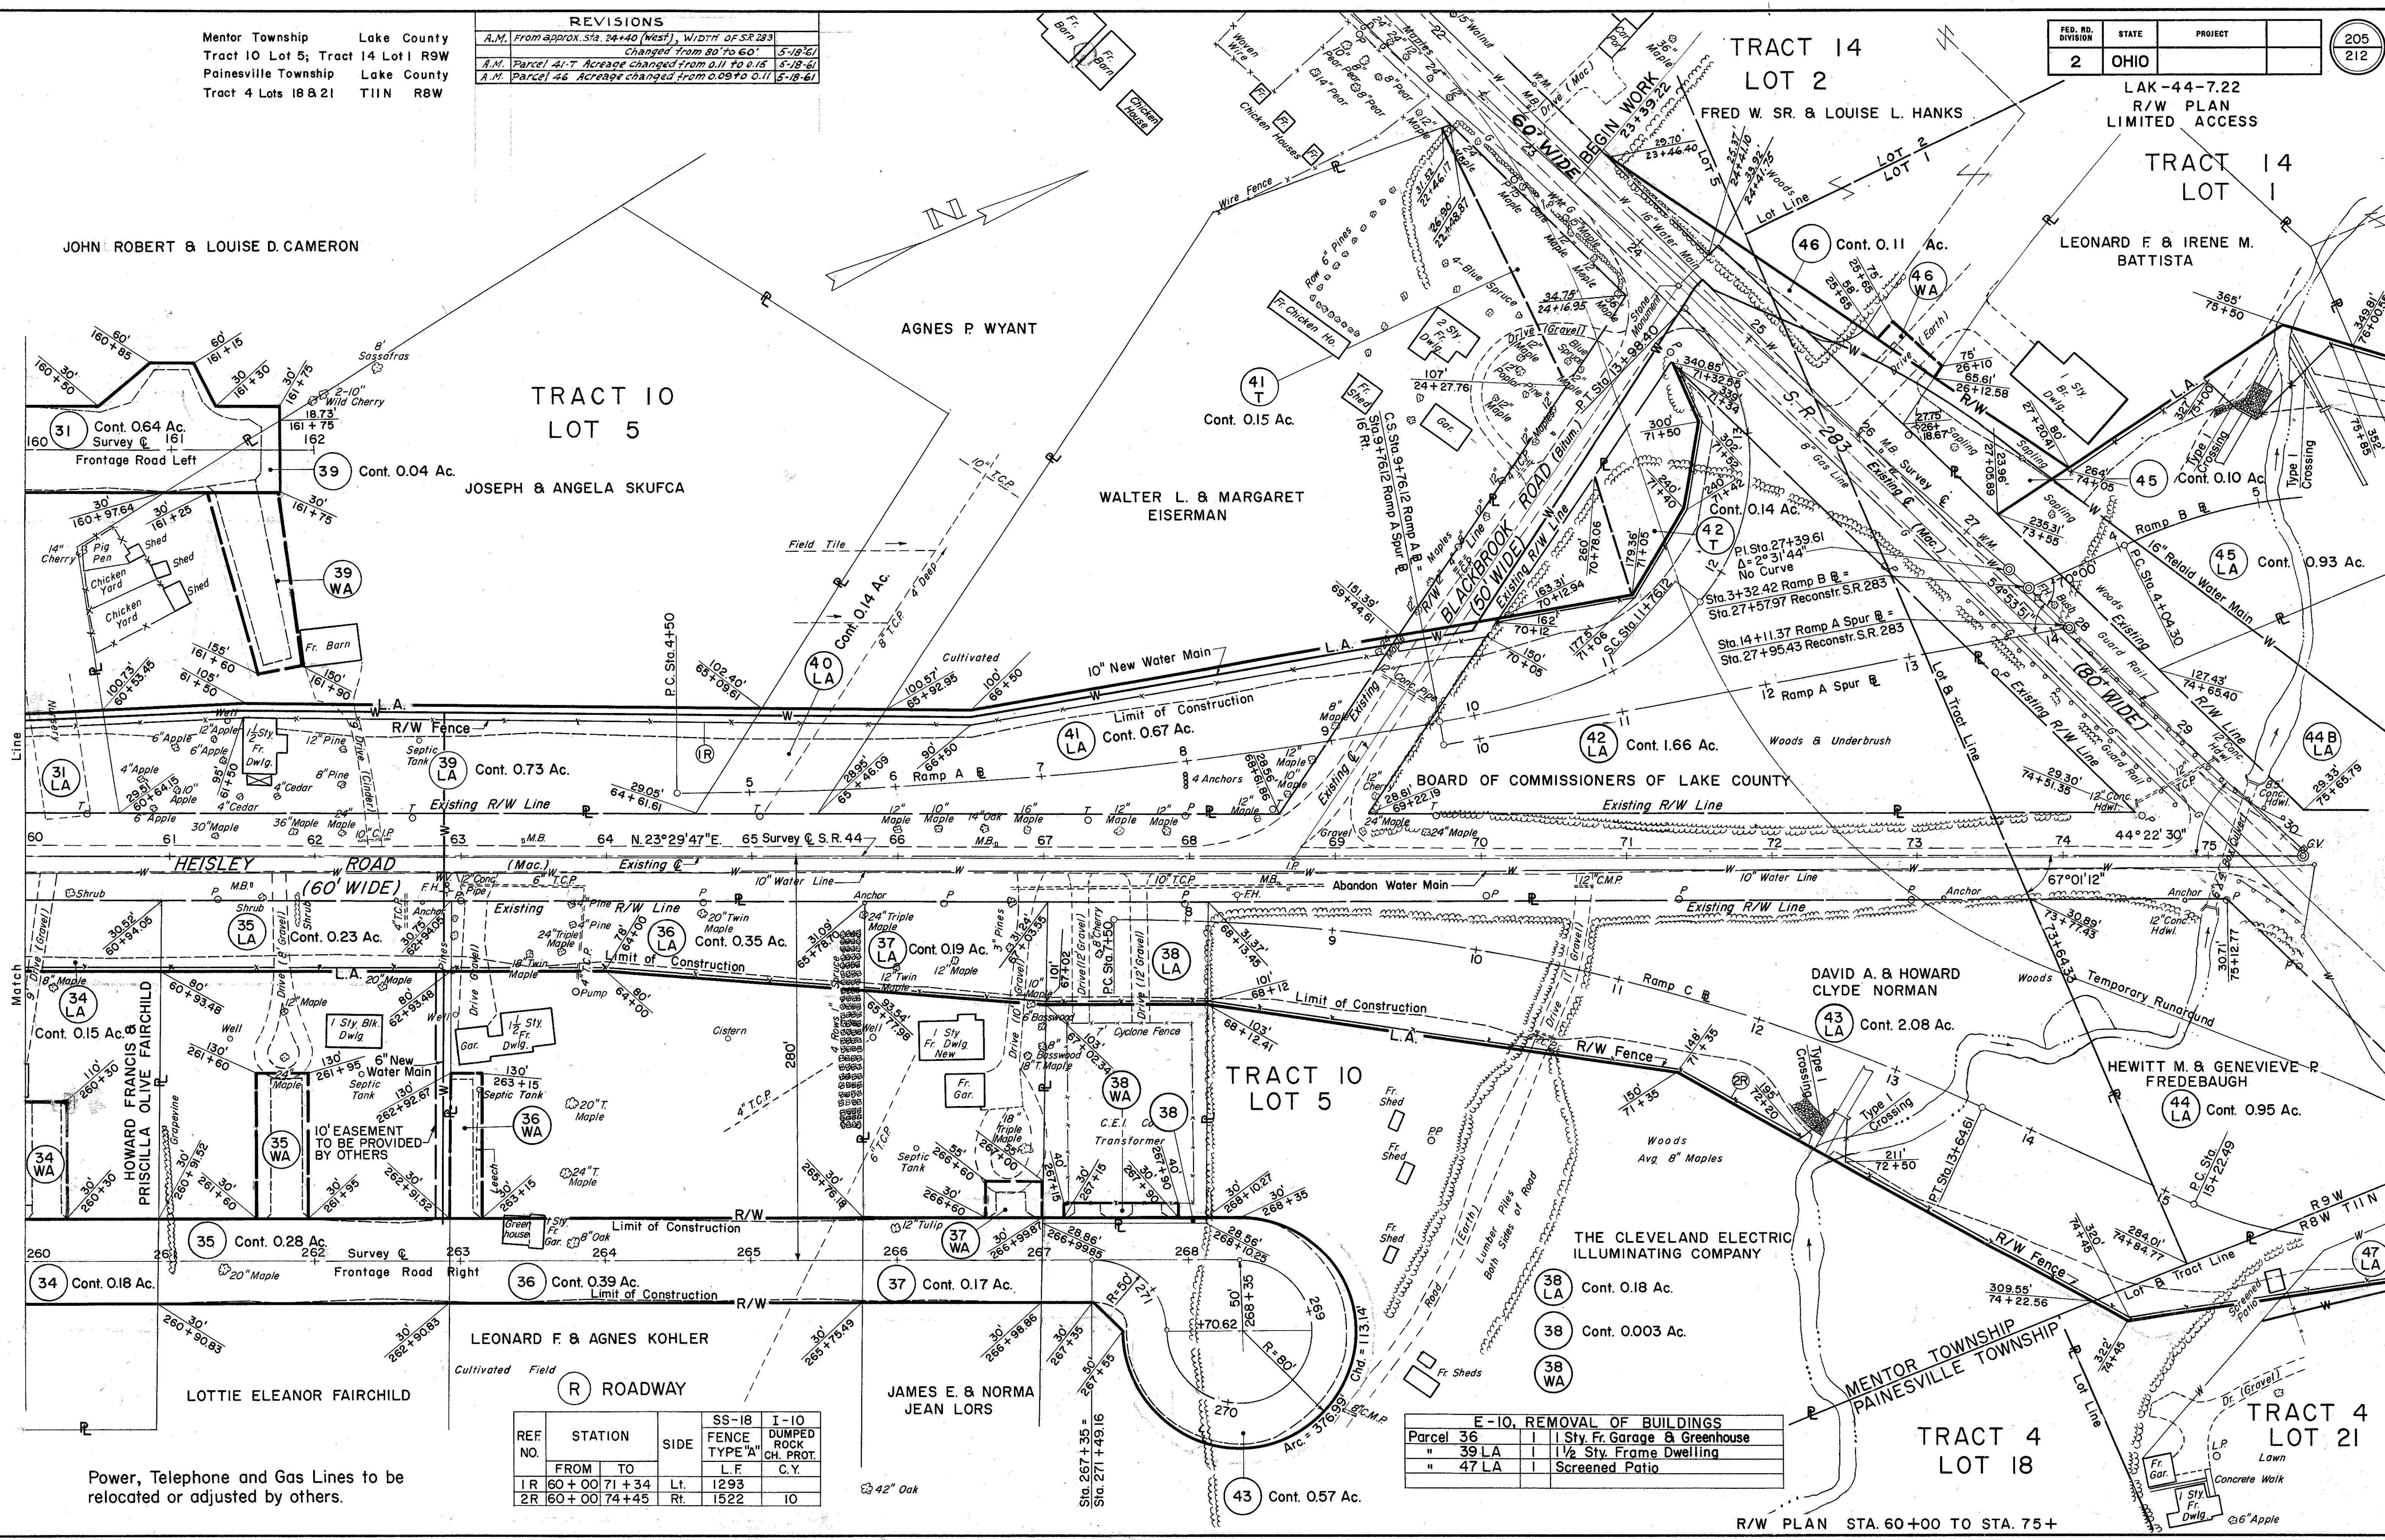

Power, Telephone and Gas Lines to be relocated or adjusted by others.

REF. NO.	STATION	SIDE	SS-18 FENCE TYPE "A"	I-10 DUMPED ROCK CH. PROT.
1R	60+00 71+34	Lt.	1293	C.Y.
2R	60+00 74+45	Rt.	1522	10

E-10, REMOVAL OF BUILDINGS		
Parcel 36	1	1 Sty. Fr. Garage & Greenhouse
" 39 LA	1	1 1/2 Sty. Frame Dwelling
" 47 LA	1	Screened Patio

R/W PLAN STA. 60+00 TO STA. 75+00