



FED. RD. DIVISION	STATE	PROJECT
2	OHIO	

LAK-44-7.22
R/W PLAN
LIMITED ACCESS

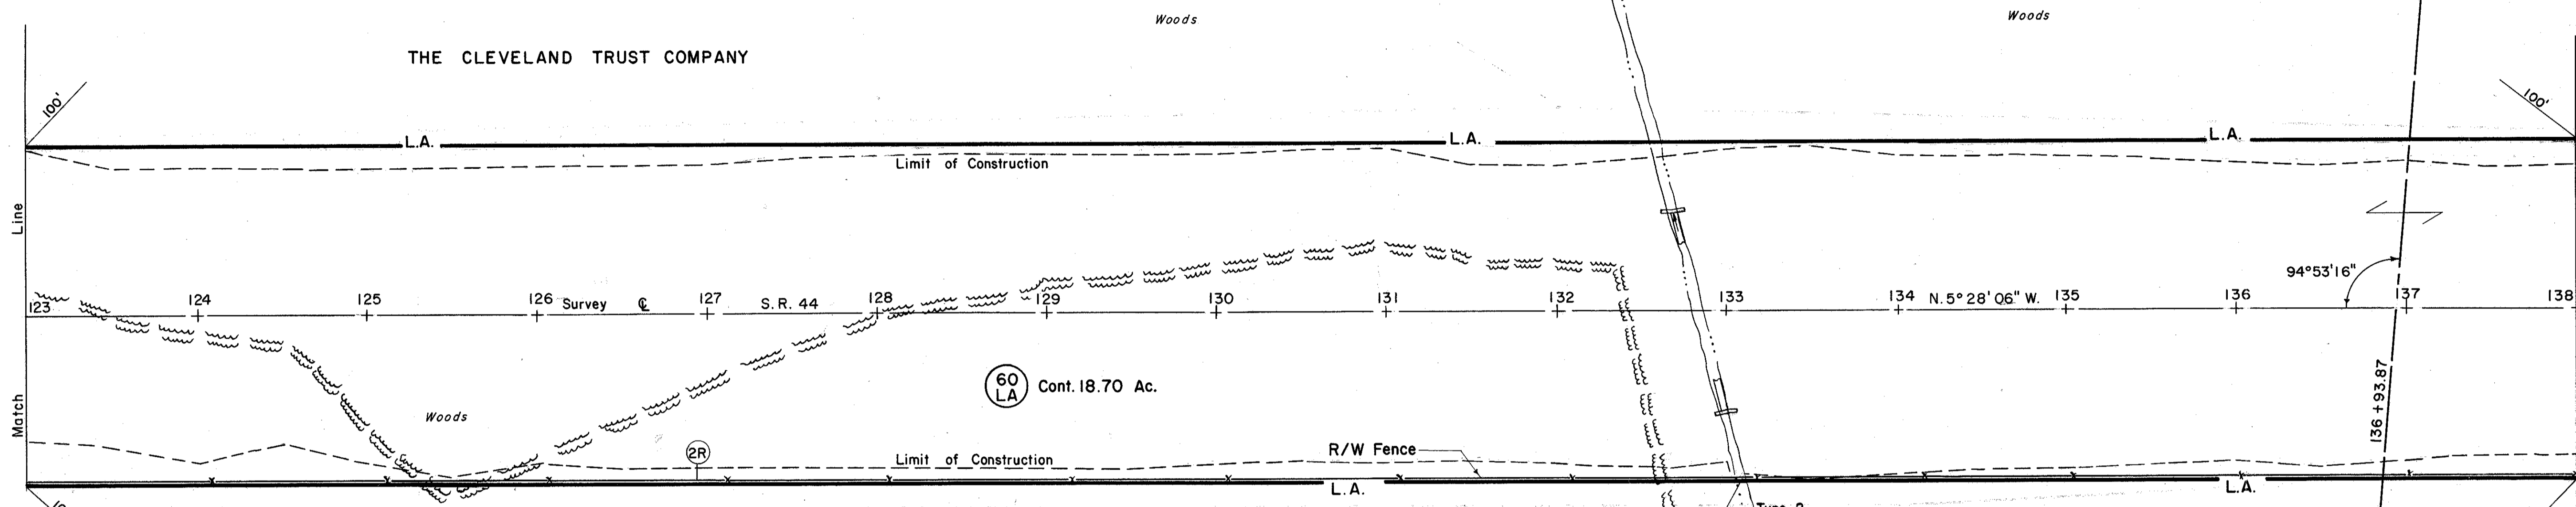

TRACT 4 O.L. 24
ROADWAY

REF. NO.	STATION		SIDE	SS-18 FENCE TYPE 'A' L.F.	I-10 DUMPED ROCK CH. PROT. C.Y.
	FROM	TO			
2 R	123+00	138+00	Rt.	1500	10

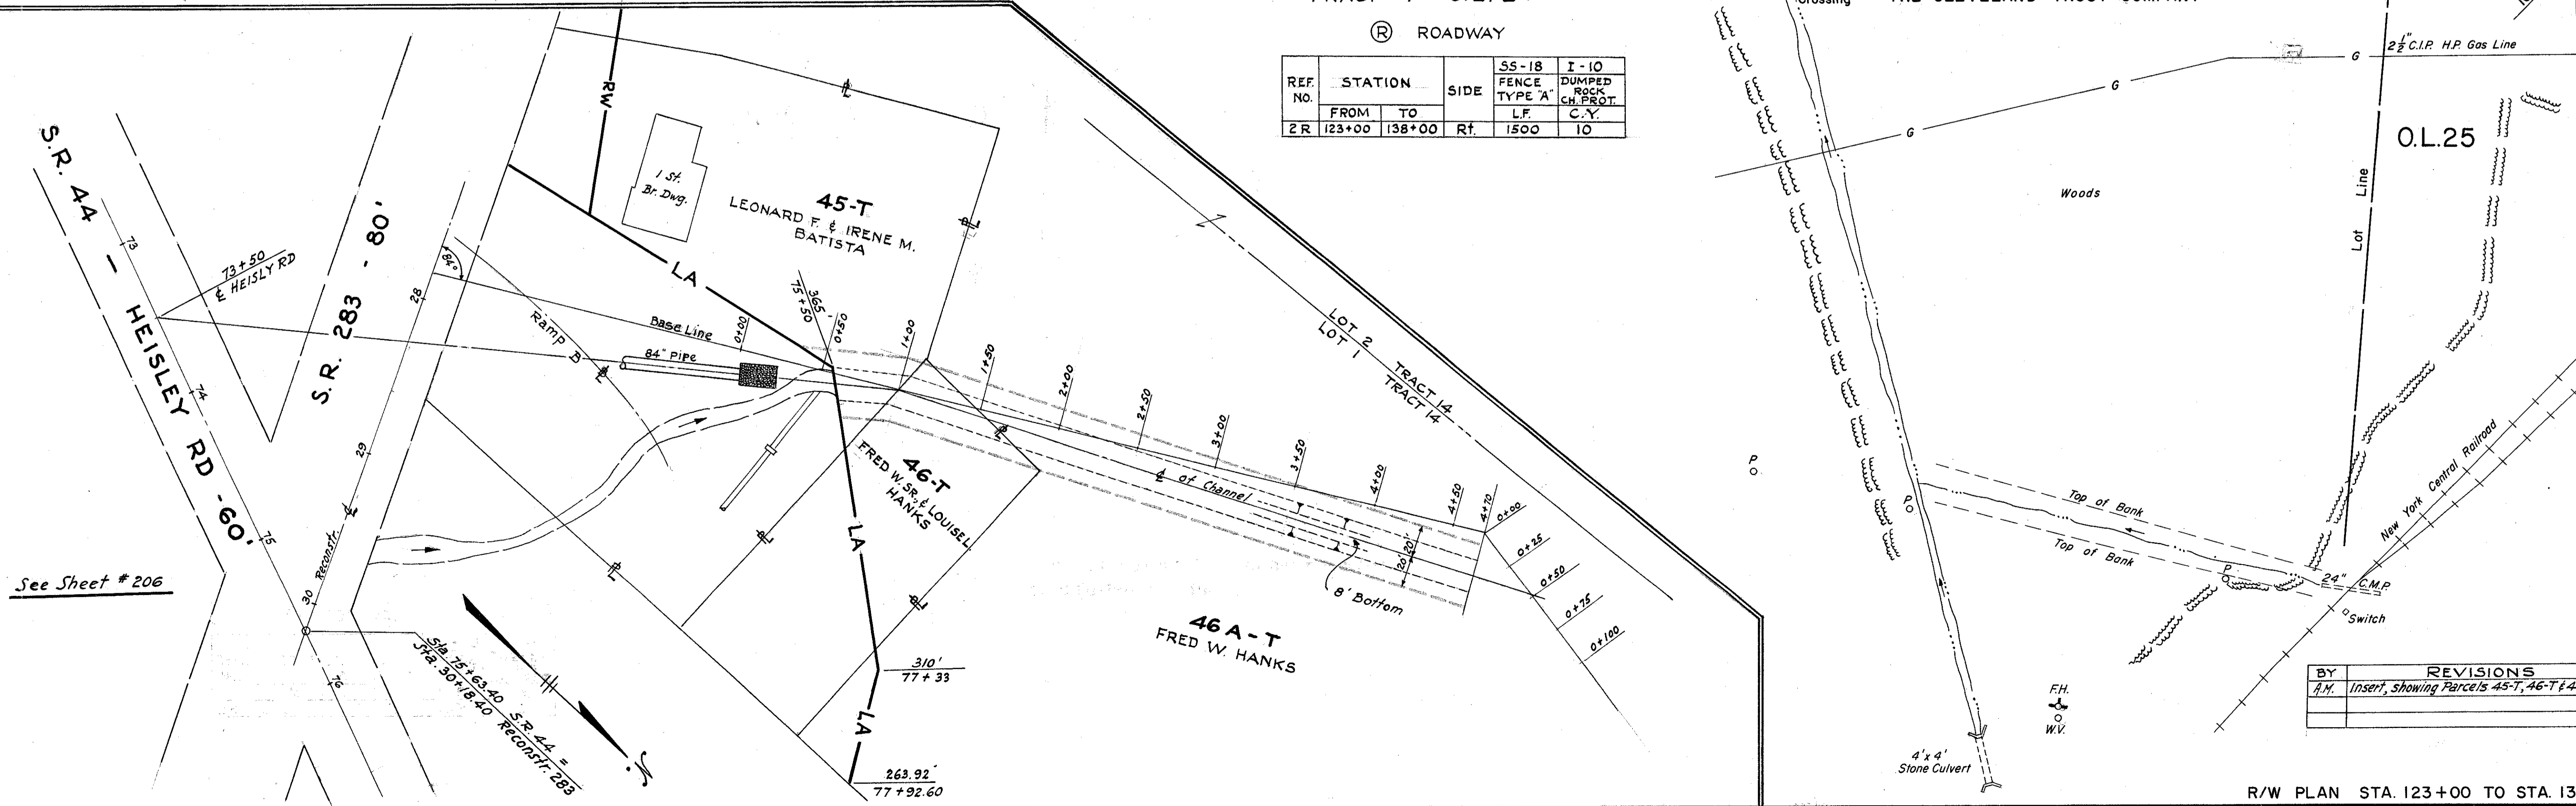

See Sheet # 206

BY	REVISIONS	DATE
A.M.	Insert, showing Parcels 45-T, 46-T & 46A-T, added.	8-3-62