


120 110 100 90 80 70 60 50 40 30 20 10 0 10 20 30

LAK-535-(0.20-0.53)
LAKE COUNTY

SEEDING & SODDING	
WIDTH	AREAS
LIN. FT.	Sq. Yds.
41	225
40	250
50	297
57	328
61	317
53	247
36	

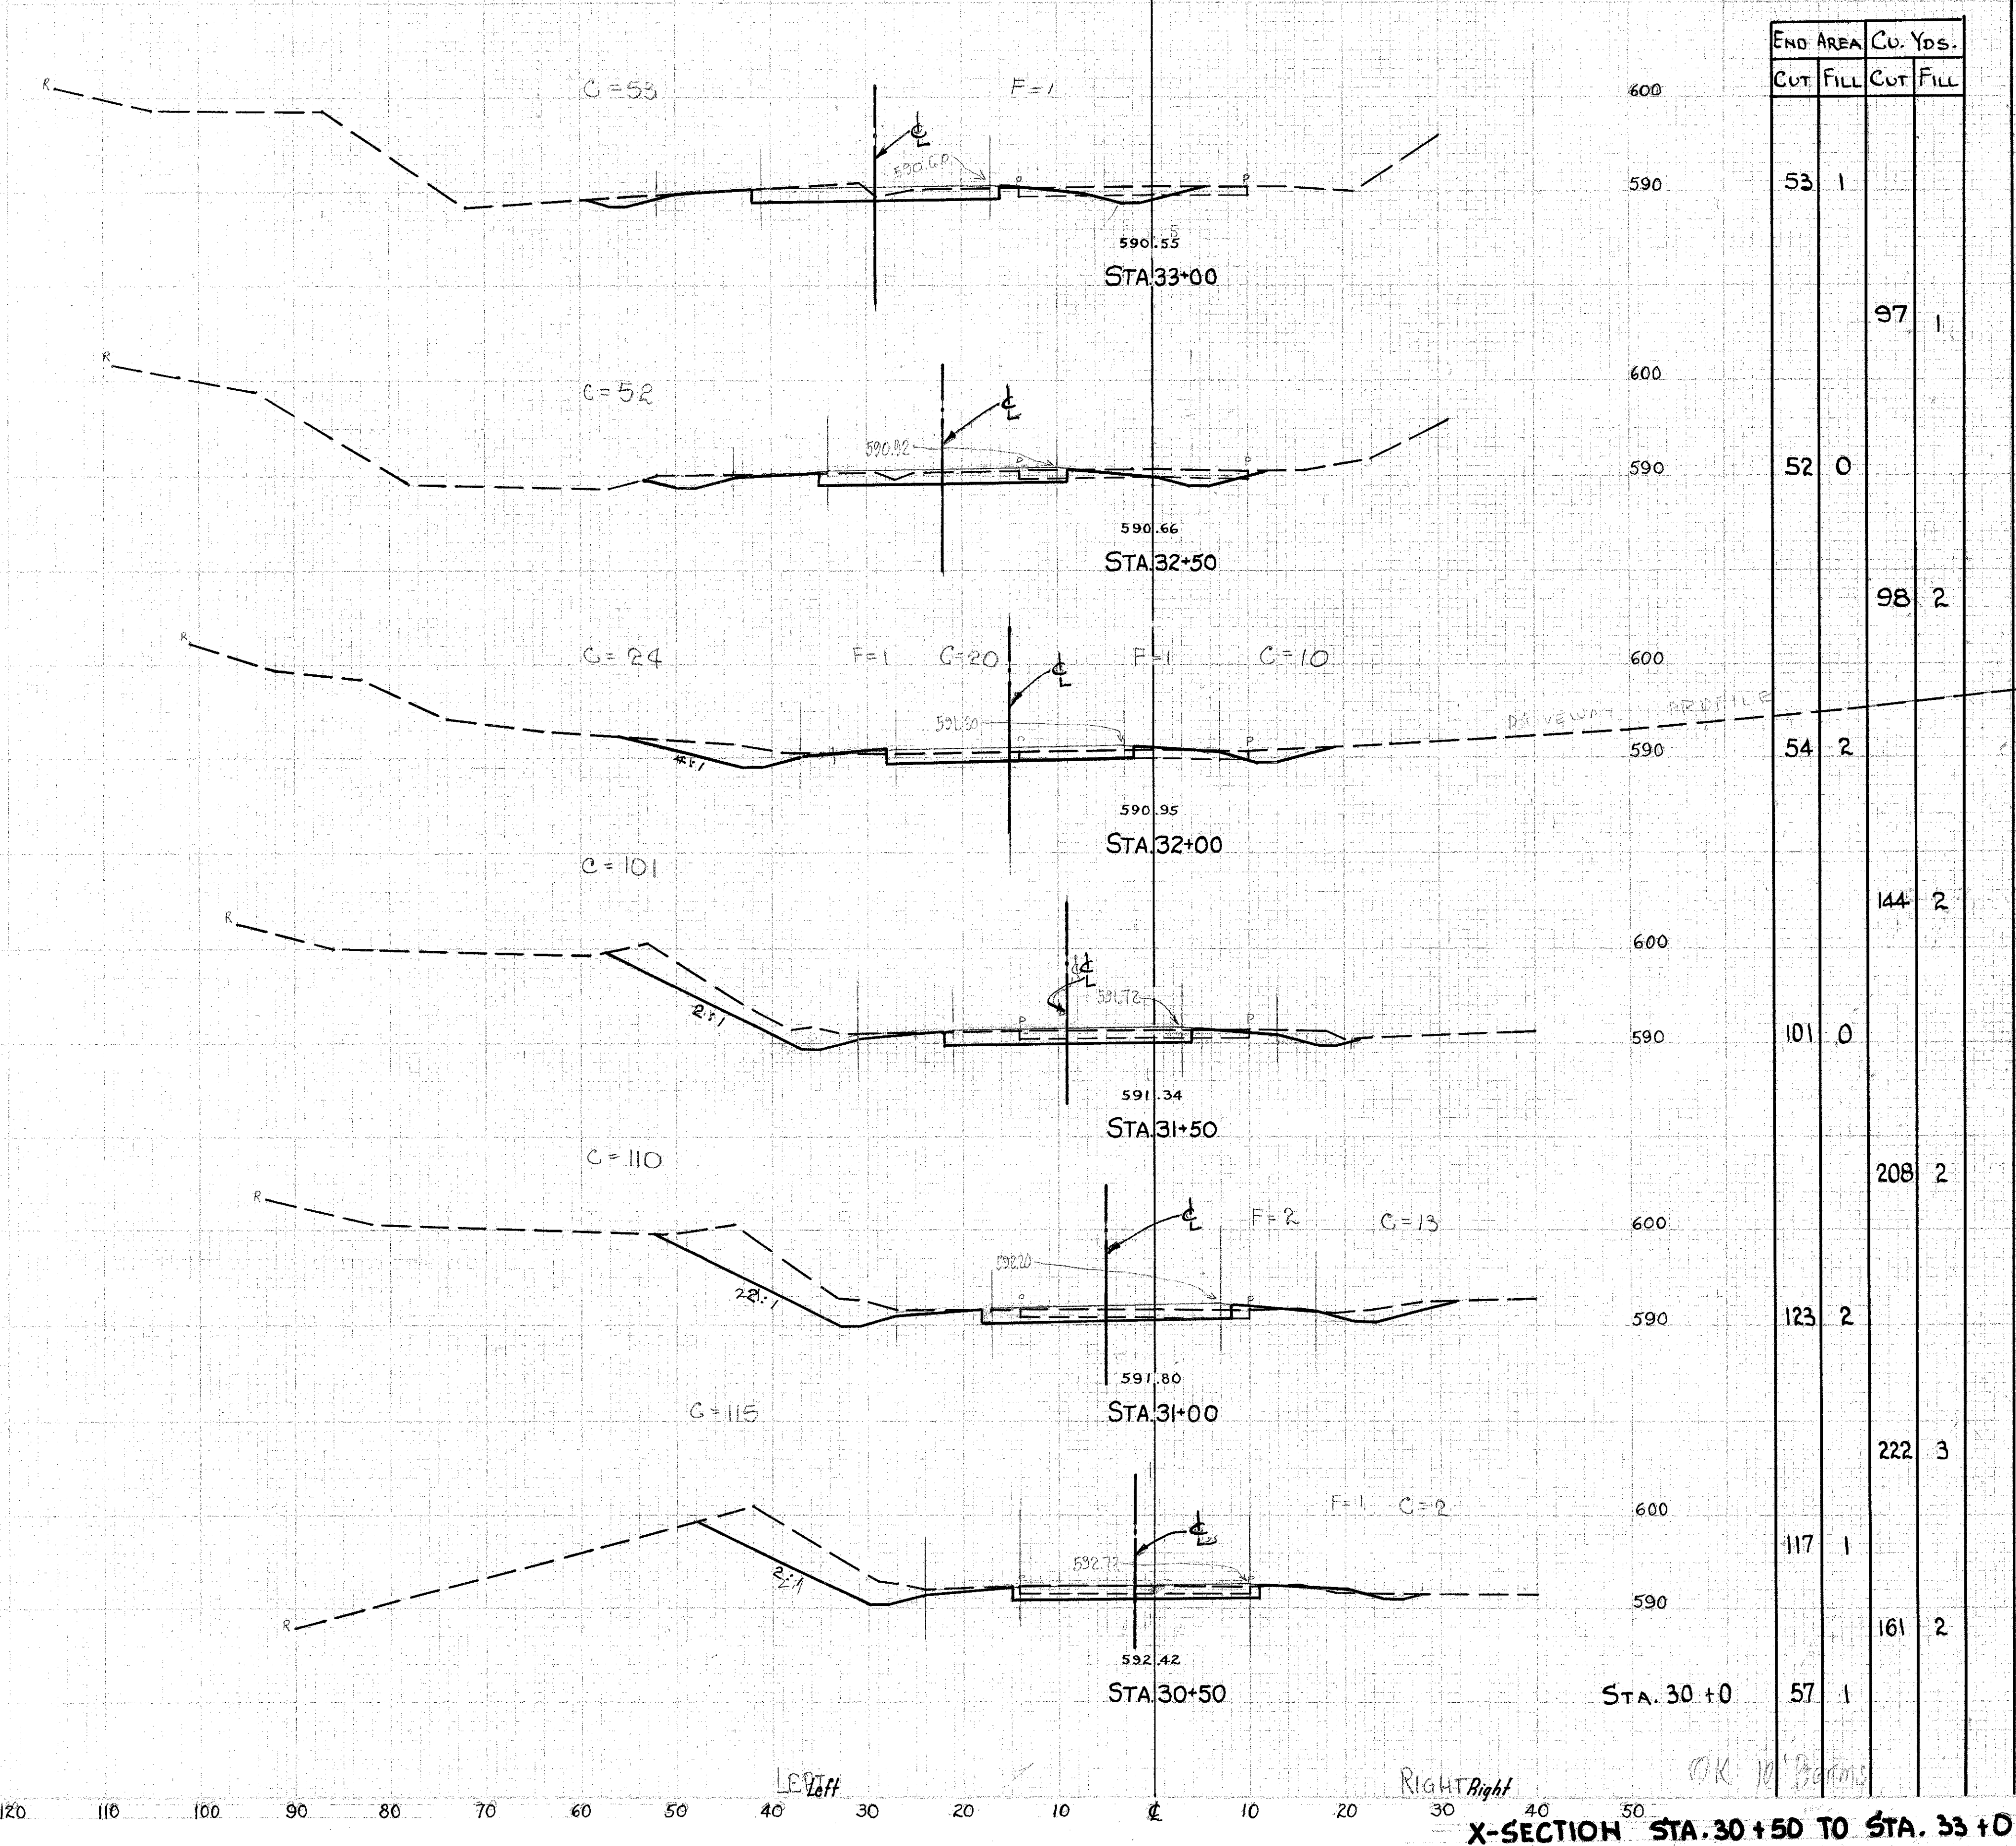

Left

Right

OK 10' Berms

X-SECTION STA. 30+50 TO STA. 33+0