


CALC BY: *KS*
 DATE: *2/28/84*
 CHKD BY: *KS*
 DATE: *3/8/84*

LAK - 535 - 0.42
 HIGH STREET / WATER STREET

OHIO
 FHWA
 REGION 5

115
 225

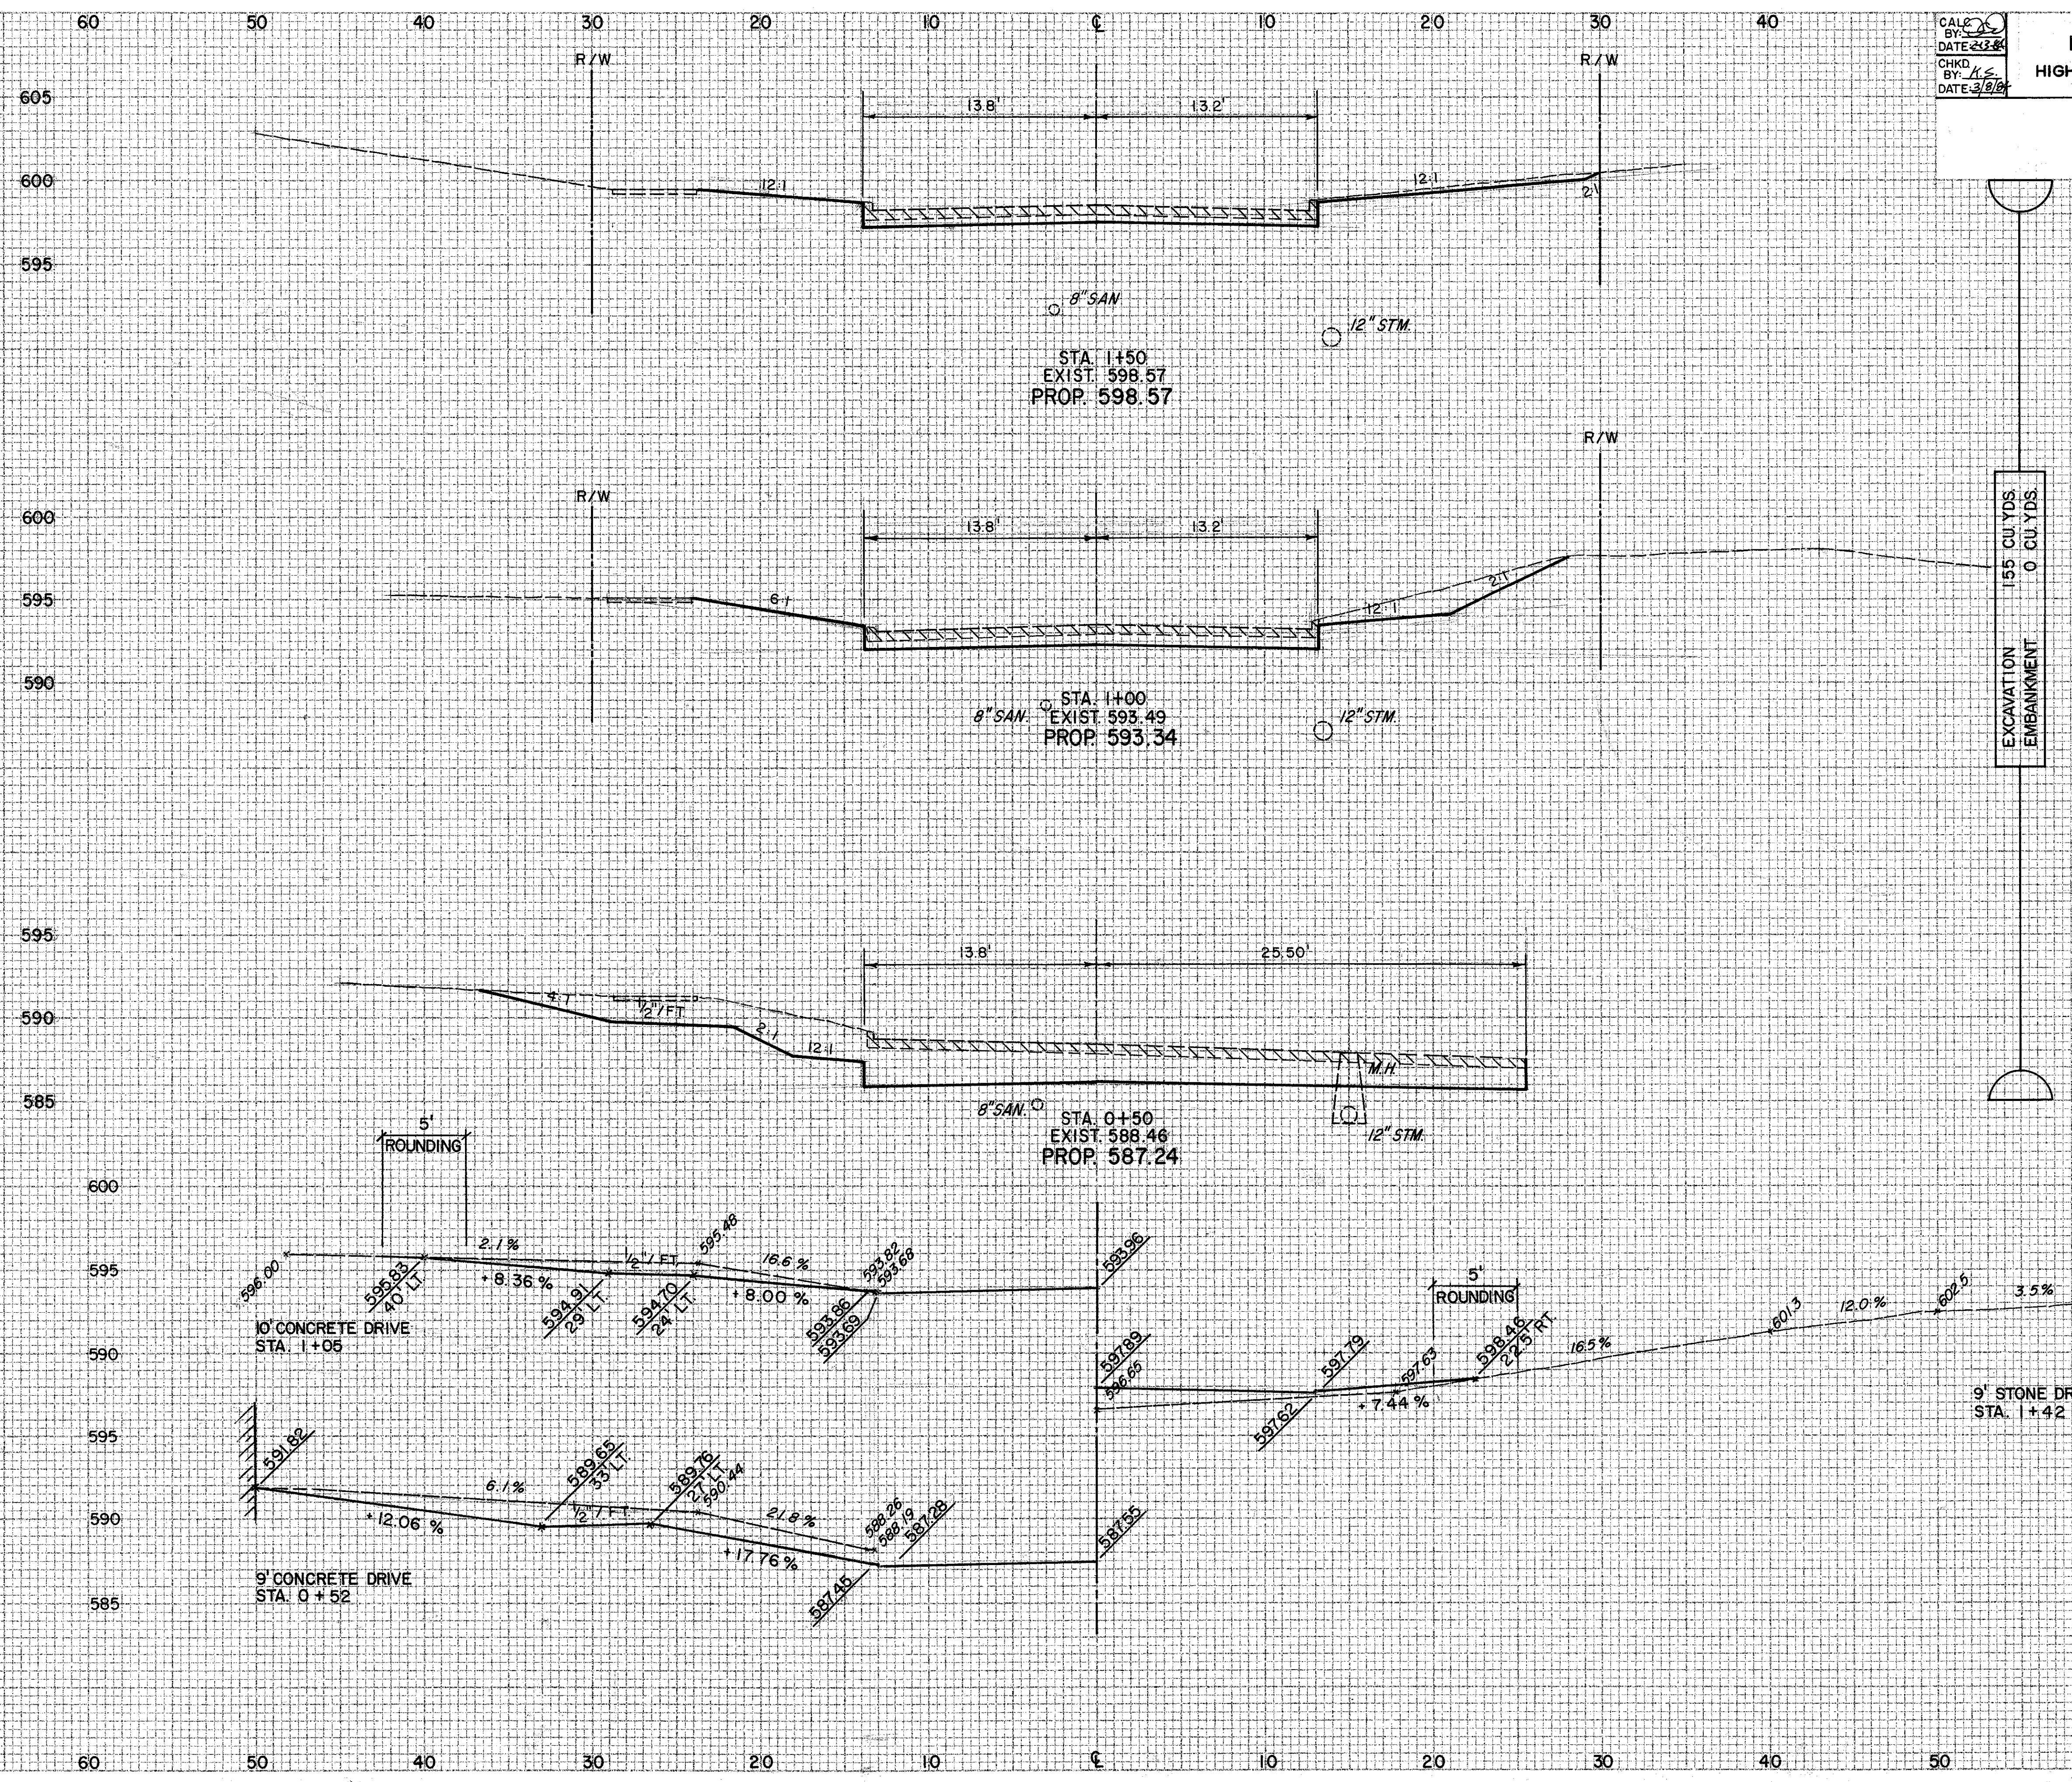

ELEVATION	END AREA		VOLUME	
	CUT	FILL	CUT	FILL
595	13.1	0		
600			377	0
595	276	0		
590			116.6	0
585	98.3	0		

EXCAVATION
 EMBANKMENT
 155 CU YDS
 0 CU YDS

FINAL SURVEY
 DATE: *2/28/84*
 BY: *KS*
 CHECKED BY: *KS*
 DATE: *3/8/84*

ORIGINAL SURVEY
 DATE: *2/28/84*
 BY: *KS*
 CHECKED BY: *KS*
 DATE: *3/8/84*

BURTON STREET