


60 50 40 30 20 10 0 10 20 30 40

FINAL SURVEY PLOTTED
 NOTE BOOK, REPAIR, AREA, DIMENSIONS

ORIGINAL SURVEY PLOTTED
 NOTE BOOK, REPAIR, AREA, DIMENSIONS

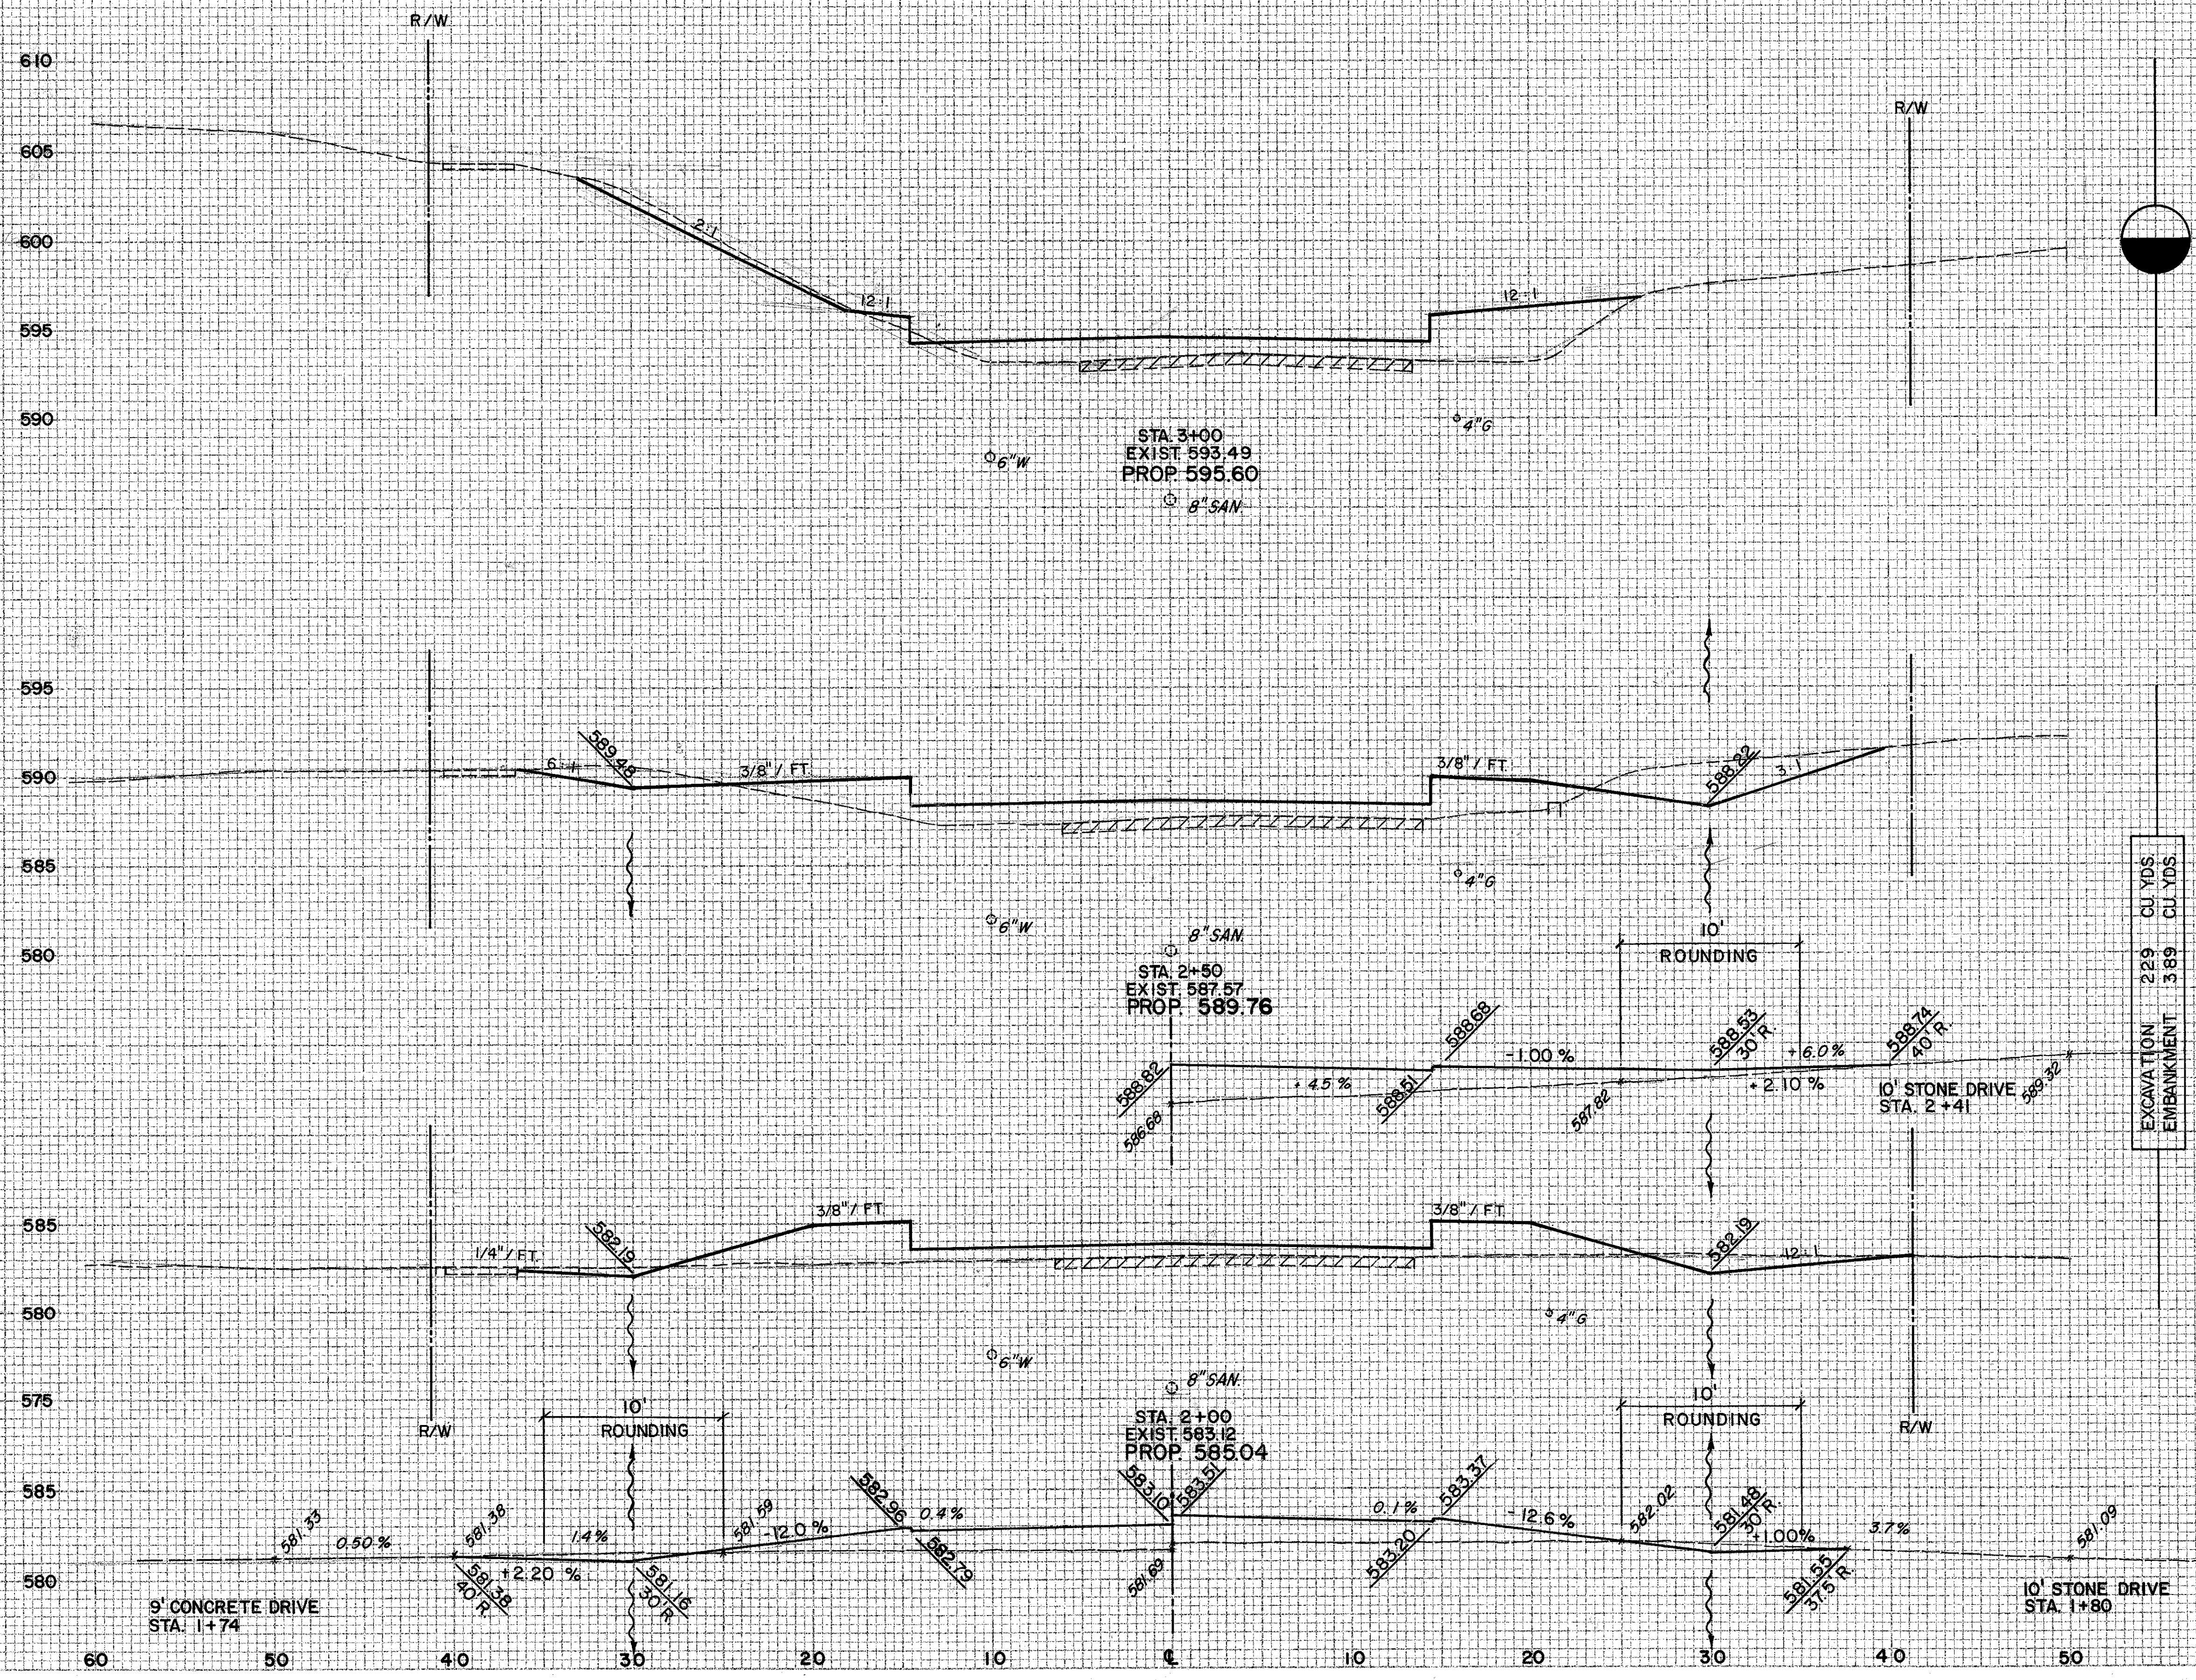

END AREA		VOLUME	
CUT	FILL	CUT	FILL
76	684		
		35.6	125.2
30.8	66.8		
		38.1	126.5
10.3	69.8		
		31.1	94.4

EXCAVATION 229 CU YDS
 EMBANKMENT 389 CU YDS

SECOND STREET