

LOOP WIRE CONSTRUCTION	
LOOP PERIMETER	NUMBER OF TURNS
LESS THAN 40 FEET	3
40 TO 160 FEET	2
OVER 160 FEET	1






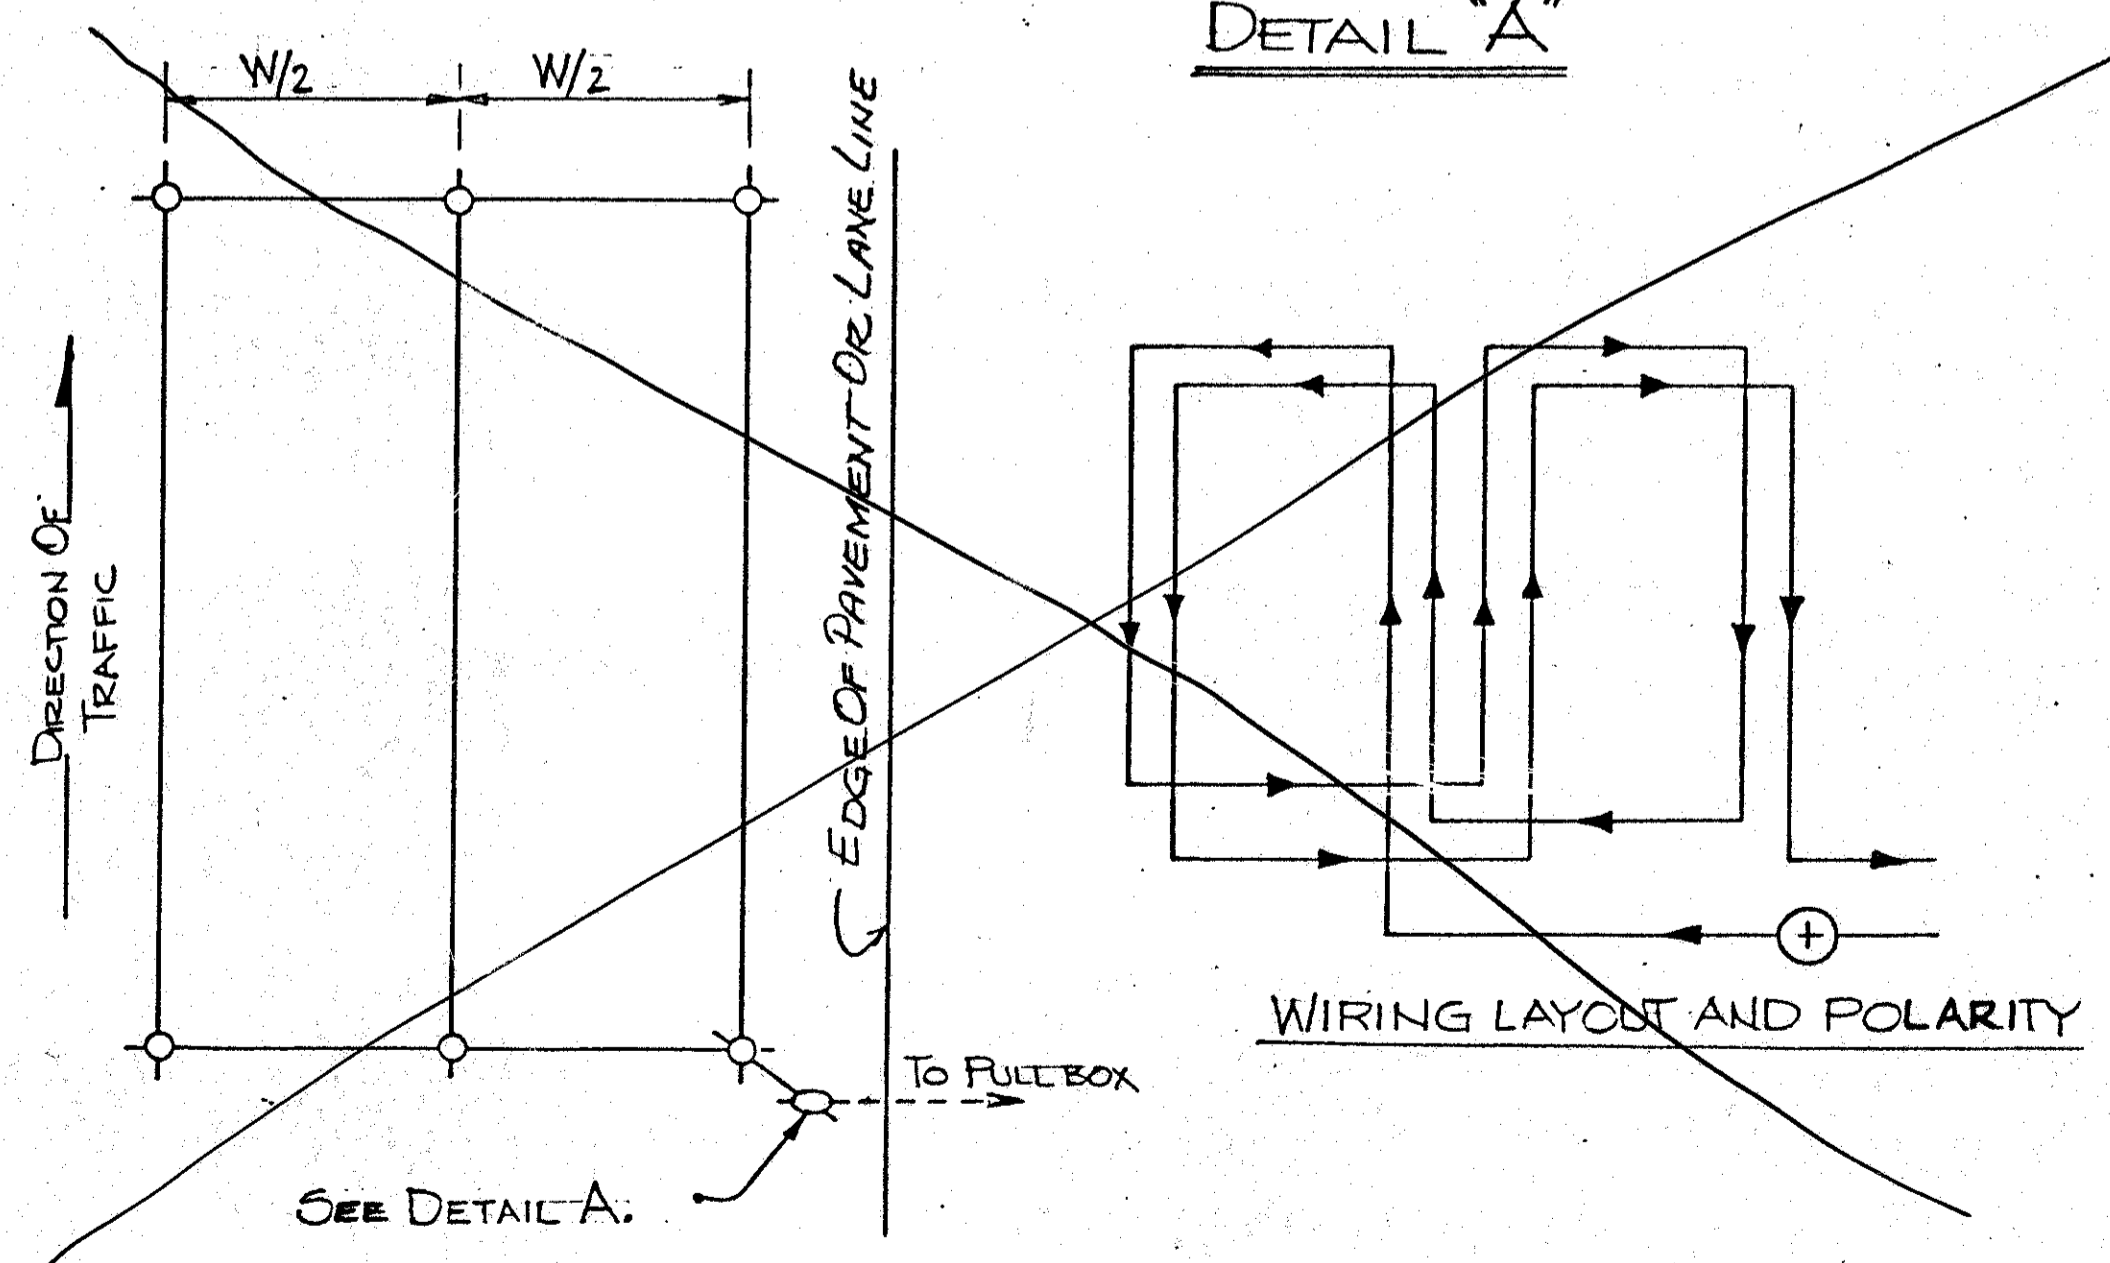


FIGURE 8 LOOP DETAILS

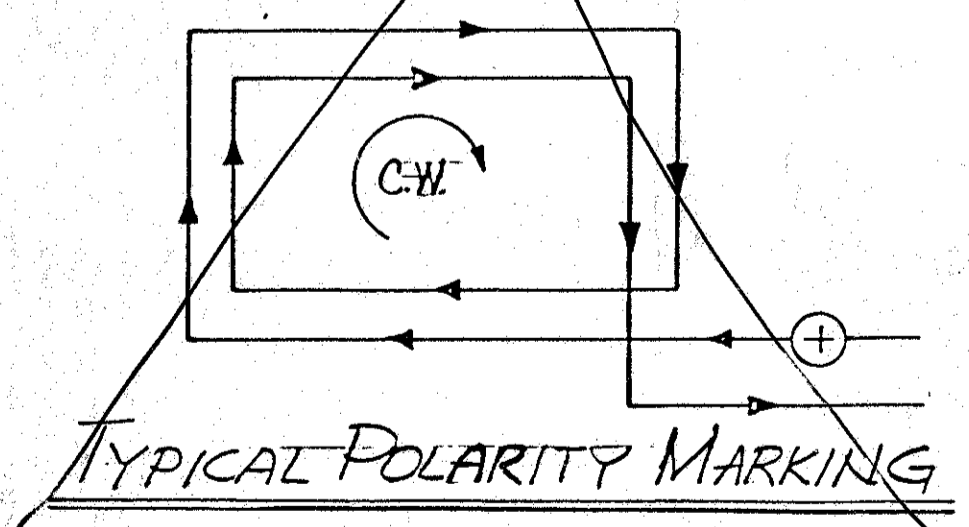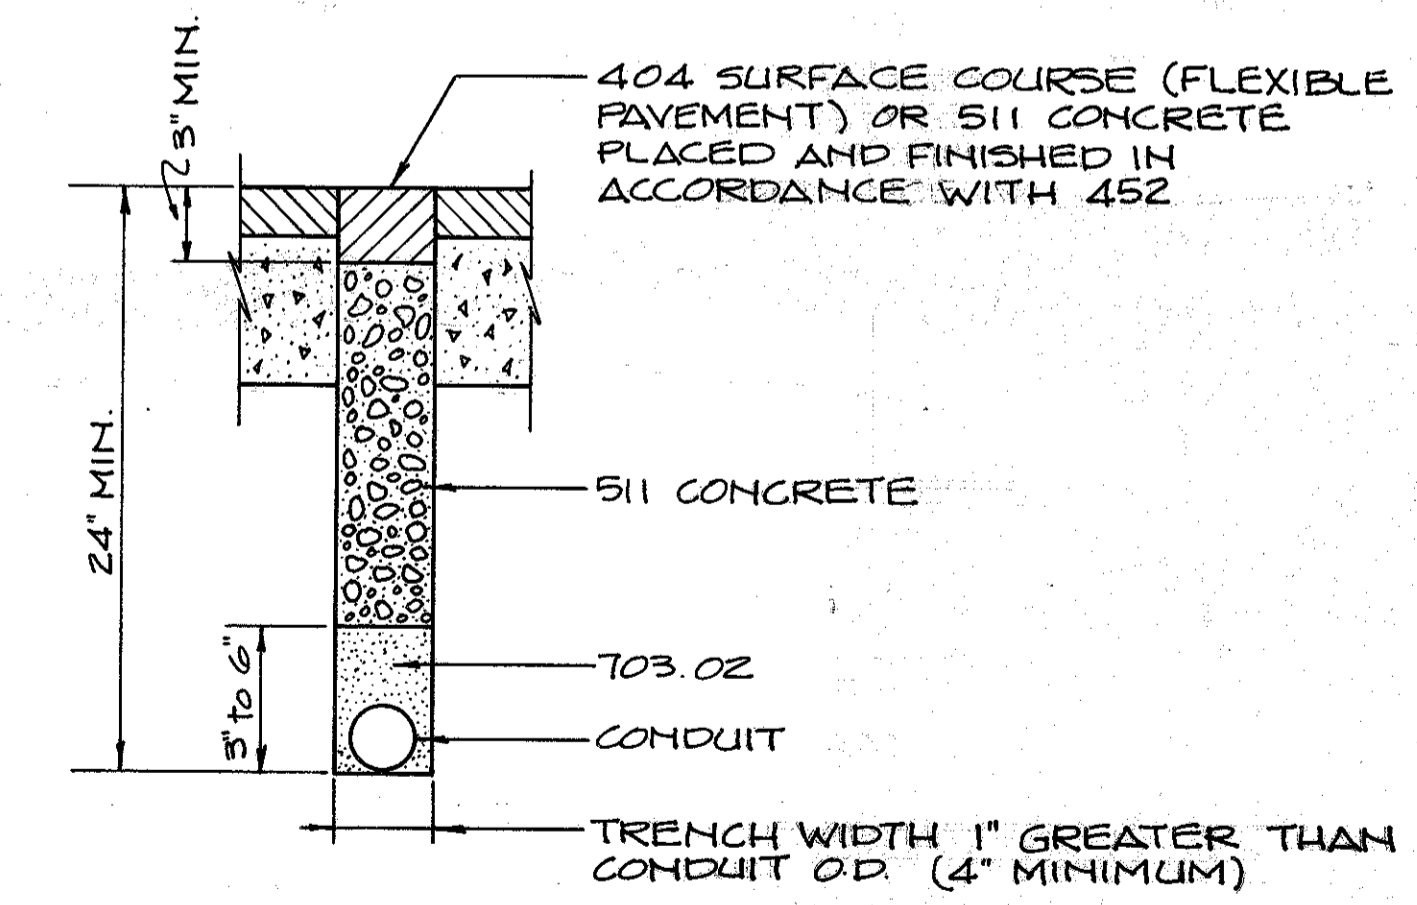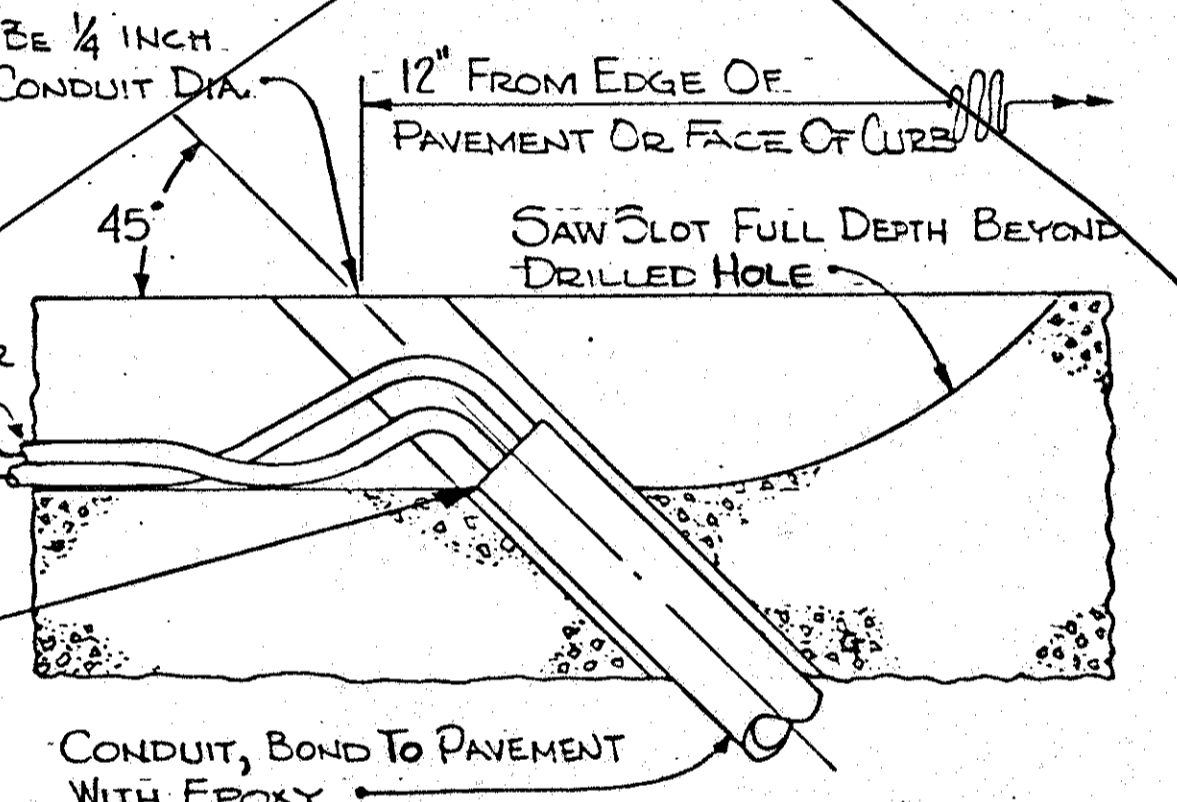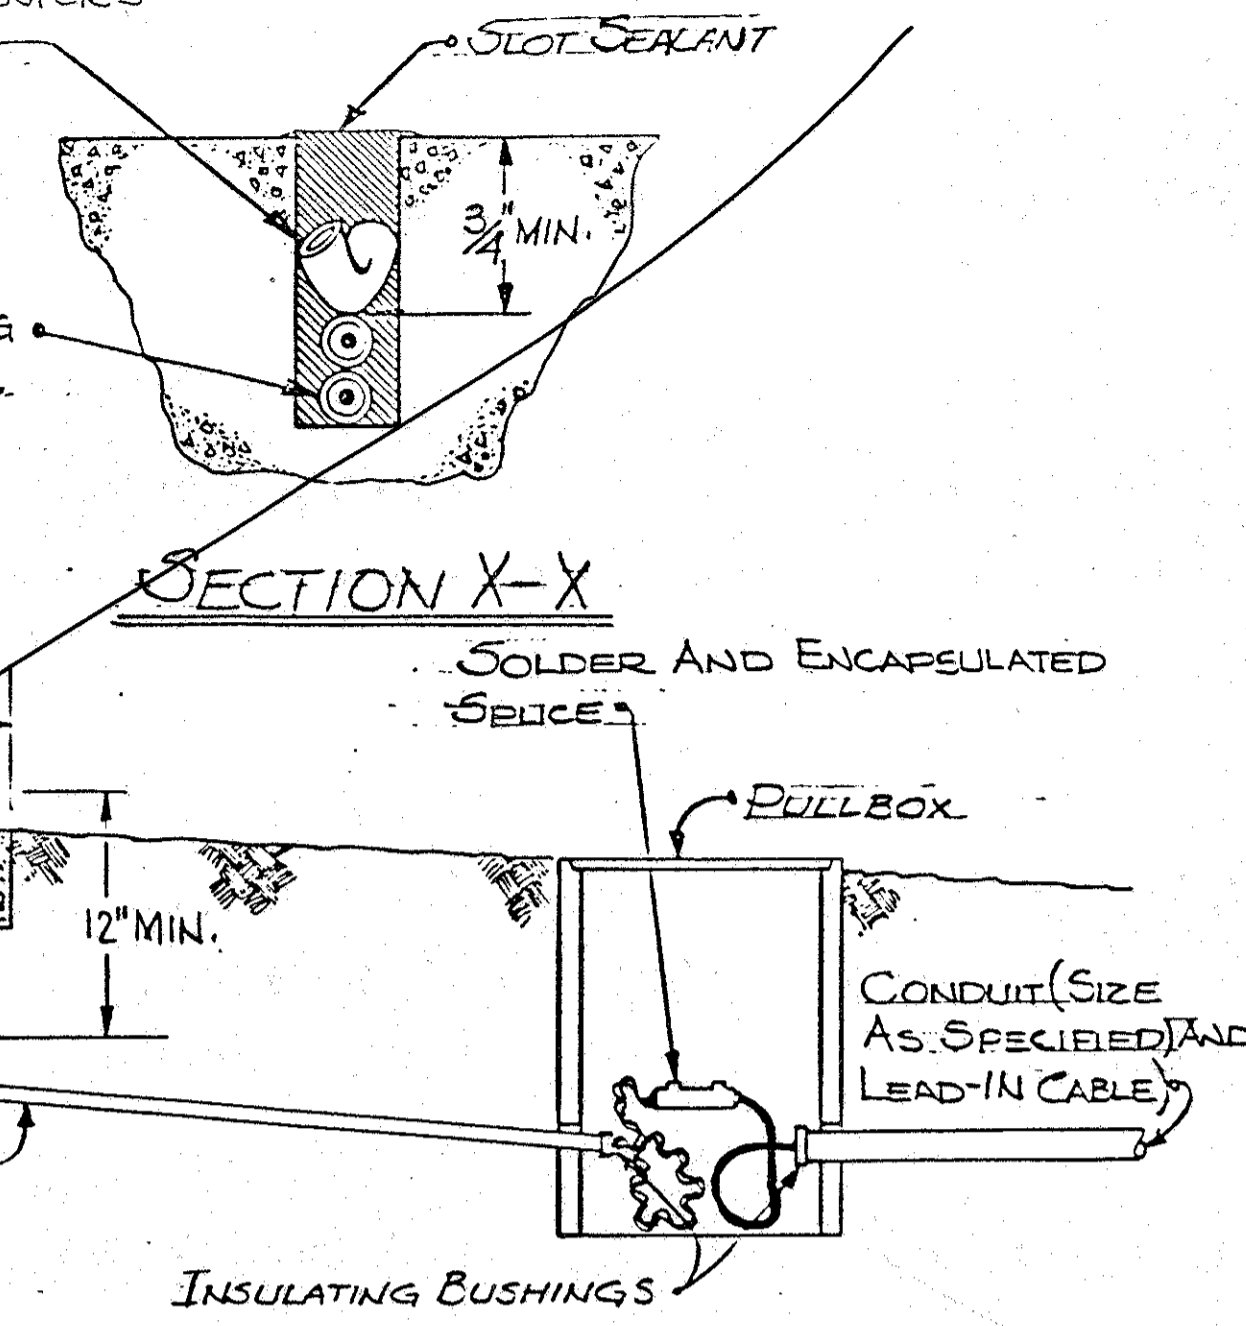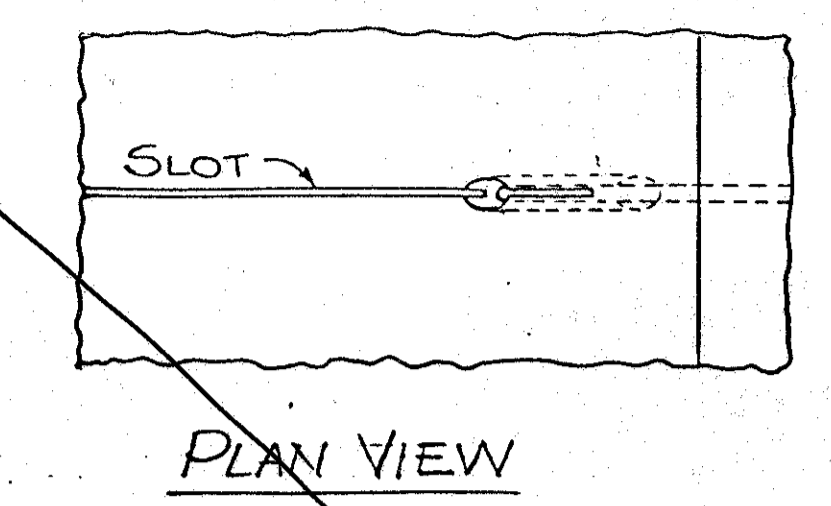

NARROW SLIT TYPE TRENCH