FEDERAL AID

2	F-366(1)	POST WAR	54	97

LAKE COUNTY
LAK.-6-(3.60-3.76)

SEEDING SODDING		
WIDTH LIN. FT.	AREA SQ. YDS.	
143		770 Foward
170		760 Backward
		750
		740
		730
		720
	356	
		770
		760
98		750
		740
		730
	107	720
0		Sta 251+75

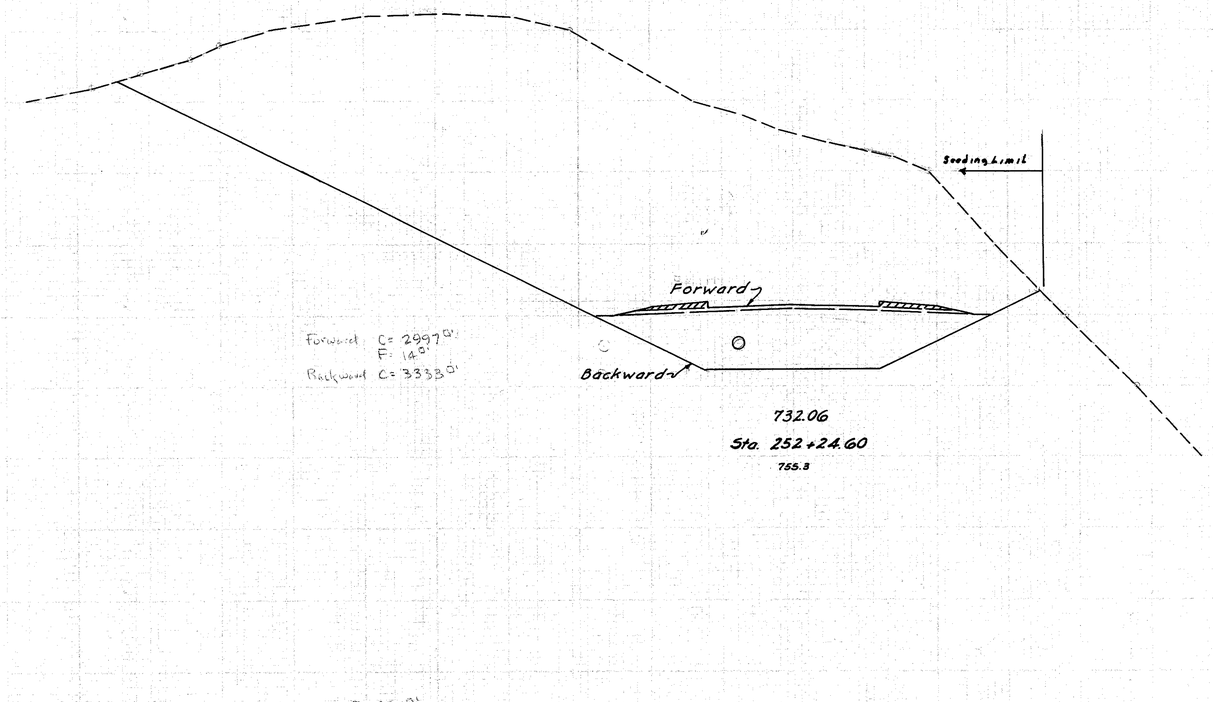

	END AREA CUT	END AREA FILL	CU. YDS. CUT	CU. YDS. FILL
760				
Foward 750	2997	14		
Backward 740	3333	0		
730				
720				
710				
			1983	0
730				
720	1020			
710				
700		378	0	
690				
	0	0		

CROSS SECTIONS STA. 252+00 TO STA. 252+24.60