


Seeding		Sodding	
Width	Area	Width	Area
Lin. Ft.	Sq. Yds.	Lin. Ft.	Sq. Yds.
75			
	708		
72			
	356		
56			
	211		
20			
	134		
28			

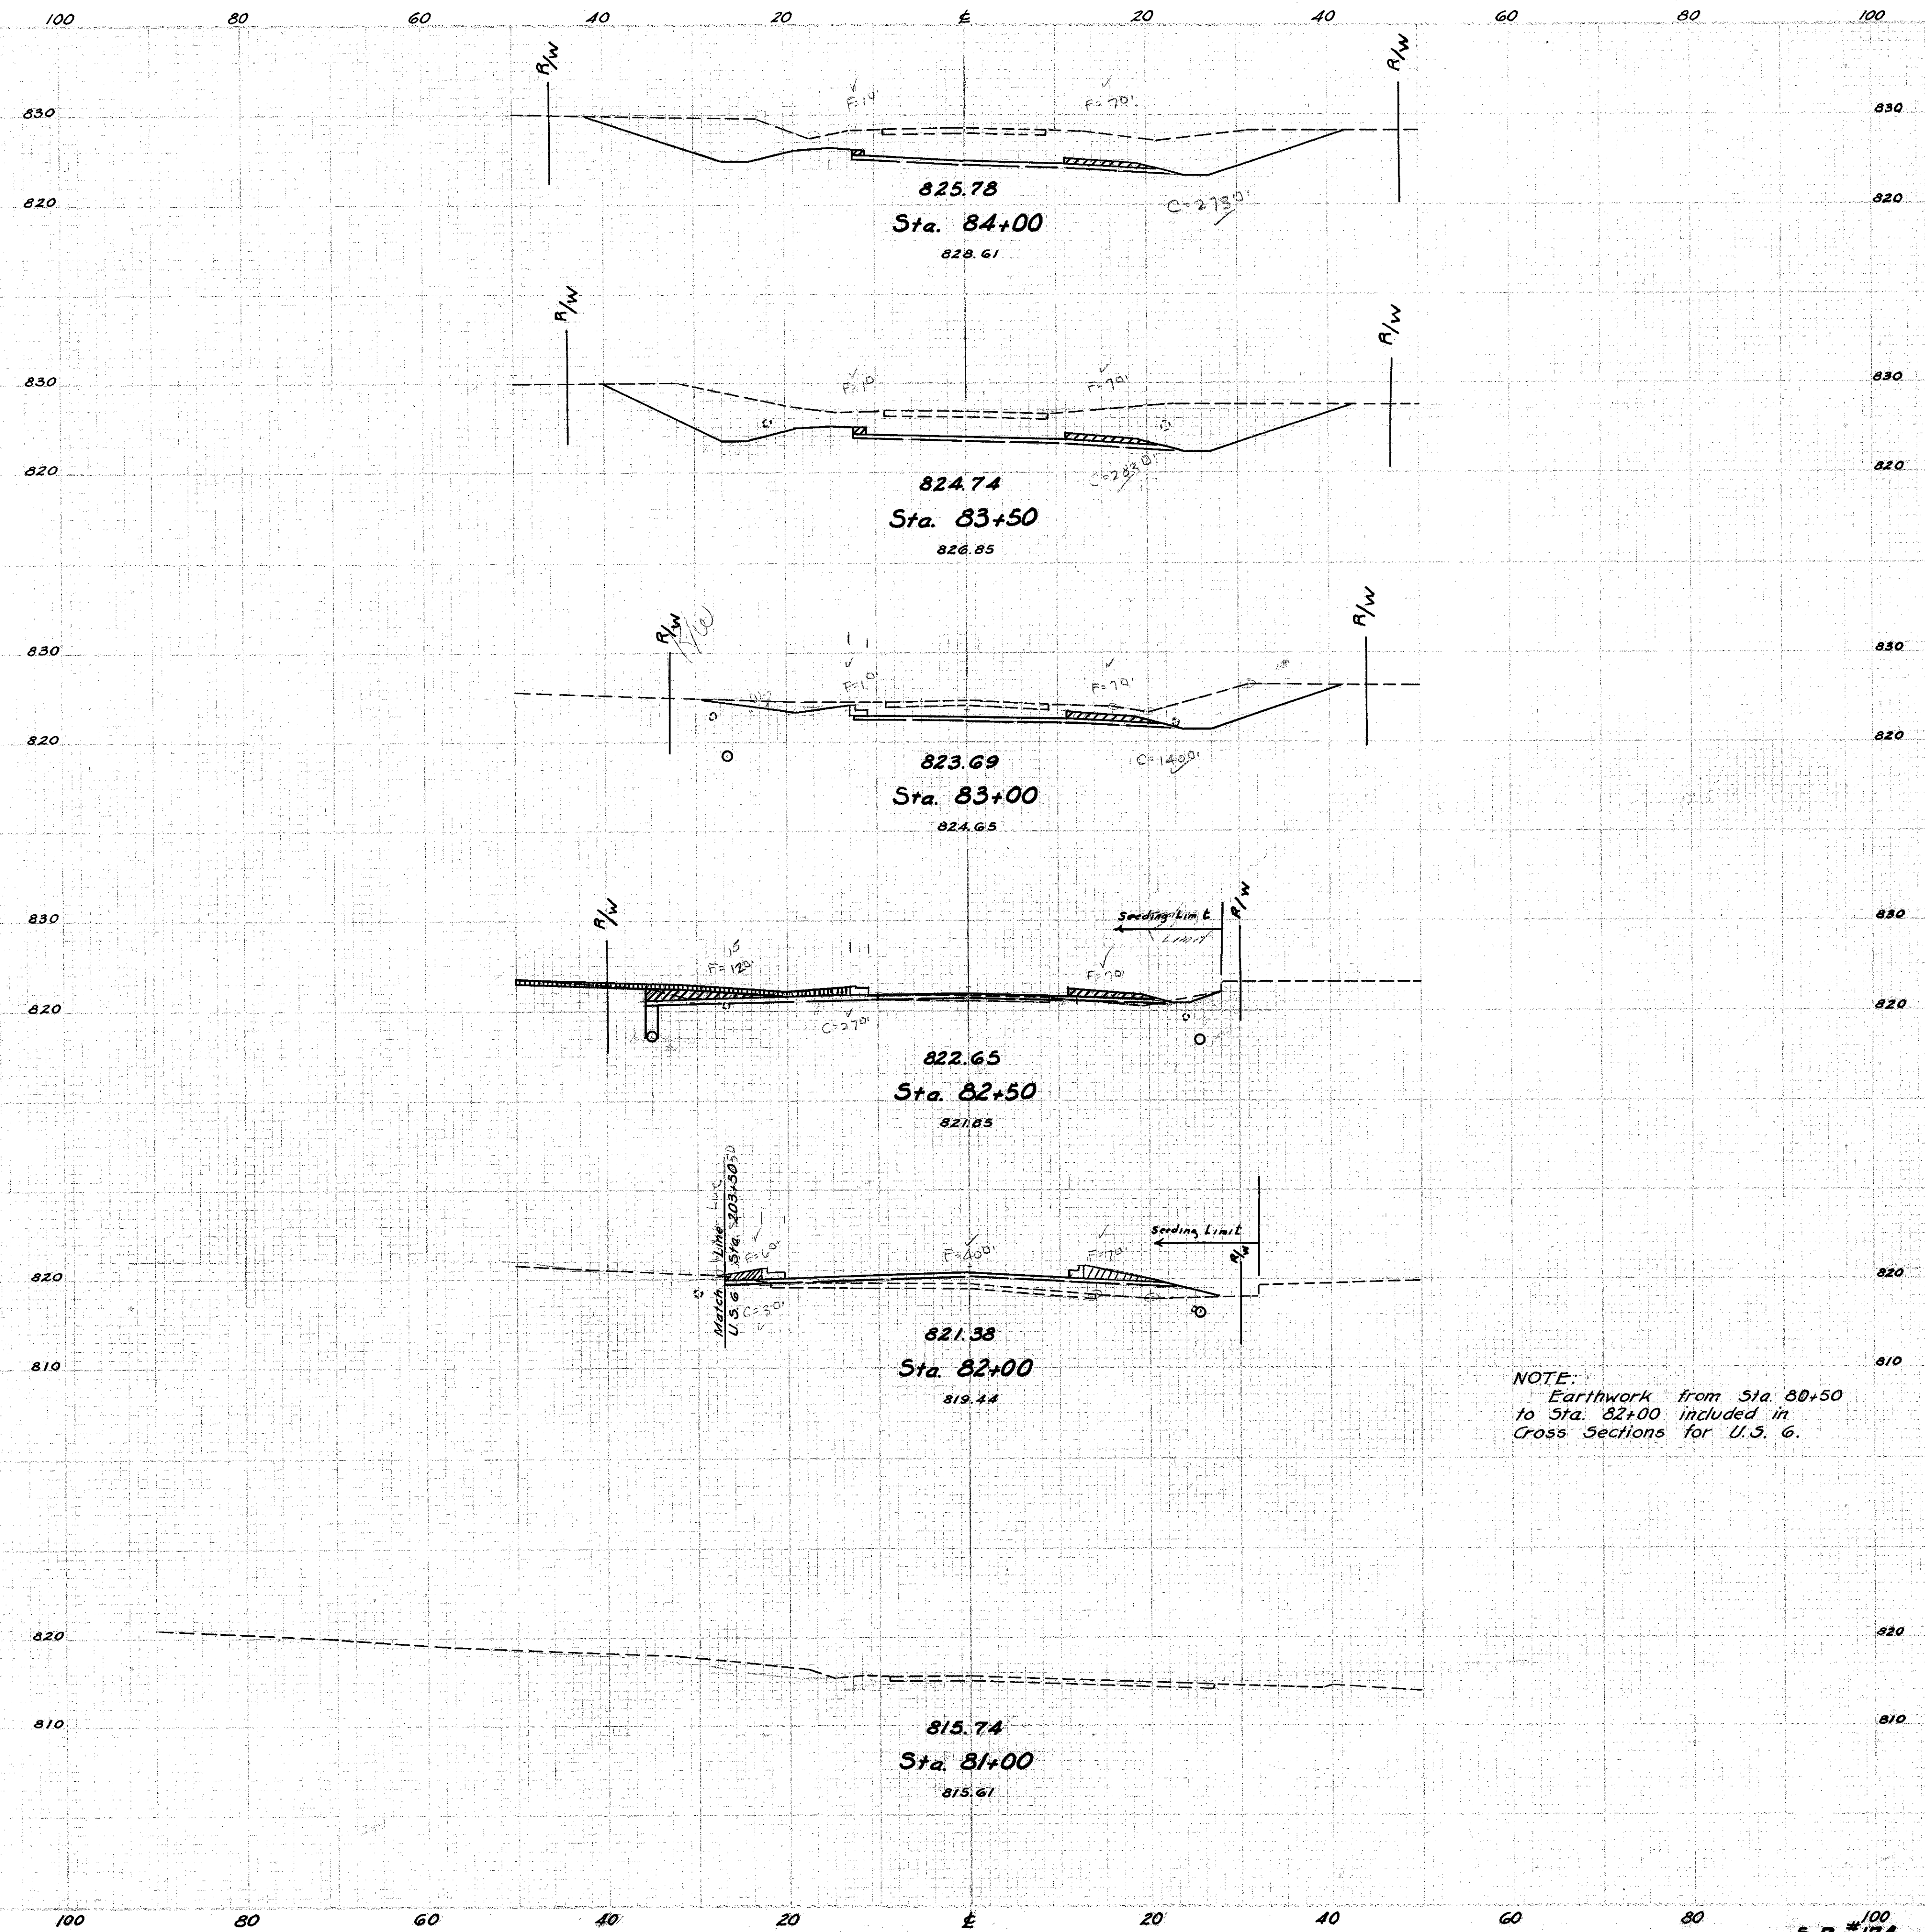

END AREA		CU. YDS.	
CUT	FILL	CUT	FILL
273	8		
		515	15
283	8		
		392	15
140	8		
		157	25
29	19		
		30	67
3	53		

NOTE:
 Earthwork from Sta. 80+50
 to Sta. 82+00 included in
 Cross Sections for U.S. 6.