


| Seeding  | Sodding  |          |
|----------|----------|----------|
|          | Width    | Area     |
| Lin. Ft. | Lin. Ft. | Sq. Yds. |
| 61       |          |          |
| 297      |          |          |
| 56       |          |          |
| 317      |          |          |
| 58       |          |          |
| 312      |          |          |
| 65       |          |          |
| 364      |          |          |
| 66       |          |          |
| 375      |          |          |
| 69       |          |          |
| 100      |          |          |
| 75       |          |          |

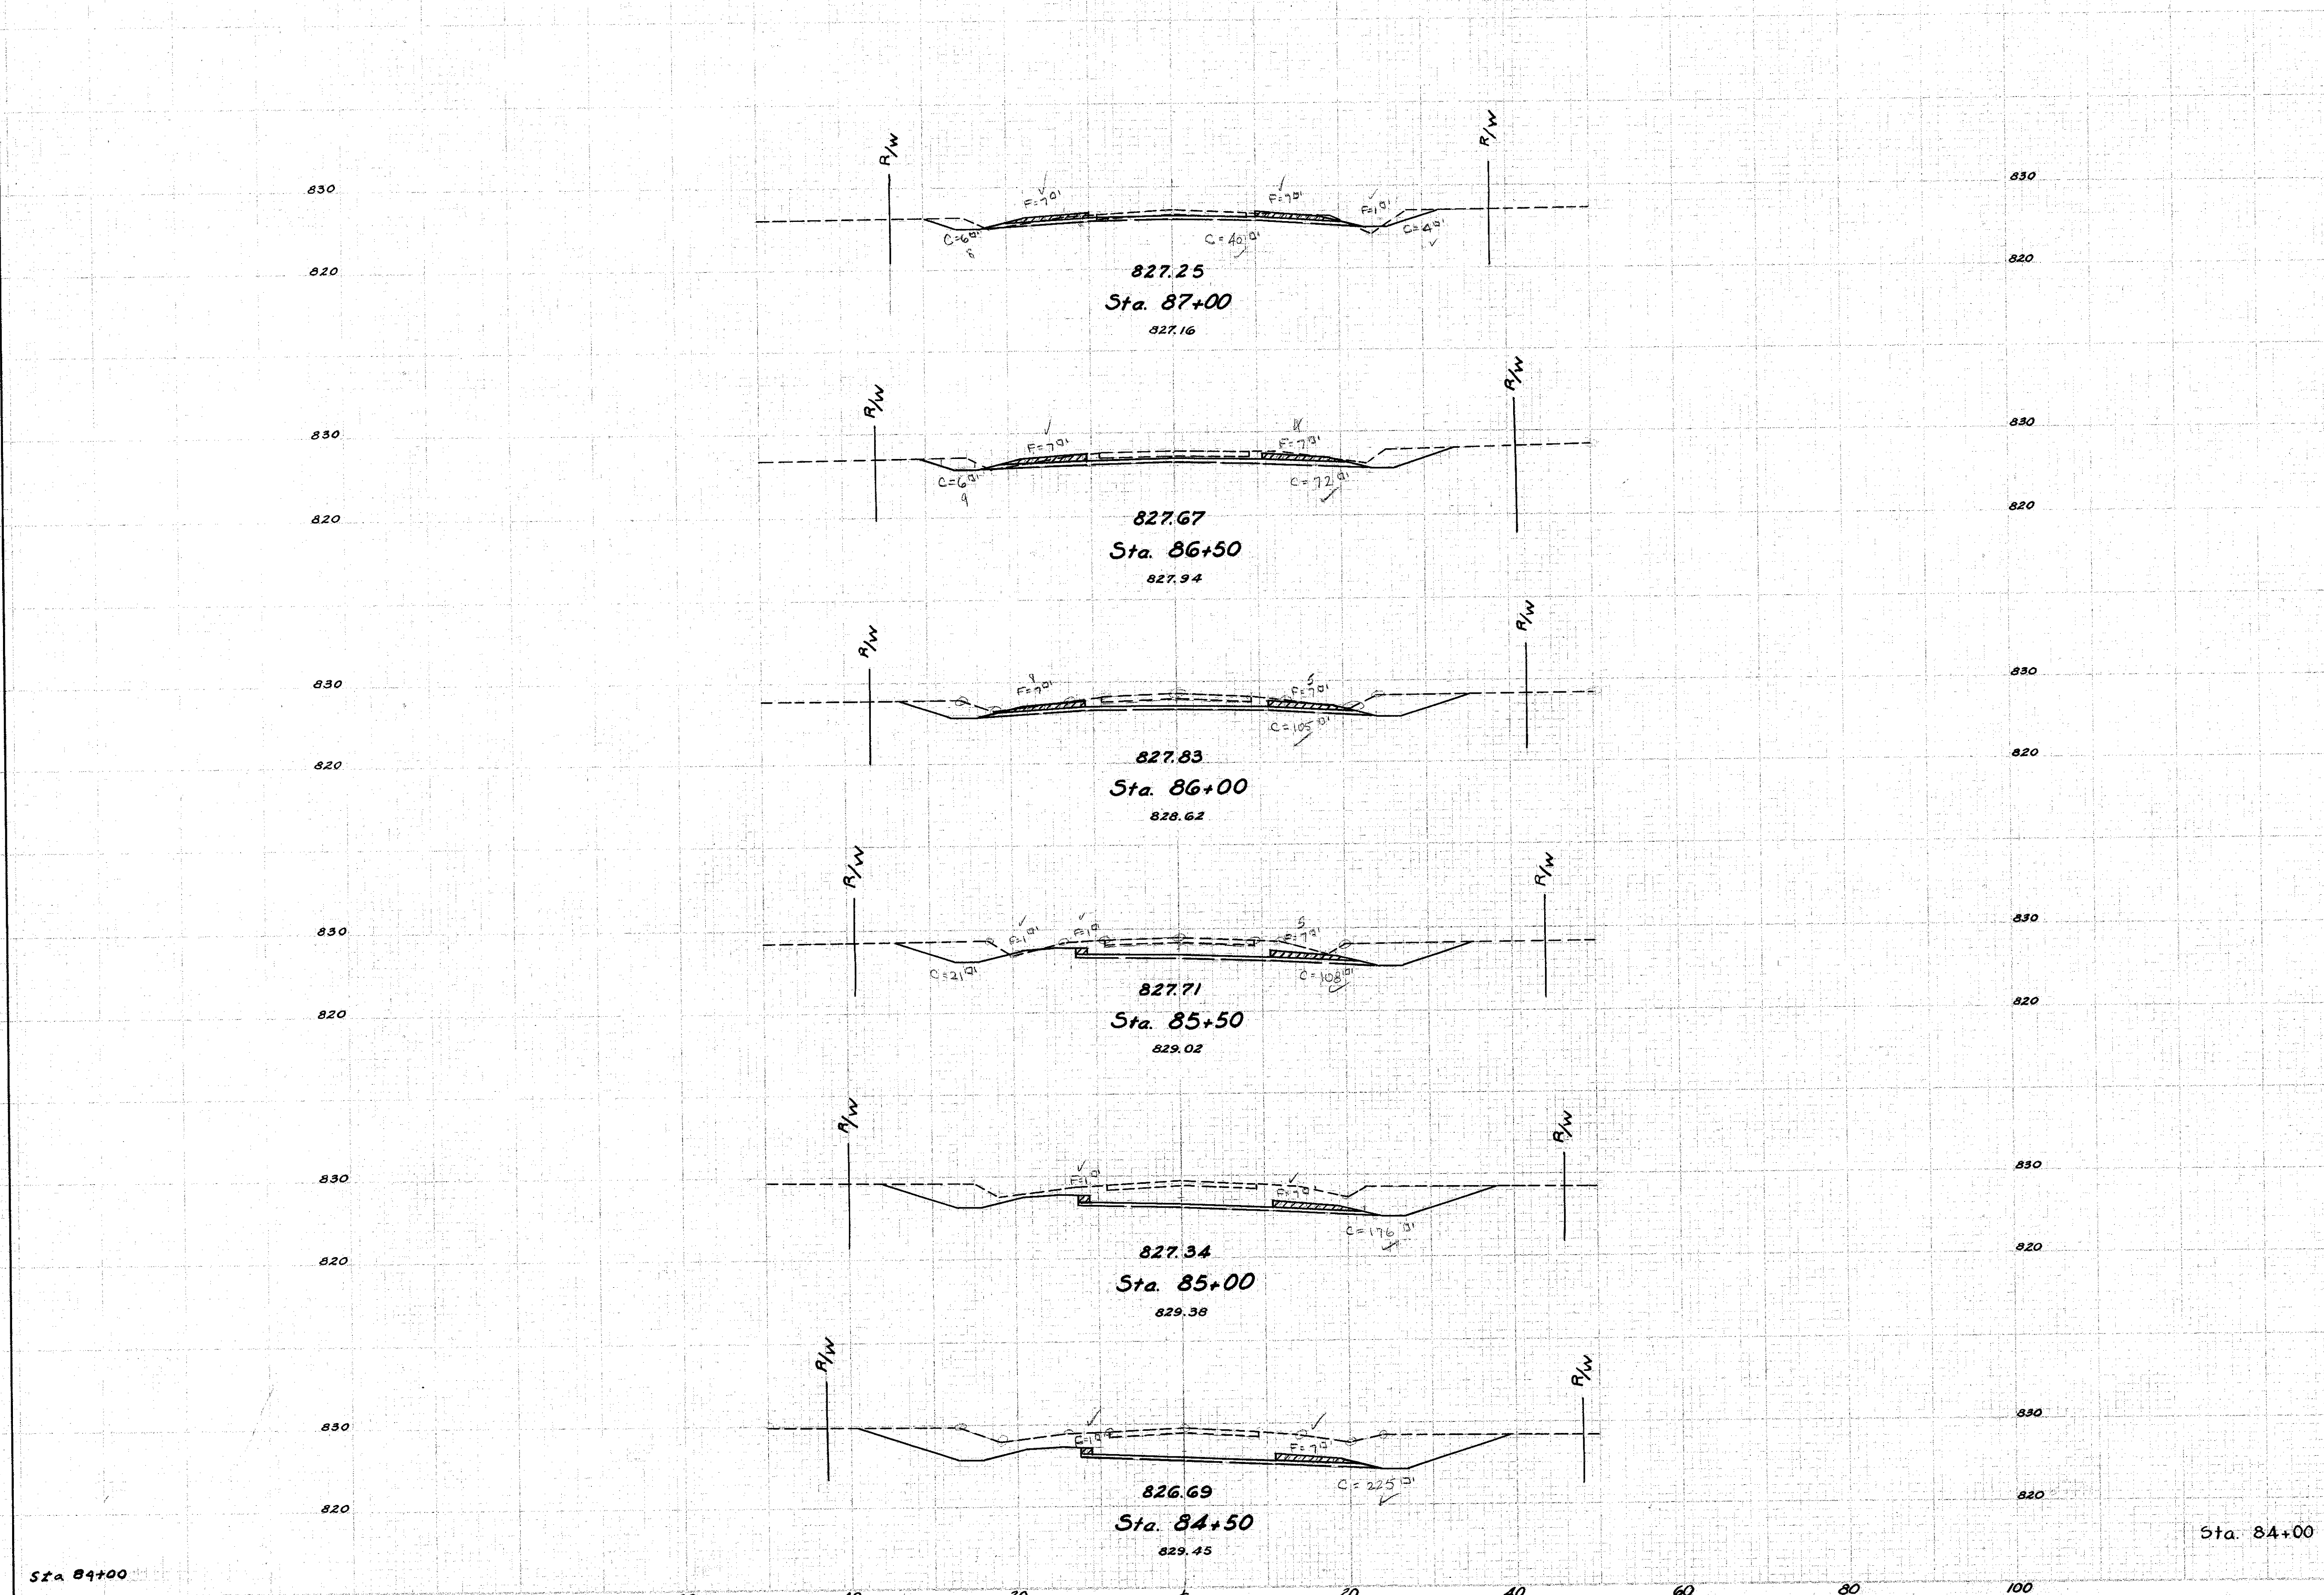

| END AREA | CU. YDS. |        |
|----------|----------|--------|
|          | CUT      | FILL   |
| 50       | 14       |        |
|          |          | 119 26 |
| 78       | 14       |        |
|          |          | 170 26 |
| 105      | 14       |        |
|          |          | 217 22 |
| 129      | 9        |        |
|          |          | 283 16 |
| 176      | 8        |        |
|          |          | 372 15 |
| 225      | 8        |        |
| 273      | 8        |        |

Excavation 286.4 Cu. Yds.  
 Embankment 283 Cu. Yds.  
 Embankment + 1.5% 325 Cu. Yds.