


LAK. -608 -0.60

SEEDING & SODDING	
WIDTH LIN. FT.	AREA SQ. YDS.

END AREA		Cu. Yds.	
CUT	FILL	CUT	FILL

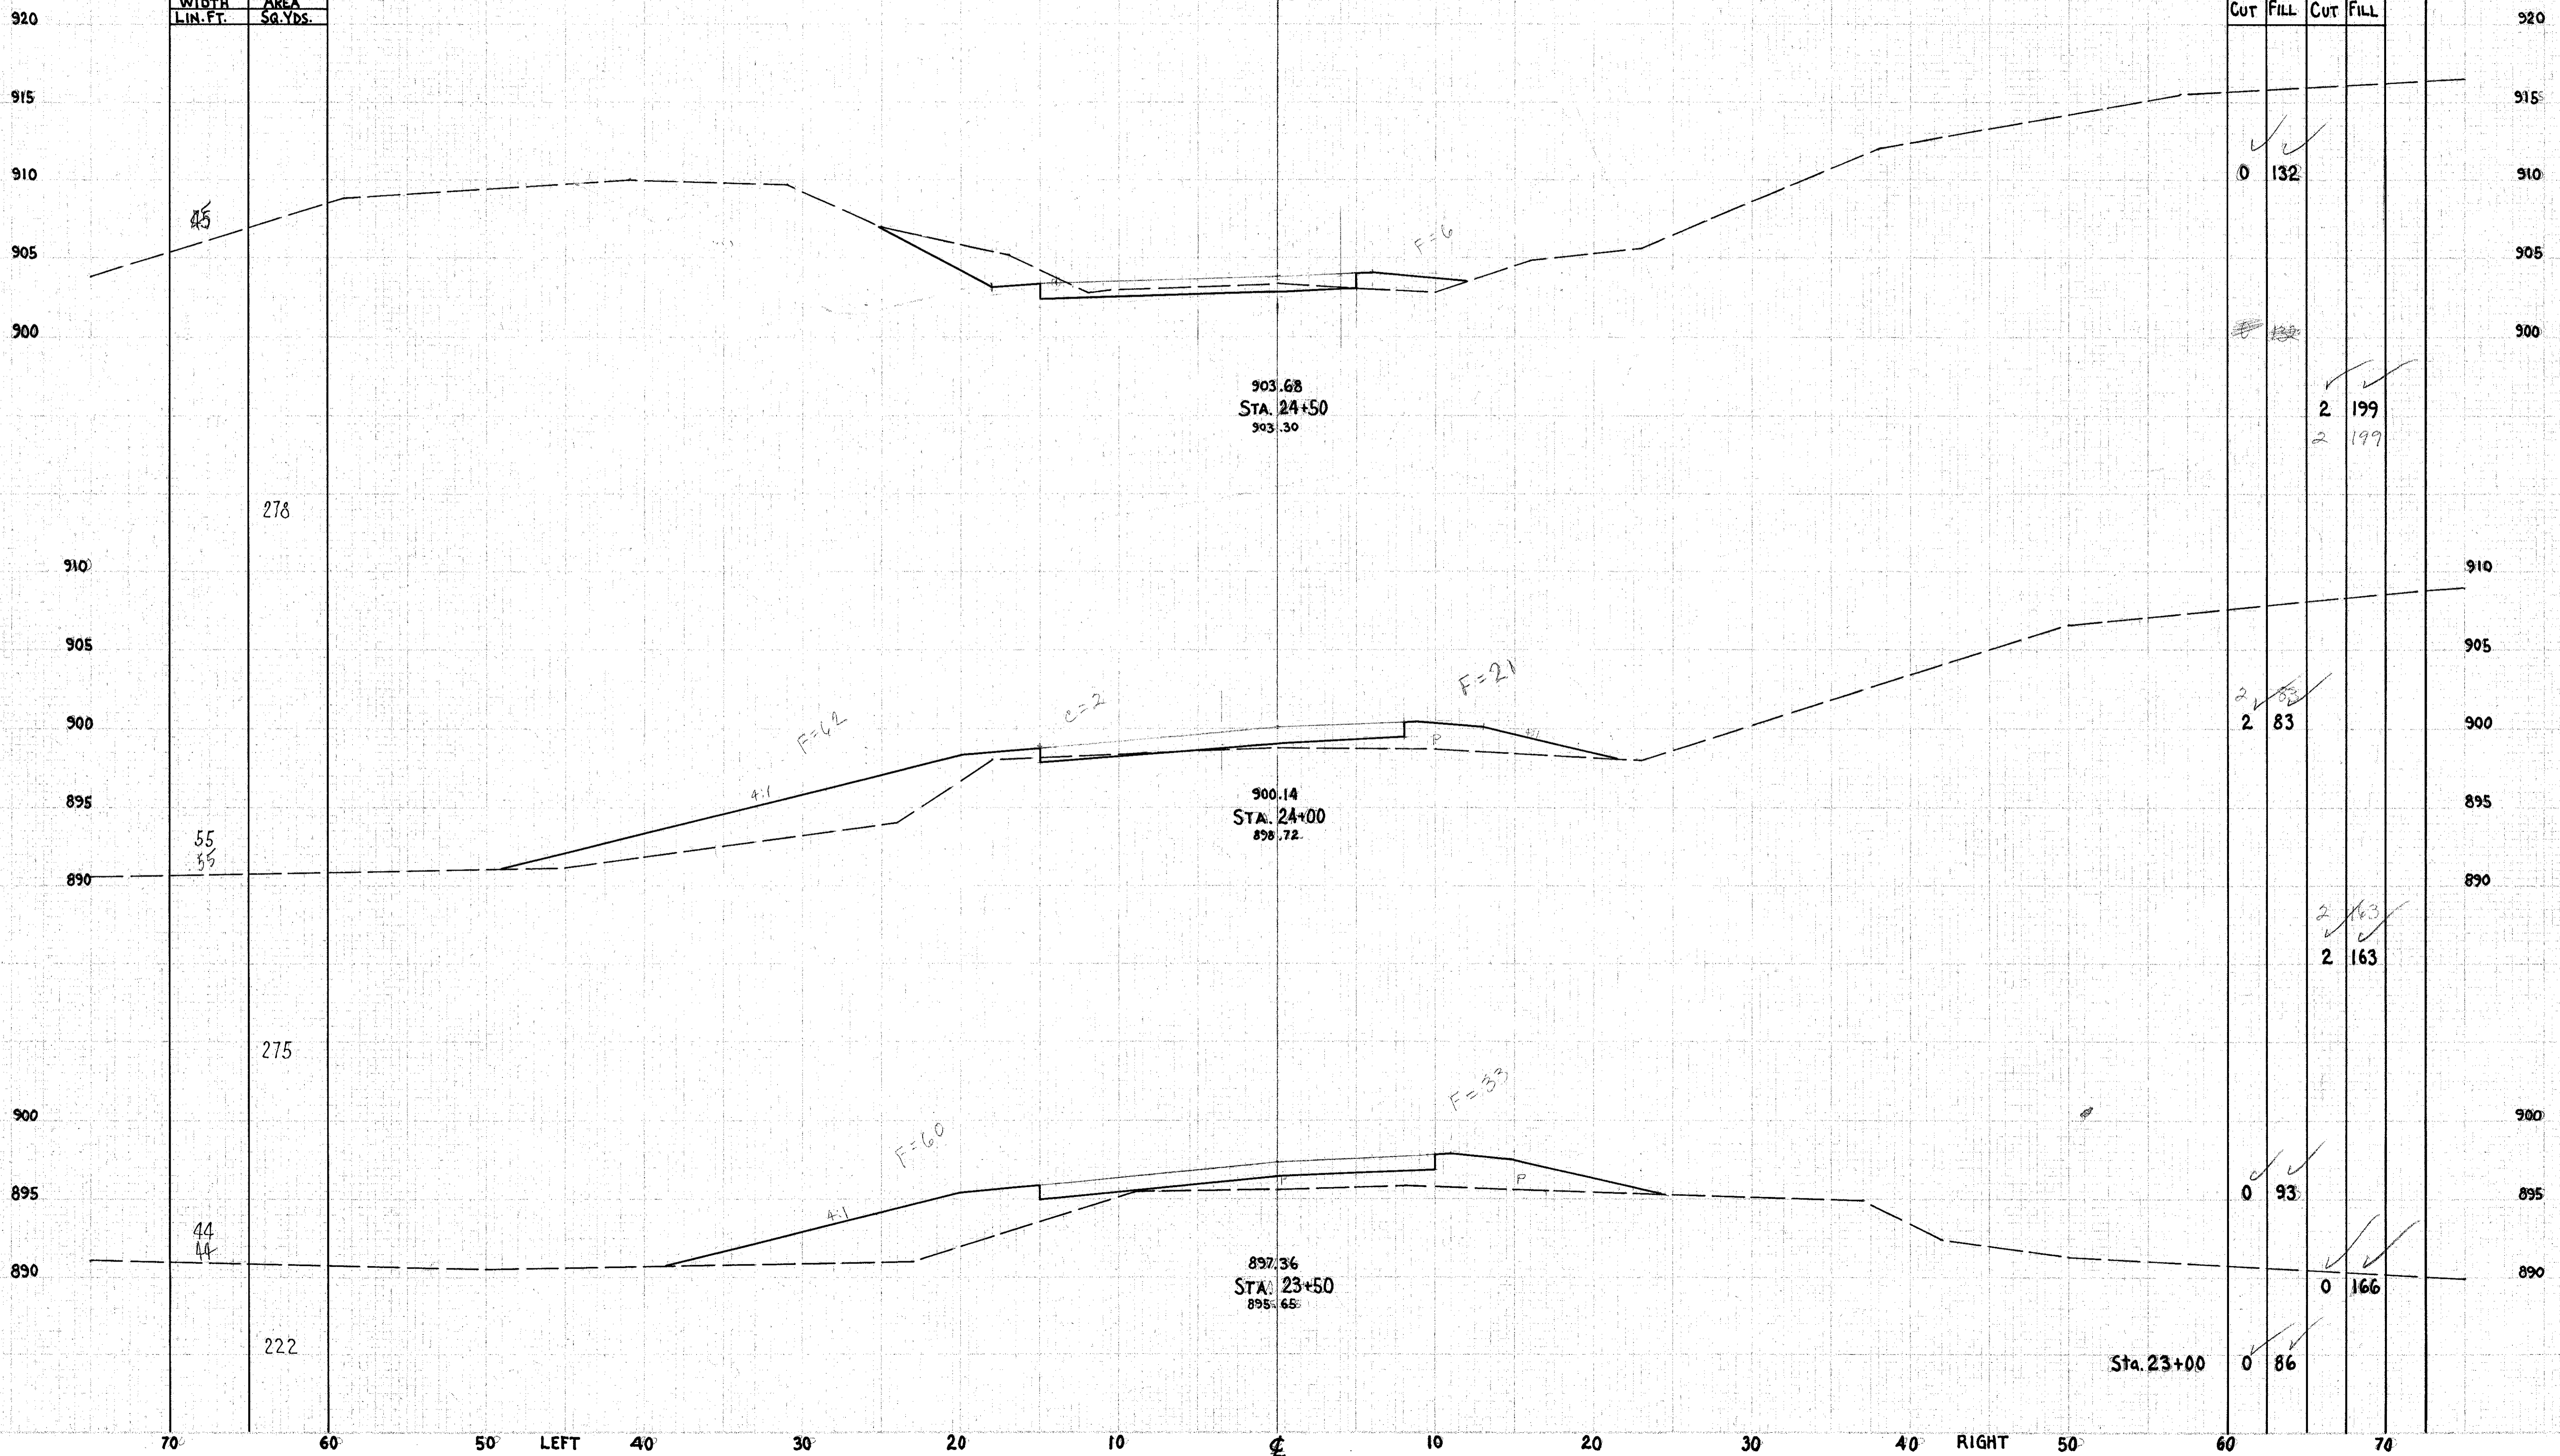

SEEDING & SODDING	
WIDTH LIN. FT.	AREA SQ. YDS.
45	278
55 53	275
44 44	222

END AREA		Cu. Yds.	
CUT	FILL	CUT	FILL
0	132	2	199
2	83	2	163
0	93	0	166
0	86		

903.68  
STA. 24+50  
903.30

900.14  
STA. 24+00  
898.72

897.36  
STA. 23+50  
895.65

Sta. 23+00