

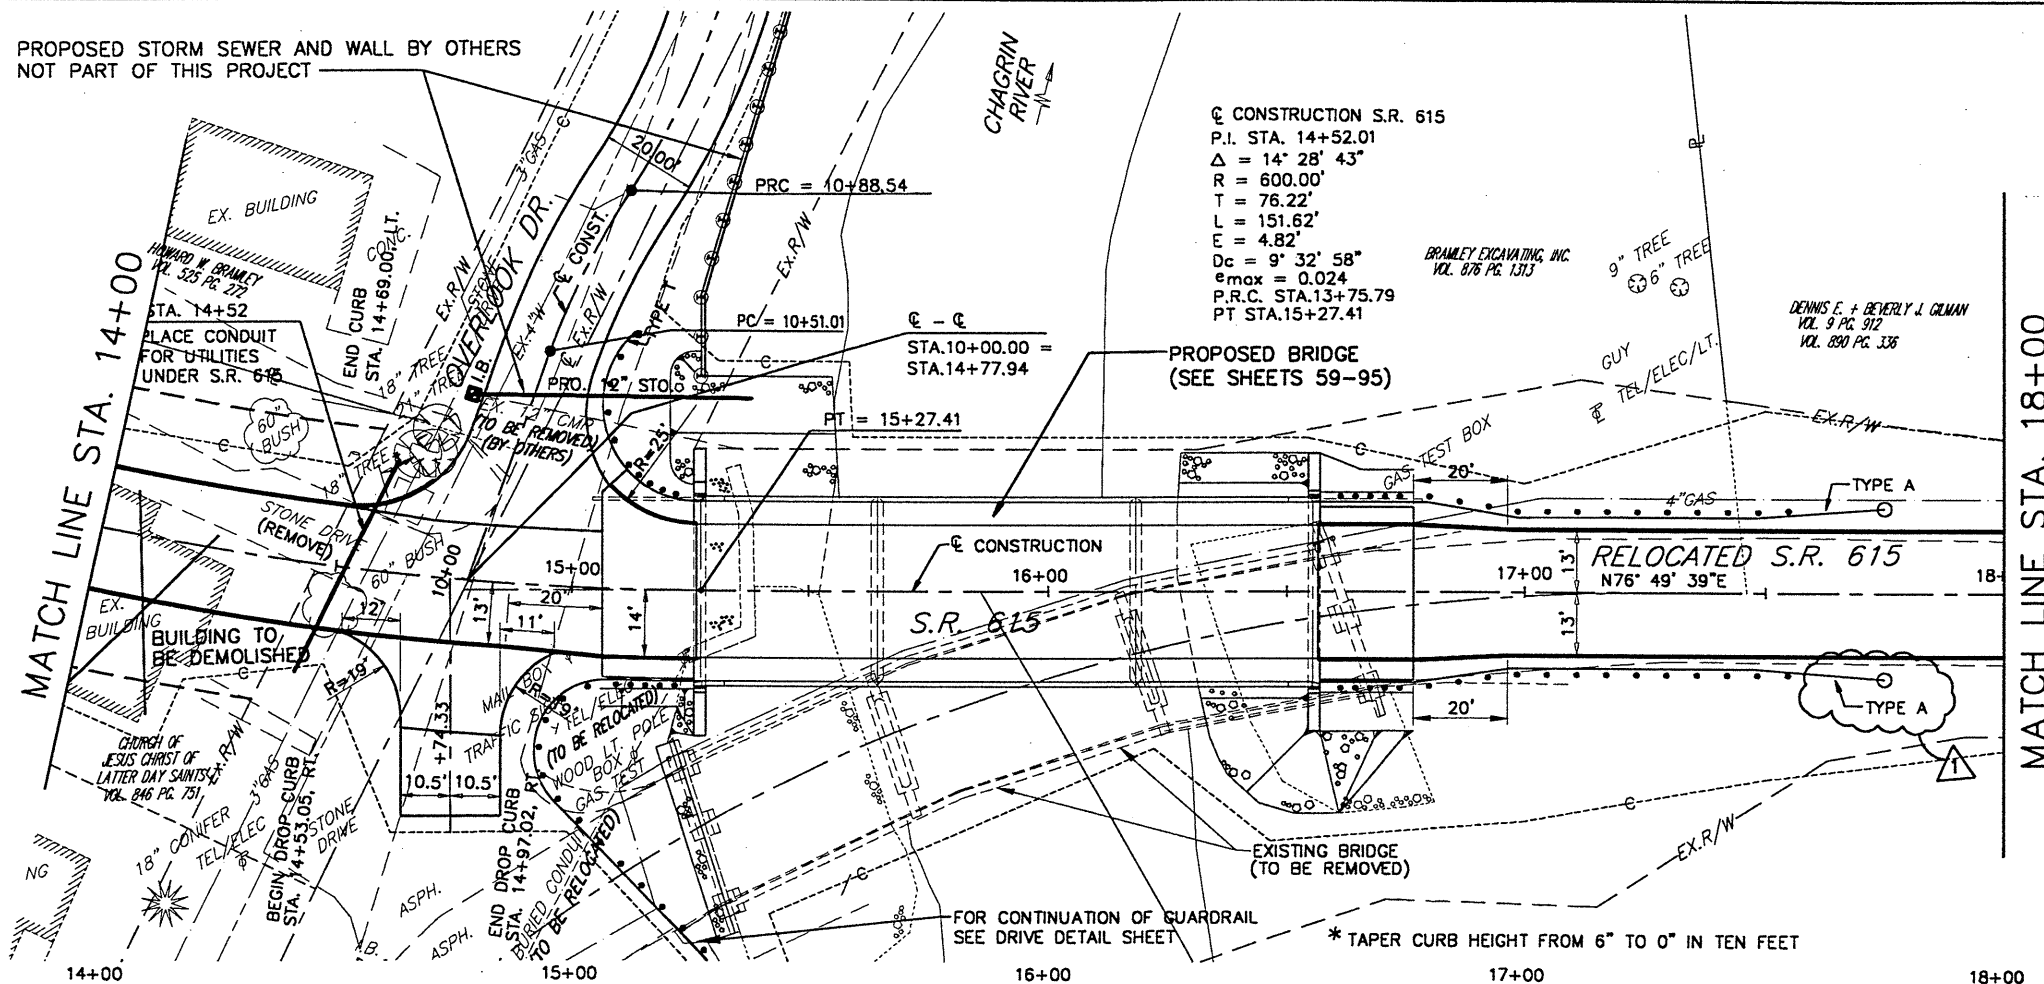


DATE: 10-15-99 - TIME: 13:29 - H:\ct\97260\sdsk\pp2.dwg

PROPOSED STORM SEWER AND WALL BY OTHERS
NOT PART OF THIS PROJECT

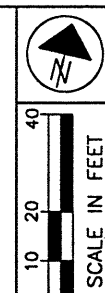

BENCHMARK NO. 1
CHISLED SQ. NE WINGWALL
BRIDGE ON S.R. 306 OVER
CHAGRIN RIVER.
STA: 228+43.99, 20.162' R
ELEV. = 644.28

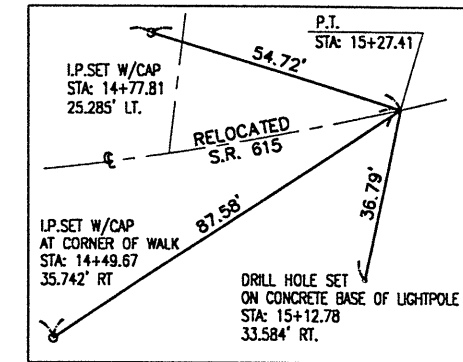

Station	Elevation	Notes
14+00	660.13	
	660.43	
	660.59	
	660.62	300.00' VC H.P. ELEV = 660.62 H.P. STA = 14+68.13 PVI STA = 14+00 PM ELEV = 662.50 A.D. = -6.31 K = 47.54
15+00	660.51	
	660.29	
	659.92	PVT STA. 15+50 PVT ELEV. 659.92
16+00	659.06	
	658.19	
	657.33	EXISTING PROFILE GRADE
17+00	656.47	-1.72%
18+00	655.61	

No.	REVISIONS	By	Date
1	Change Type "T" To Type "A"	RLB	2/28/00

RELOCATED S.R. 615 PLAN AND PROFILE
STA. 14+00 TO STA. 18+00

LAK - 615 - 0.00

18
95