


EXISTING PAV'T TO BE REMOVED

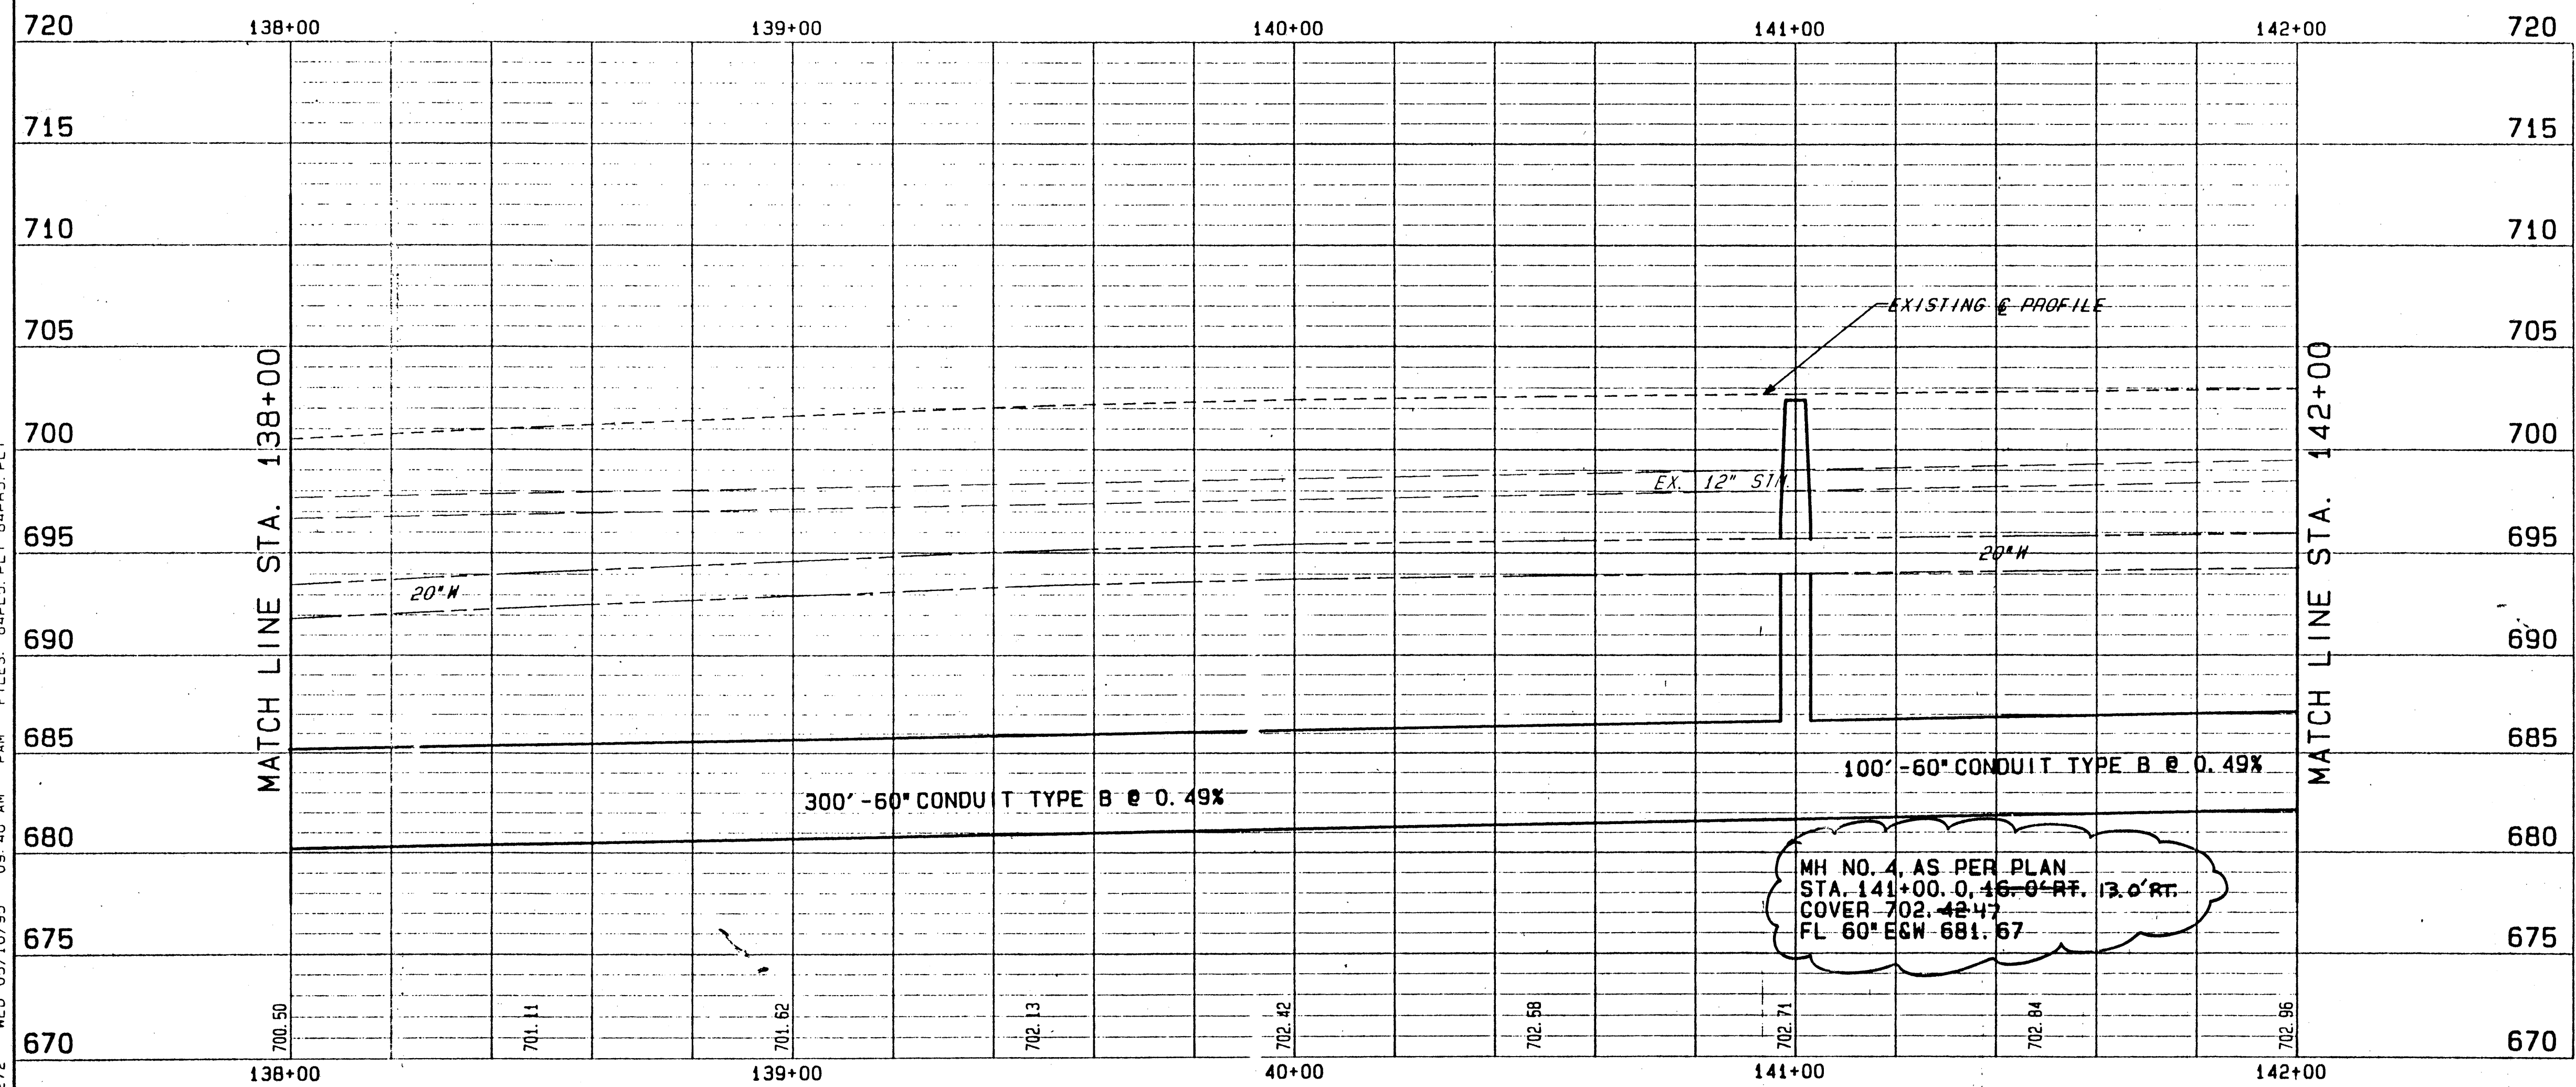

NO.	DESCRIPTION	UNIT	QUANTITY	TOTALS
603	60" CONDUIT, TYPE B AS PER PLAN (A) 706.02, 1500 D-LOAD	L.F.	300	400
604	MANHOLE NO. 4, AS PER PLAN	EA.	1	1
			TOTALS	400

FOR TYPICAL SECTION SEE SHEET 4
 FOR CROSS SECTIONS SEE SHEET 85-88
 FOR ROADWAY DETAILS SEE SHEET 149

QUANTITIES HAVE BEEN CARRIED TO SUB-SUMMARY SHEETS 42-45

CHANGE ORDER
 184-01 4/8
 9-5-01

30272 MED 05/10/95 09:46 AM PAM FILES: 84PL5, PL1, 84PR5, PL1