


EXISTING PAV'T
 TO BE REMOVED

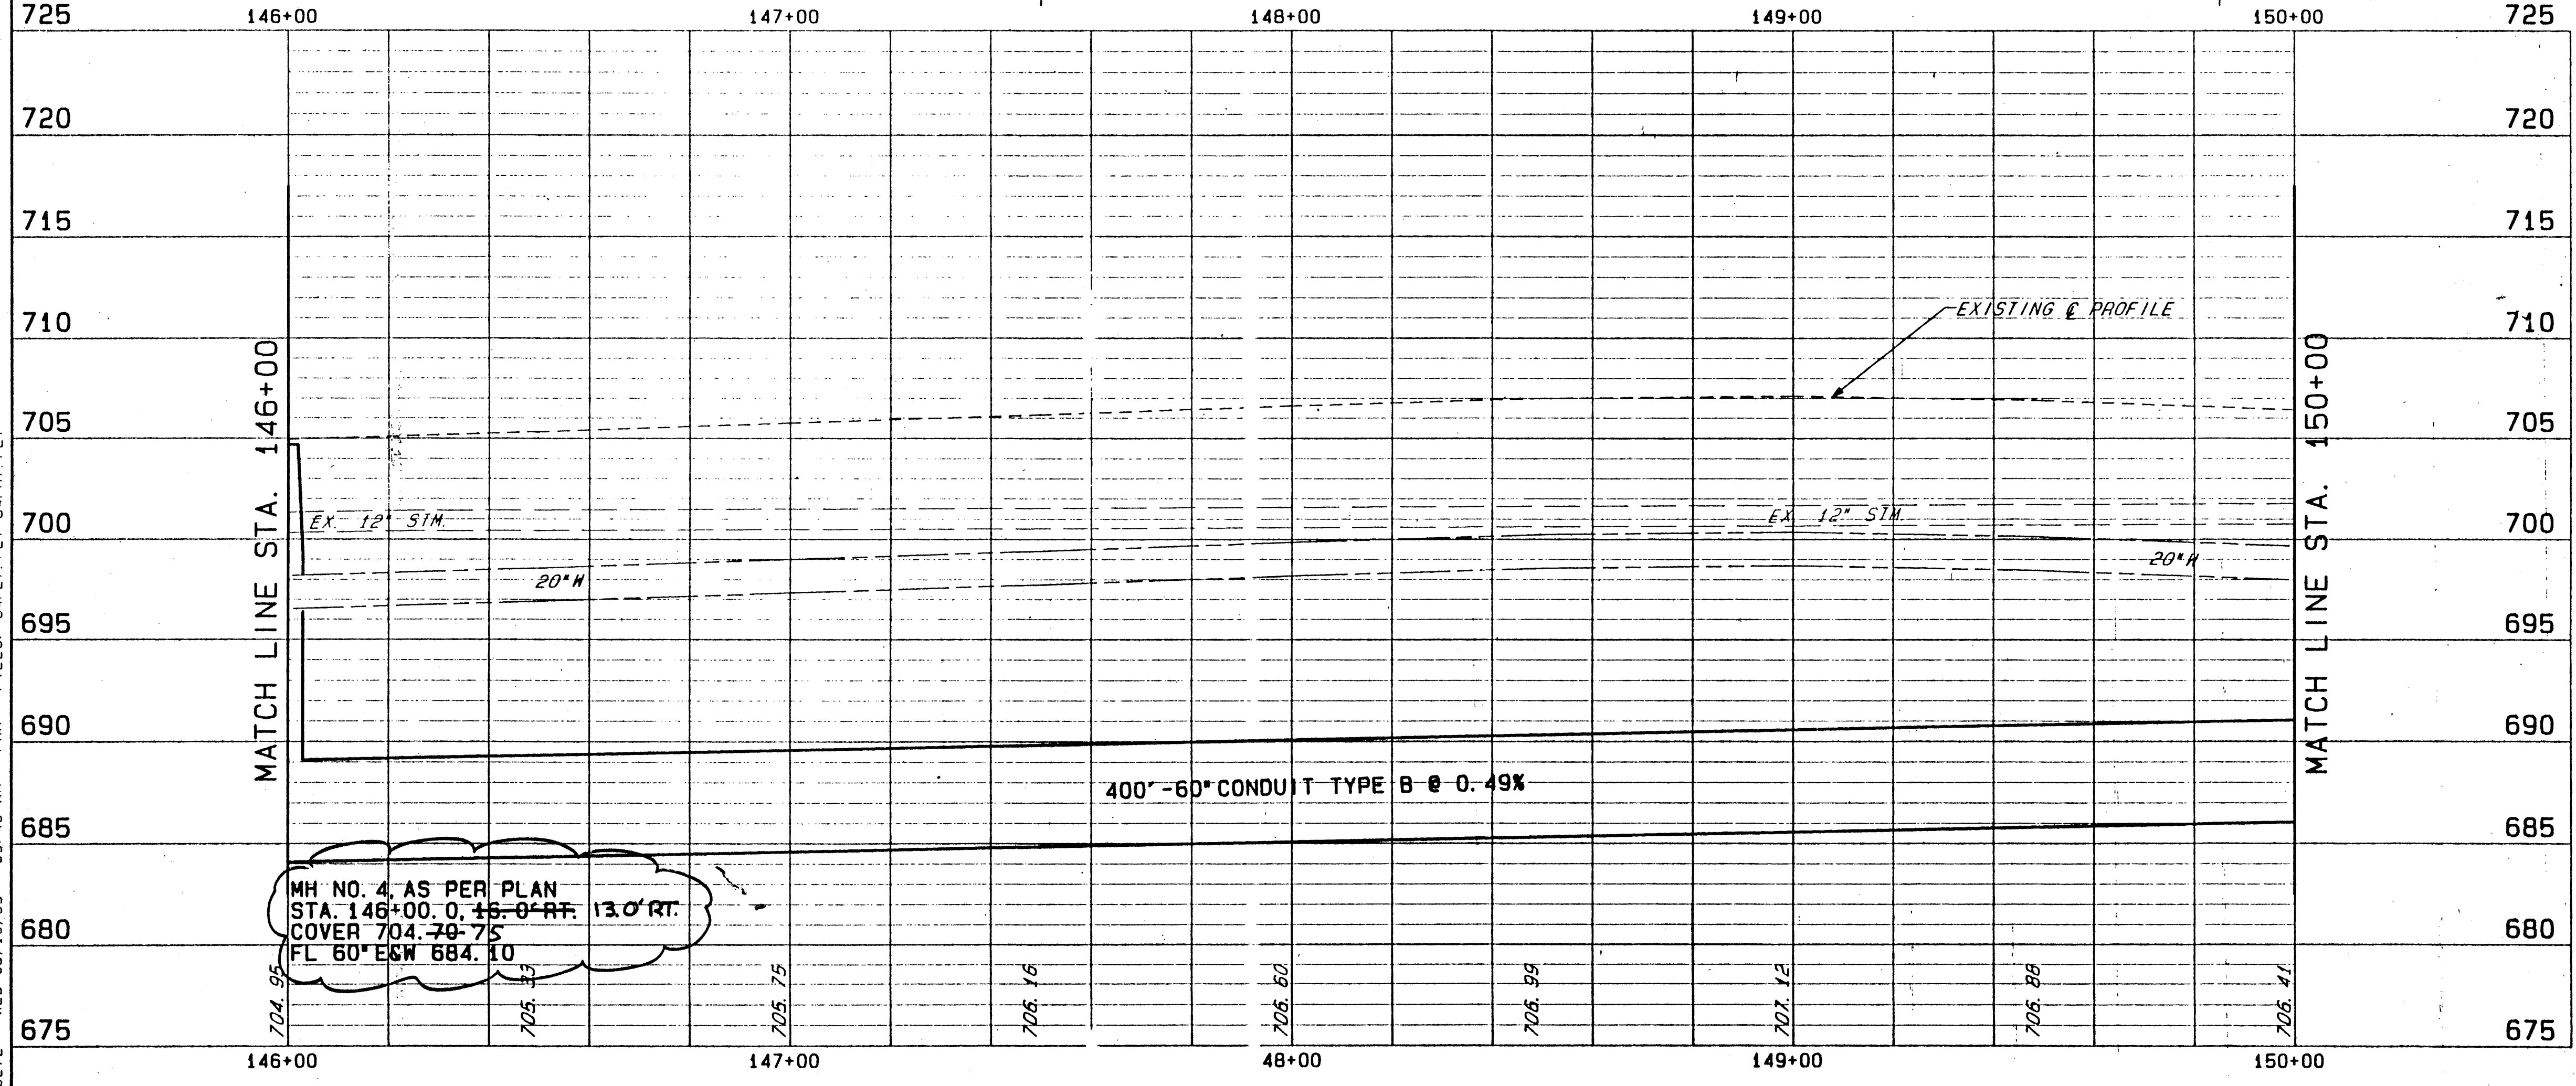

ITEM	DESCRIPTION	QUANTITY	UNIT
603	60" CONDUIT, TYPE B AS PER PLAN (A) 706.02, 1500 D-LOAD		L.F.
	LOCATION STA. 146+00.00 RT. TO STA. 150+00.00 RT.	400	
	TOTALS	400	

FOR TYPICAL SECTION SEE SHEET 4
 FOR CROSS SECTIONS SEE SHEET 91-93
 FOR ROADWAY DETAILS SEE SHEET 149

QUANTITIES HAVE BEEN CARRIED
 TO SUB-SUMMARY SHEETS 42-45

CHANGE ORDER
 184-01
 9-5-01 6/8

90272 WED 05/10/95 09:46 AM PAM FILES: 84PL7.PLT B4PP7.PLT