CALC. BY VLW DATE 4/4/95	LAK - 615 - 2.82	OHIO
CHKD. BY WDP DATE 4/5/95		FHWA REGION 5

63
199

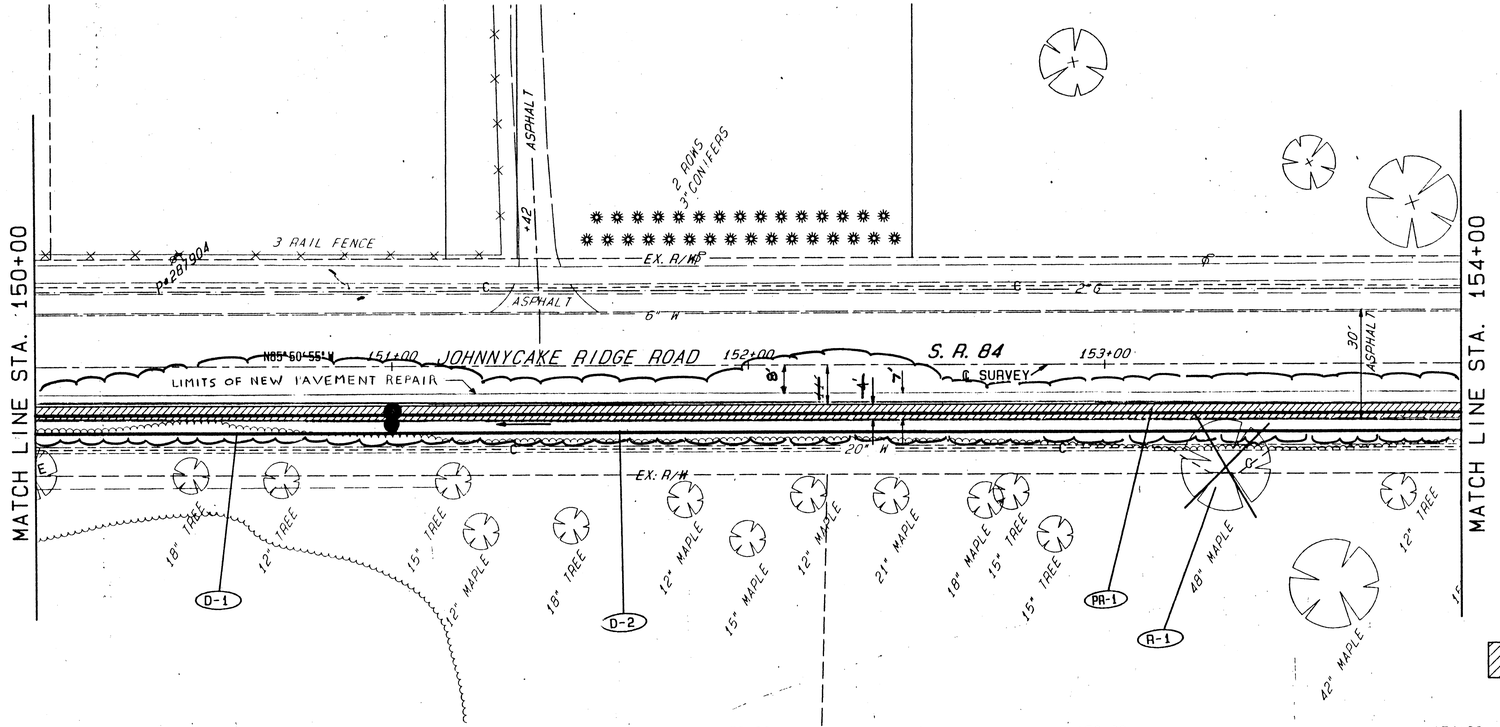

QUANTITIES HAVE BEEN CARRIED TO SUB-SUMMARY SHEETS 42-45

FOR TYPICAL SECTION SEE SHEET 4
FOR CROSS SECTIONS SEE SHEET 93-96
FOR ROADWAY DETAILS SEE SHEET 149

EXISTING PAV'T TO BE REMOVED

604	MANHOLE NO. 4, AS PER PLAN	EA.	1
603	60" CONDUIT, TYPE B AS PER PLAN (A) 706.02, 1500 D-LOAD	L.F.	100
			300
			TOTALS 400

DRAINAGE AND SANITARY

	LOCATION
D-1	STA. 150+00.00 RT. TO STA. 151+00.00 RT.
D-2	STA. 151+00.00 RT. TO STA. 154+00.00 RT.

201	TREE AND/OR STUMP REMOVED, 48" SIZE	EA.	1
			TOTALS 1

ROADWAY

	LOCATION
R-1	STA. 153+34.00, RT.

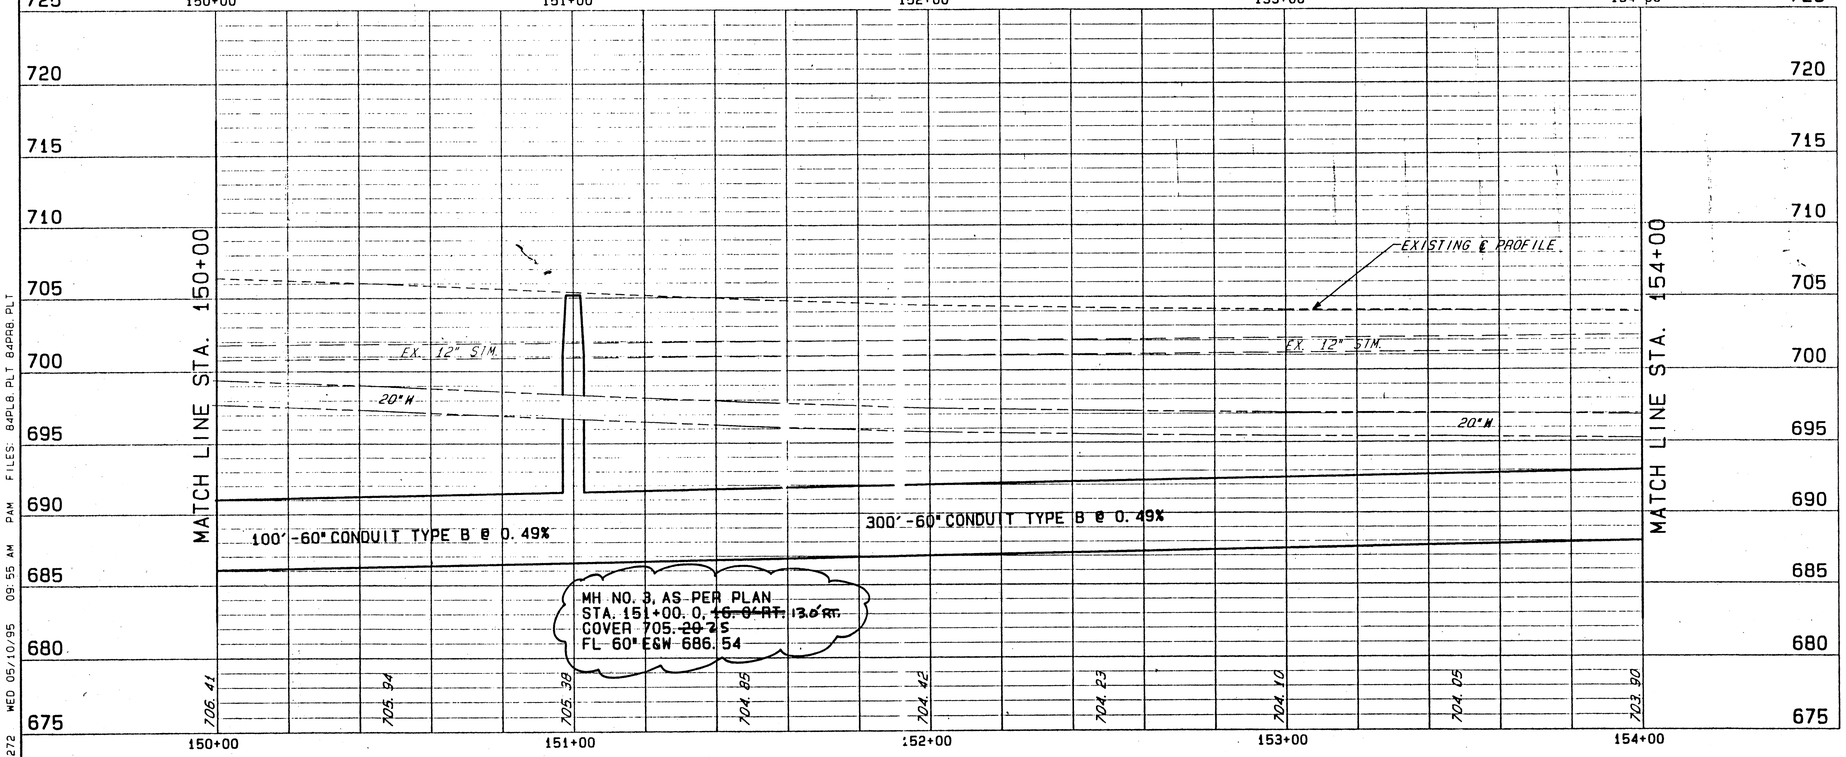

CHANGE ORDER 184-01 9/5/01 7/8

WED 05/10/95 09:55 AM PAM FILES: 84PL8.PLT 84PR8.PLT
90272

S. R. 84 PLAN & PROFILE STA. 150+00 TO STA. 154+00