
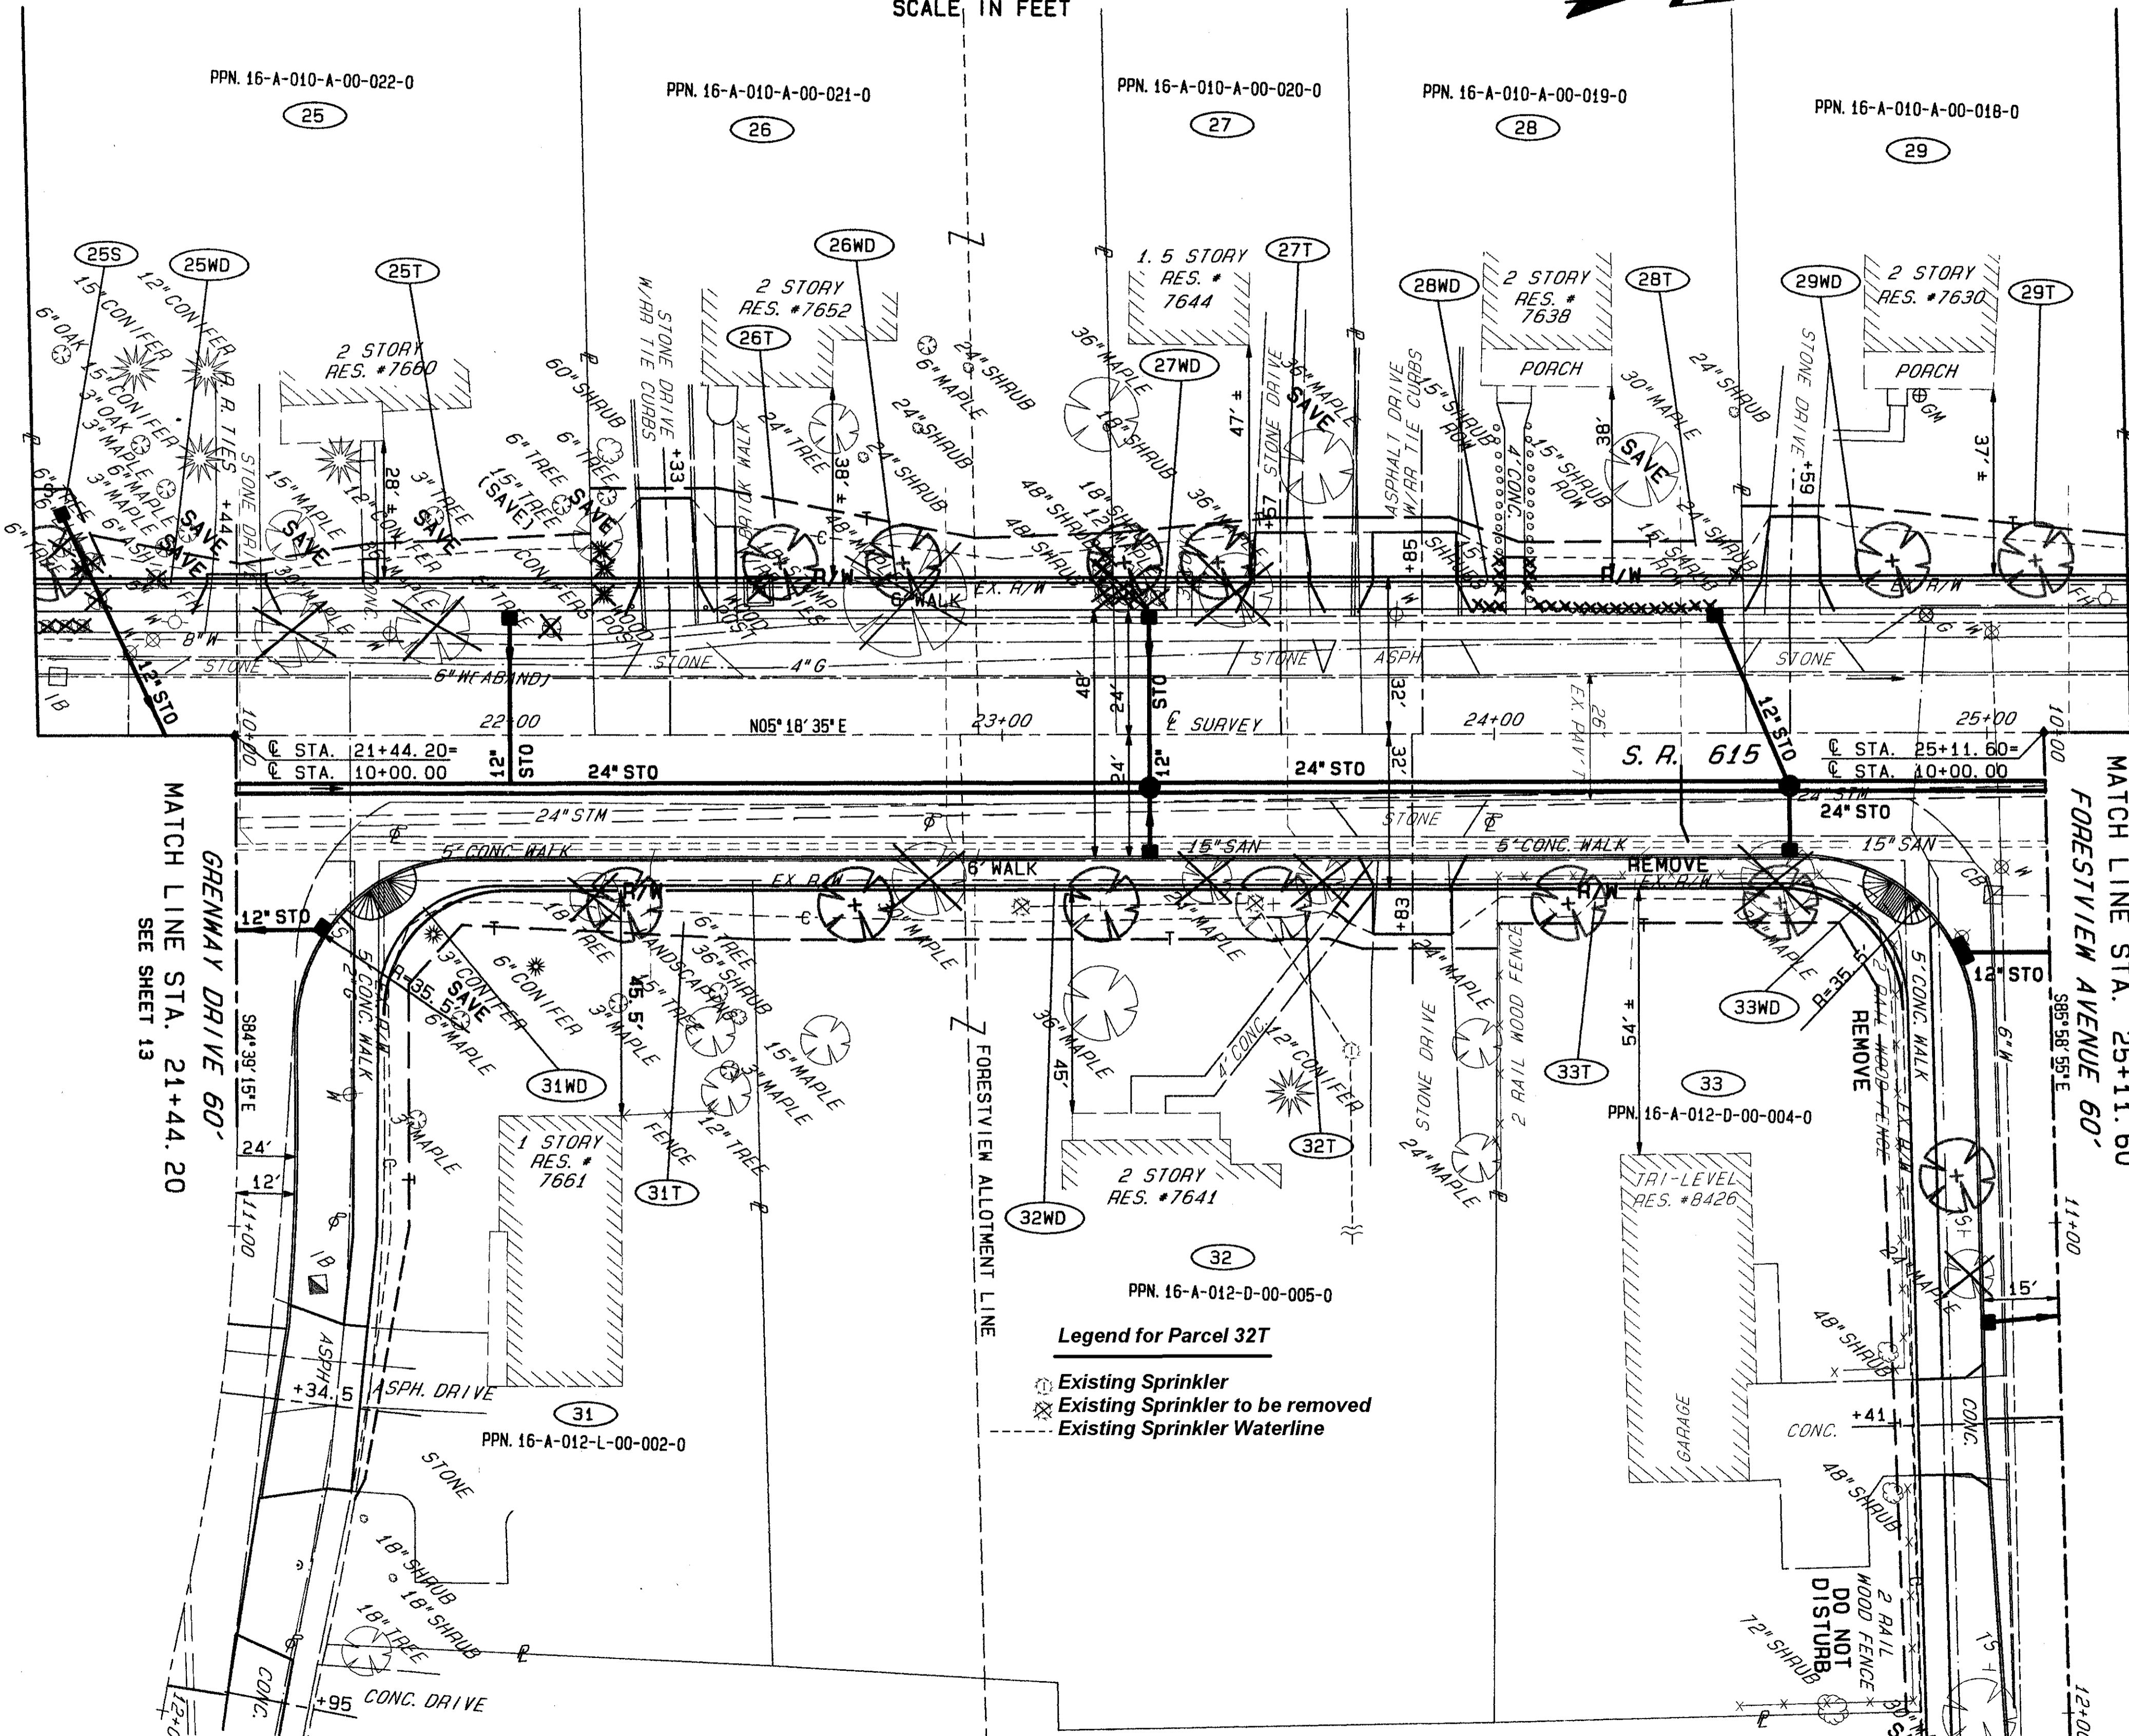


**LAKE COUNTY
CITY OF MENTOR**
PART OF LOT 8&9, TRACT 3, LOT 7&9, TRACT 2, BACON & CHURCH LOTS
T=10N, R=9W

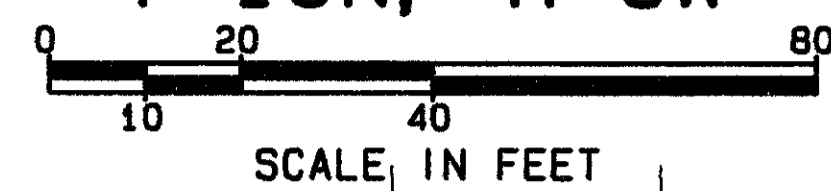

STRUCTURE KEY

	RESIDENTIAL
	COMMERCIAL

Legend for Parcel 32T

- Existing Sprinkler
- Existing Sprinkler to be removed
- Existing Sprinkler Waterline

REV	DATE	DESCRIPTION
3	10/30/00	Added 2 Existing Sprinkler to be removed, 1 Existing Sprinkler, Existing Sprinkler Waterline, and Legend for Parcel 32T
2	8/31/00	PCL 32 added "Take" to a Sprinkler.
1	6/30/00	Removed ownership name list, see Property Map and Summary sheet for owner names.
DATE COMPLETED:		

RIGHT OF WAY PLANS STA. 21+44.20 TO STA. 25+11.60

90272 SUN 09/20/98 09:12 AM PAM FILES: RWPL4.PLT RWPL4B.PLT