


TOWNSHIP 10, RANGE 9  
CONNECTICUT WESTERN RESERVE  
CITY OF MENTOR

FED. RD. DIVISION	STATE	PROJECT
2	OHIO	US-1530 (I)


170  
181  
17  
28

LAKE COUNTY  
LAK-615-3.26

See Sheet 28

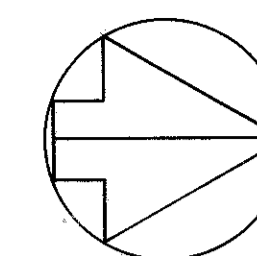

THE MENTOR LUMBER  
& SUPPLY COMPANY

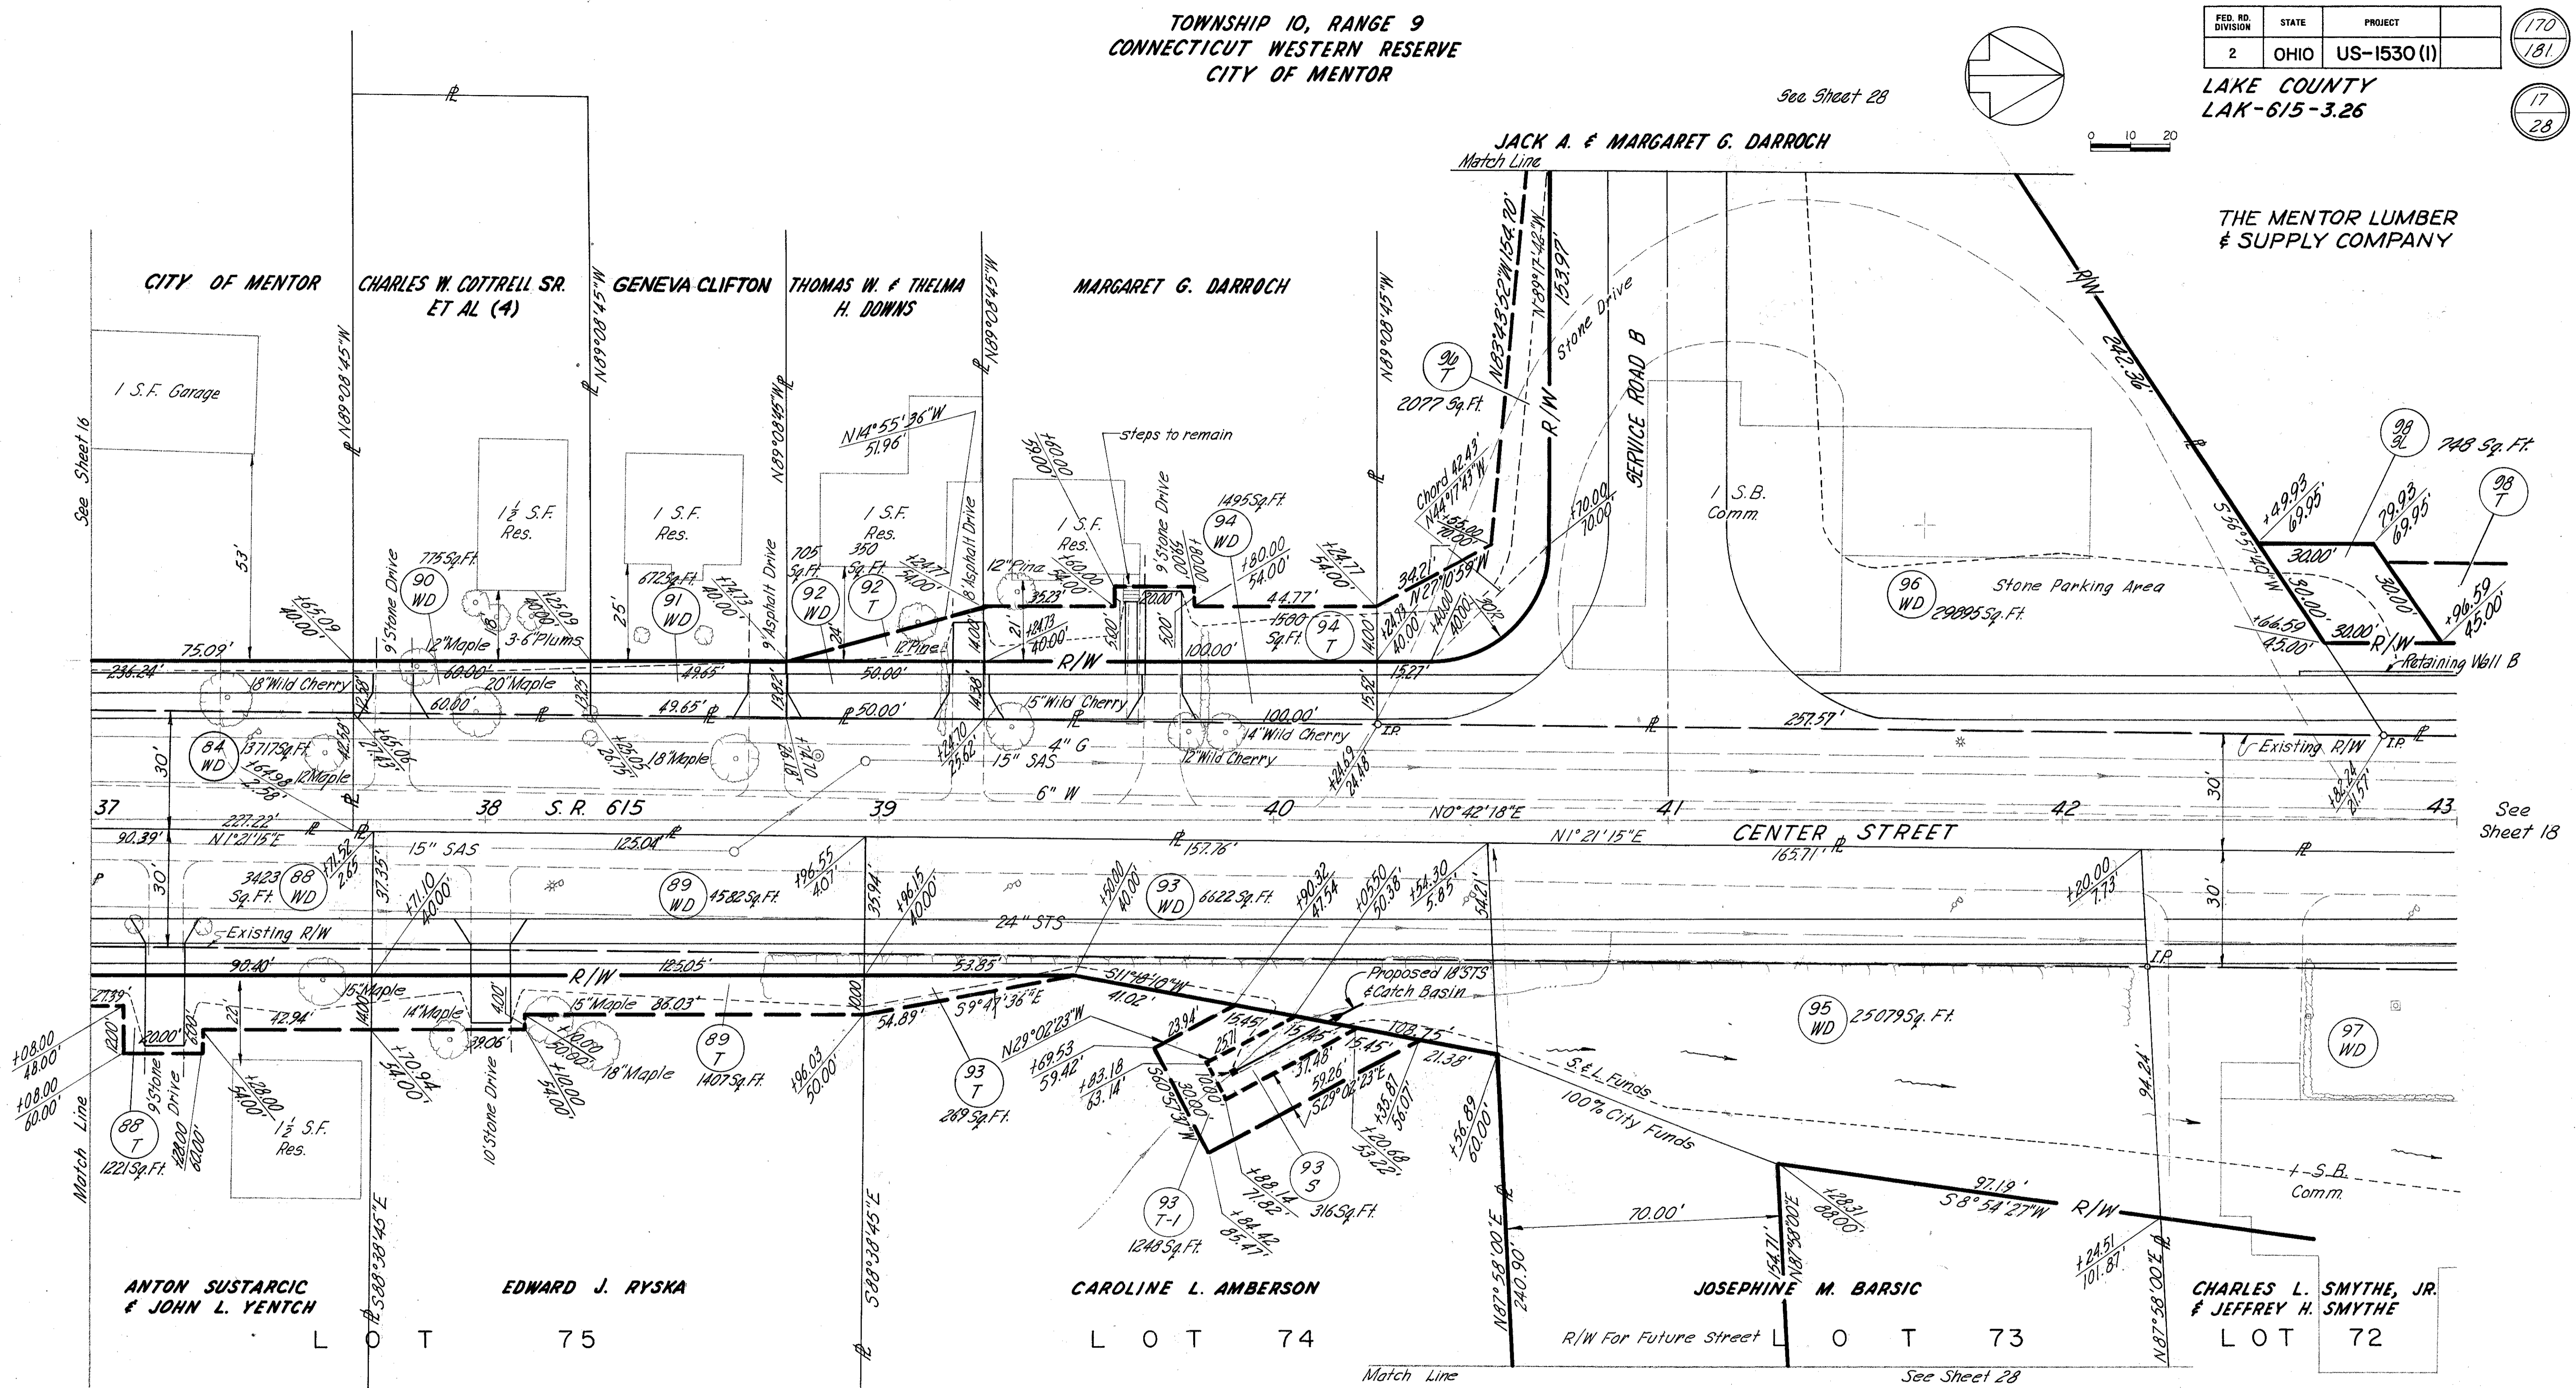

SMITH AND HARTS ADDITION

P.B. A PG. 113

Parcel 95  
S. & L. Funds: 13130 Sq. Ft.  
100% City Funds: 11949 Sq. Ft.

REV.	DATE	DESCRIPTION
1	5-25-69	Added funds participation breakdown 95
2	11-30-70	Revised 96-WD, 96-T, 98-T, added 98-5L

RIGHT OF WAY STA. 37+00 TO 43+00