
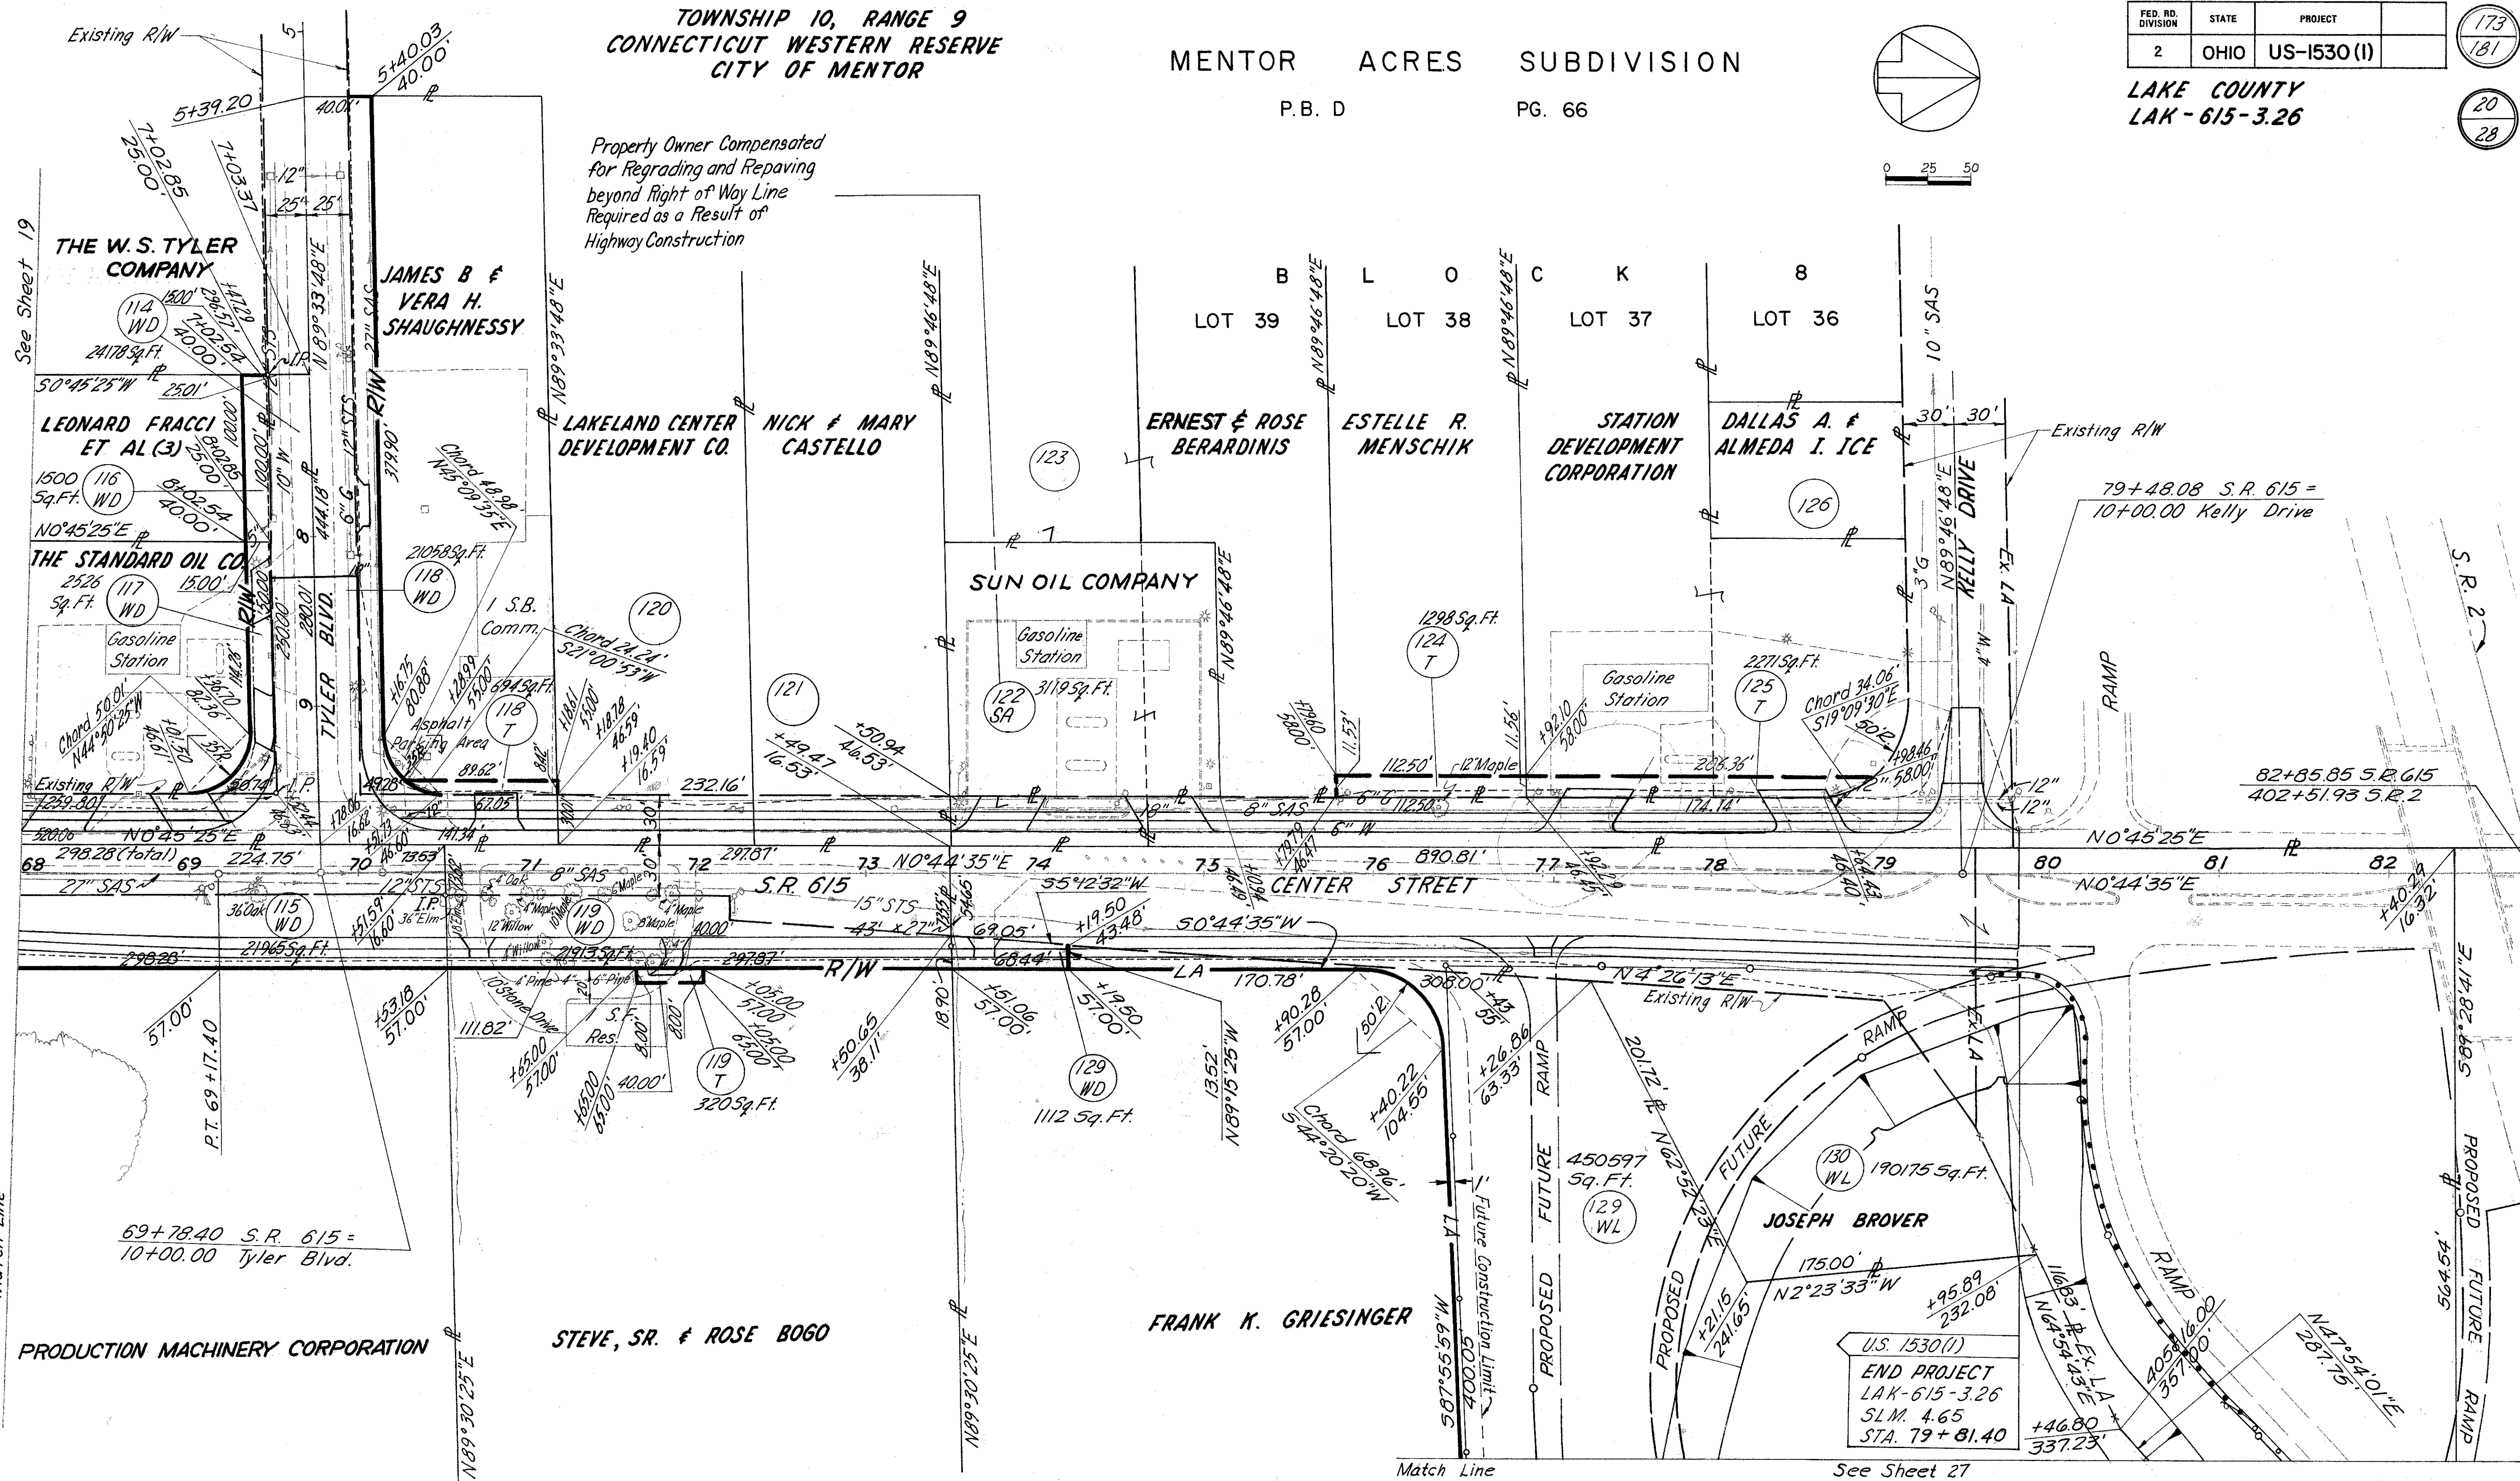


TOWNSHIP 10, RANGE 9
CONNECTICUT WESTERN RESERVE
CITY OF MENTOR

MENTOR ACRES SUBDIVISION

P.B. D PG. 66

FED. RD. DIVISION	STATE	PROJECT	173
2	OHIO	US-1530 (I)	181
LAKE COUNTY LAK-615-3.26			20
			28

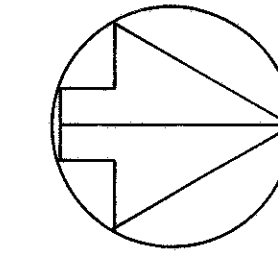

Property Owner Compensated for Regrading and Repaving beyond Right of Way Line Required as a Result of Highway Construction

See Sheet 19

Match Line

Match Line

See Sheet 27

& CURVE DATA
 P.I.=Sta. 67+26.34
 D=1°30'00"
 Δ=5°44'11" Lt.
 T=191.37'
 E=4.79'
 L=382.43'
 R=3819.71'

REV.	DATE	DESCRIPTION
1	12-30-68	Revised existing R/W line 117-WD.
2	6-23-70	Deleted 122-T, added 122-SA; revised driveway aprons to Par. 117 and 125.

RIGHT OF WAY STA. 68+00 TO 81+00