



35 30 25 20 15 10 5 E 5 10 15 20 25 30

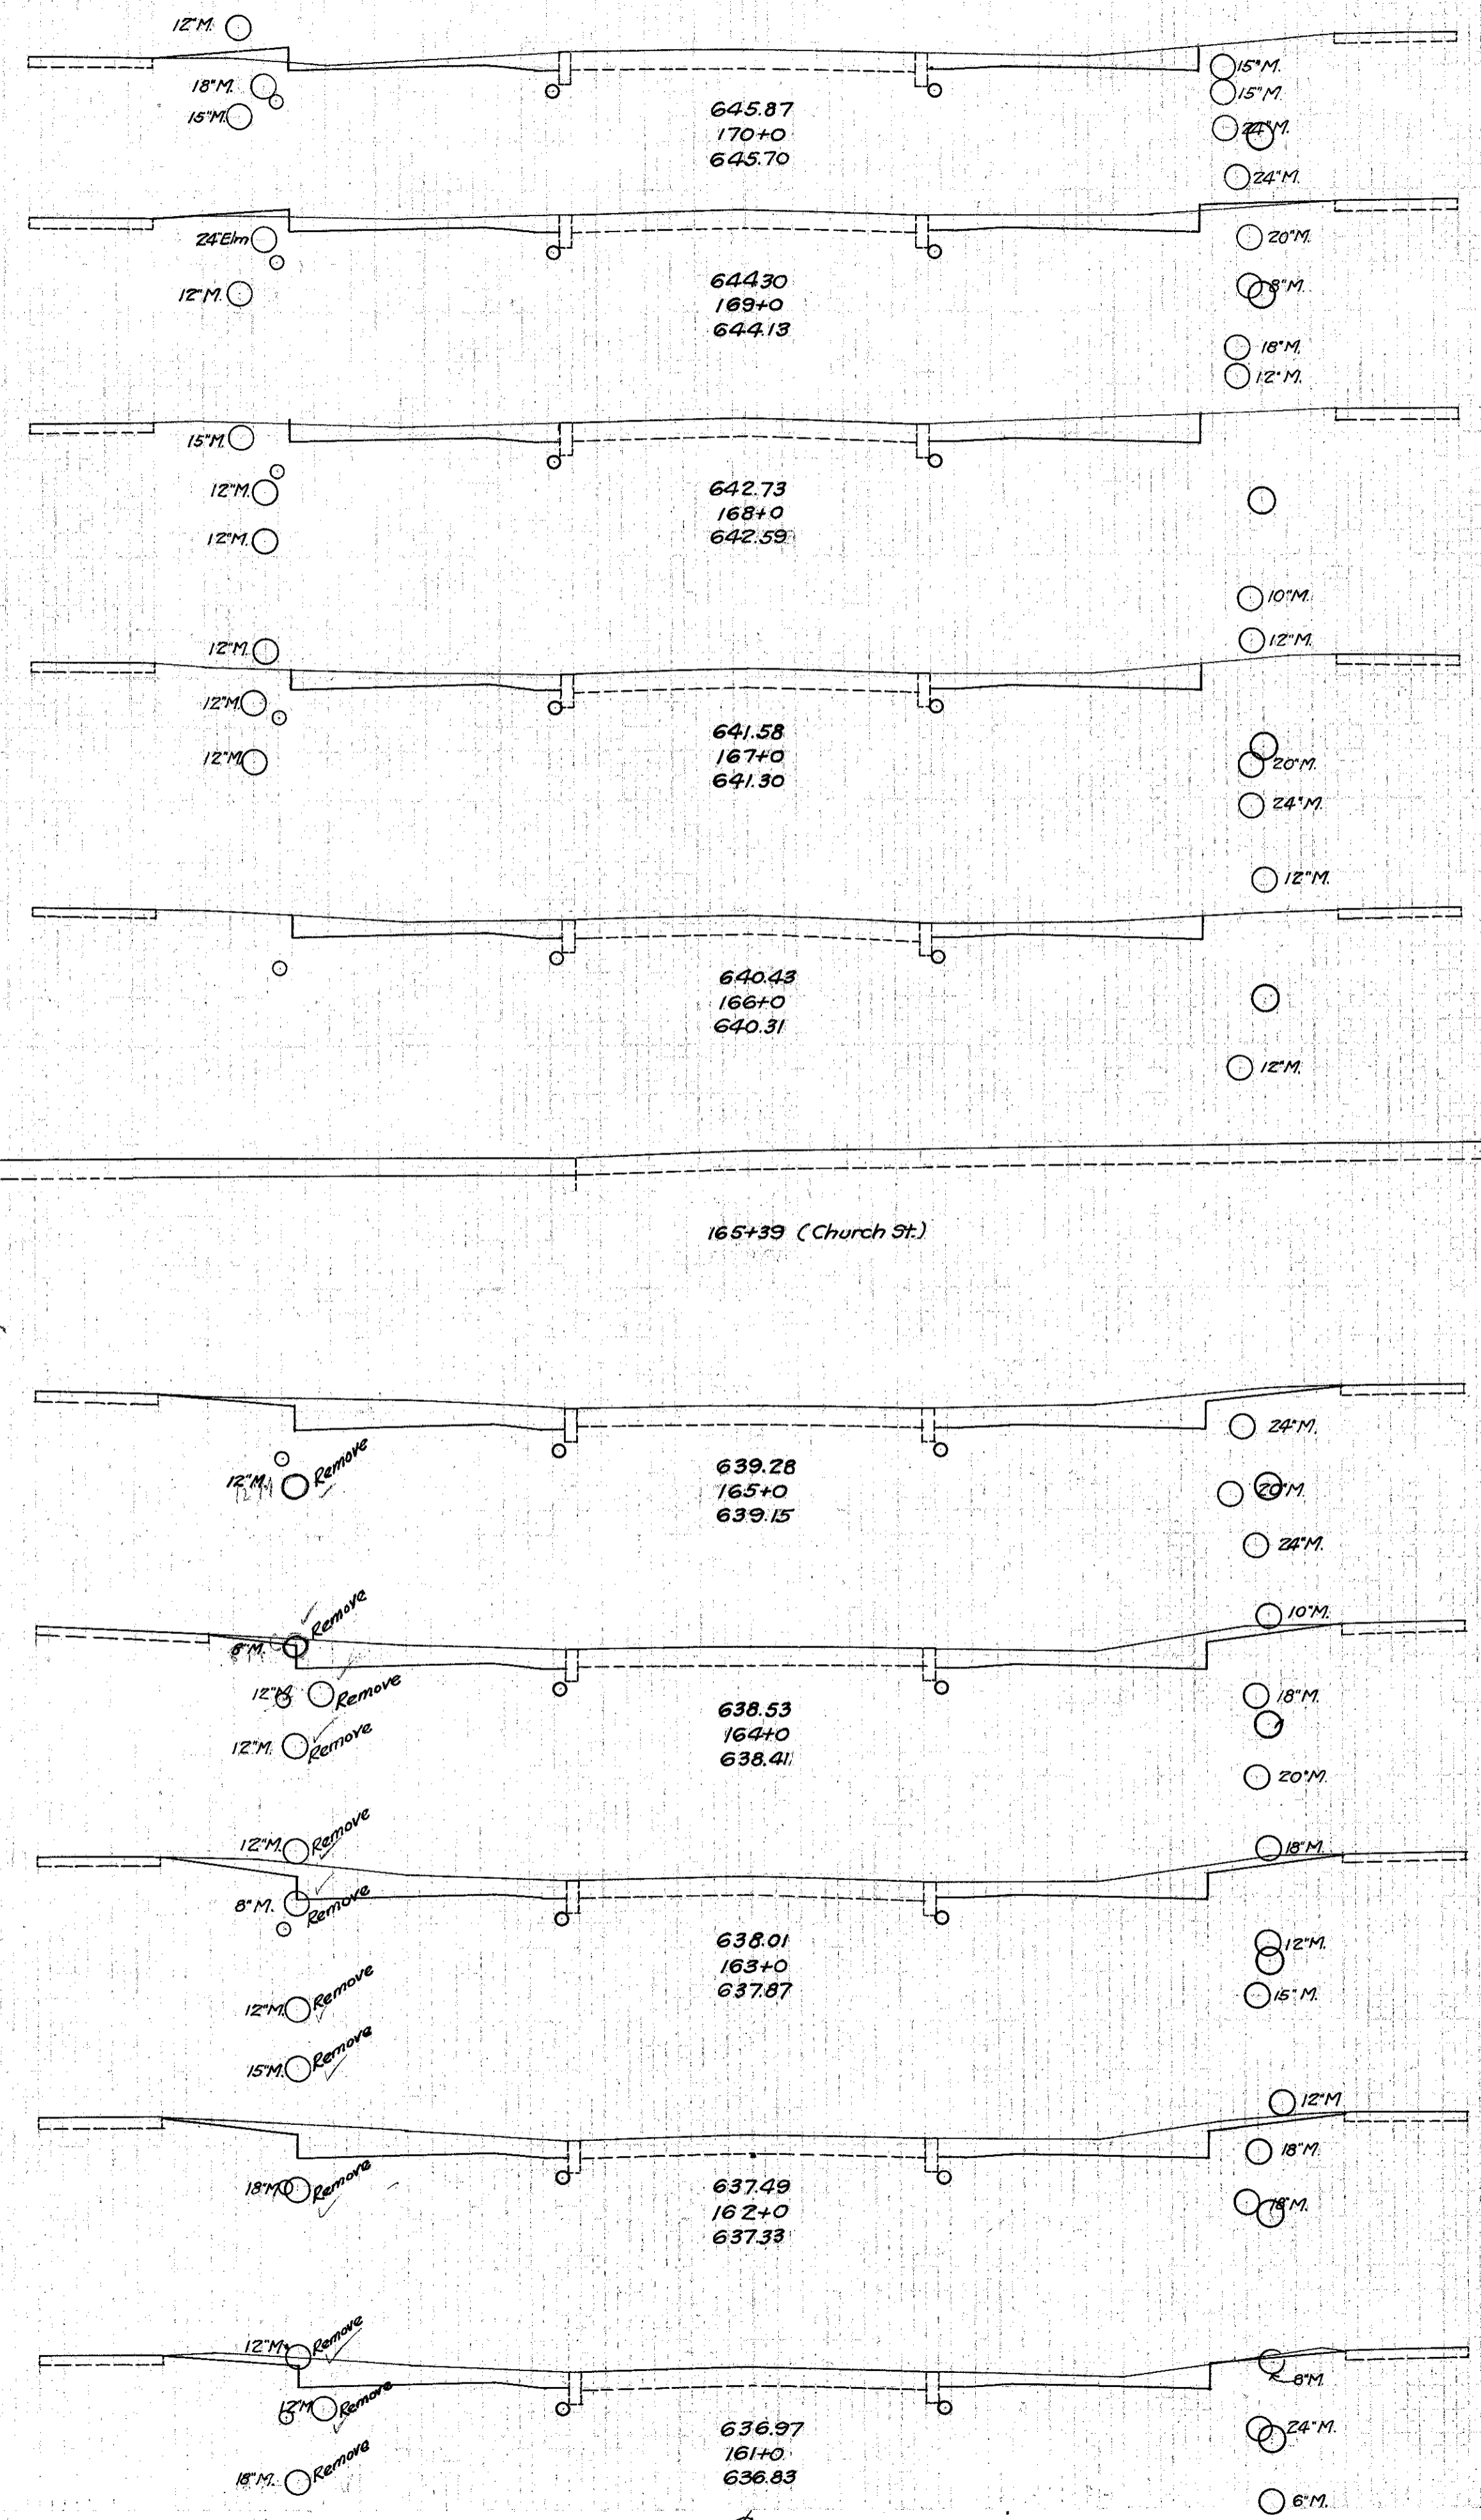

End Area	Cu. Yds.	End Area	Cu. Yds.
Cut	Fill	Cut	Fill
11.6	2.0	44.4	5.7
12.4	1.1	52.2	2.0
15.8	0.0	54.1	0.0
13.4	0.0	50.4	0.0
13.8	0.0	15.6	0.0
17.6	0.0	84.4	0.0
21.2	0.0	78.1	0.0
21.0	0.0	60.7	0.0
22.6	0.0	73.1	0.0
16.9	0.0	63.9	0.0
17.6	0.0		

Exc. 353.0 Cu. Yds.  
 Emb. 2.0  
 Emb. + 15% 2.3  
 Waste 350.7

30 25 20 15 10 5 E 5 10 15 20 25

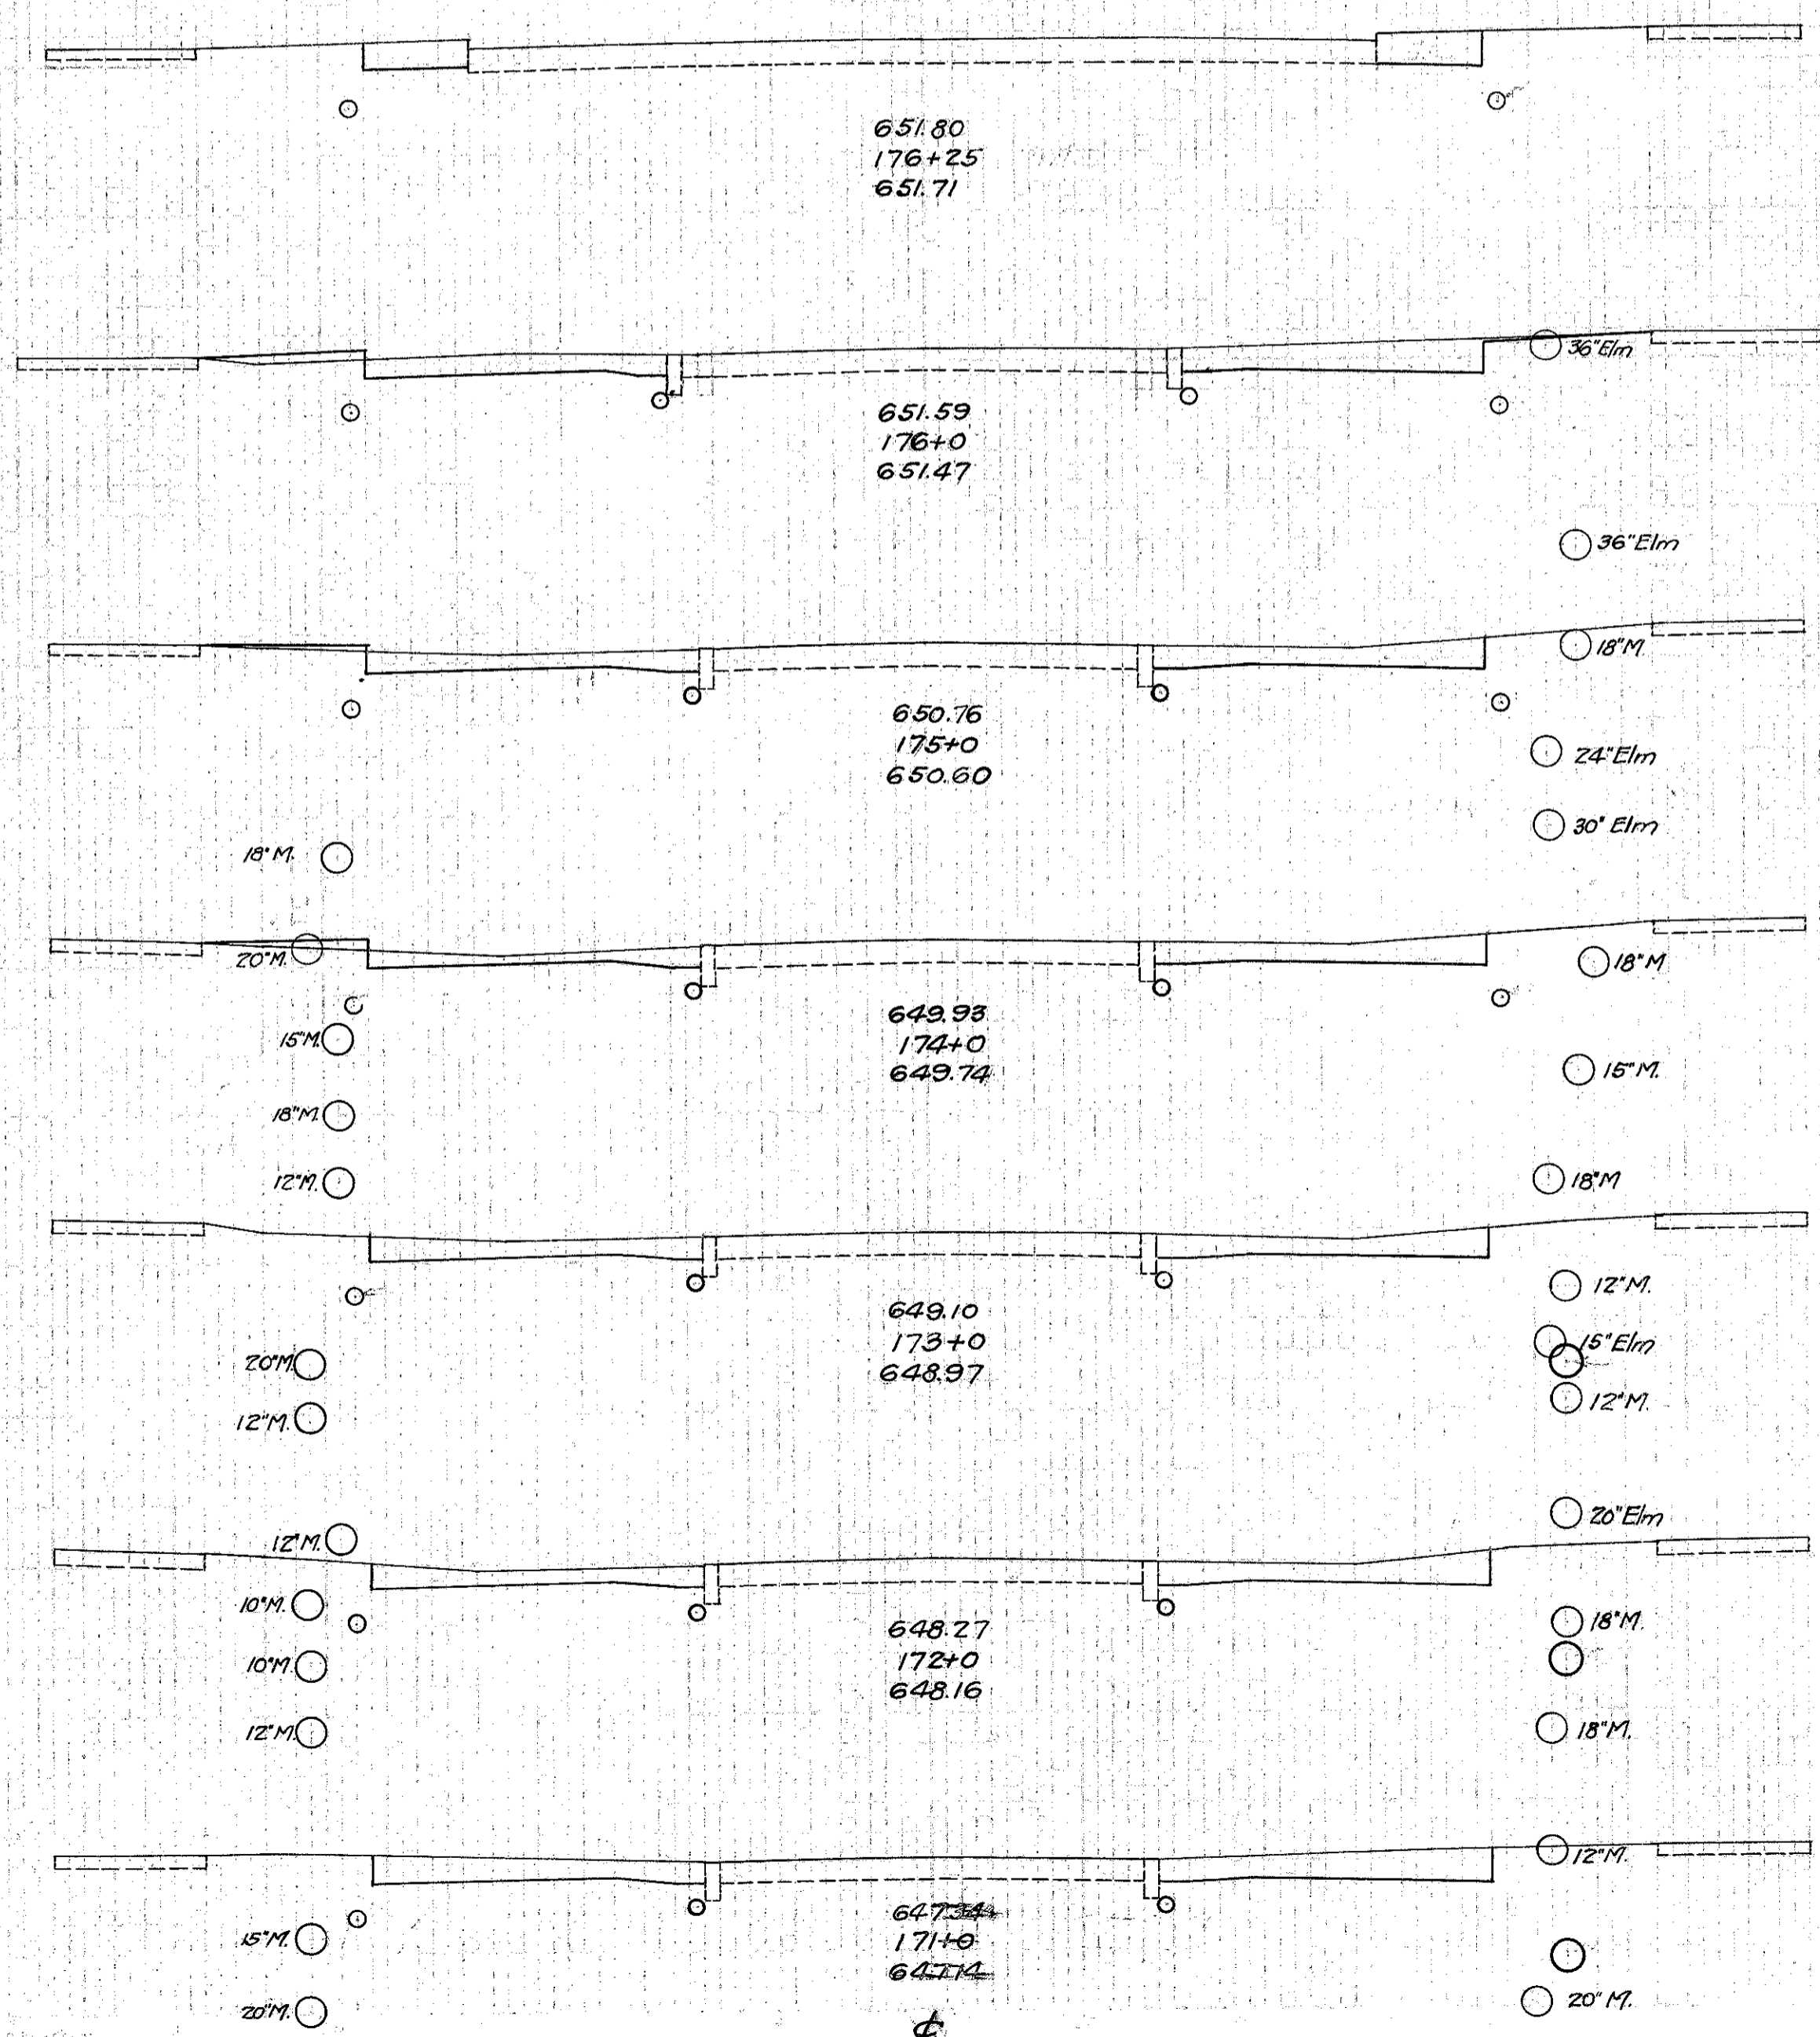

End Area	Cu. Yds.	End Area	Cu. Yds.
Cut	Fill	Cut	Fill
3.2	0.0		
11.9	0.0		
18.4	0.0		
59.3	0.6		
13.6	0.3	48.1	2.8
12.4	1.1	496	2.0
14.4	0.0		
54.1	0.0		
14.8	0.0		
61.9	0.0		
18.6	0.0		
55.9	5.7		
11.6	2.0		

Exc. 388.4 Cu. Yds.  
 Emb. 16.6  
 Emb. + 15% 19.1  
 Waste 369.3