


HORIZONTAL SCALE IN METERS

CALC. BY:  
CHECKED BY:


PLAN AND PROFILE  
EAST 360th STREET

LAK - 640 - 2865 (178)

101  
189

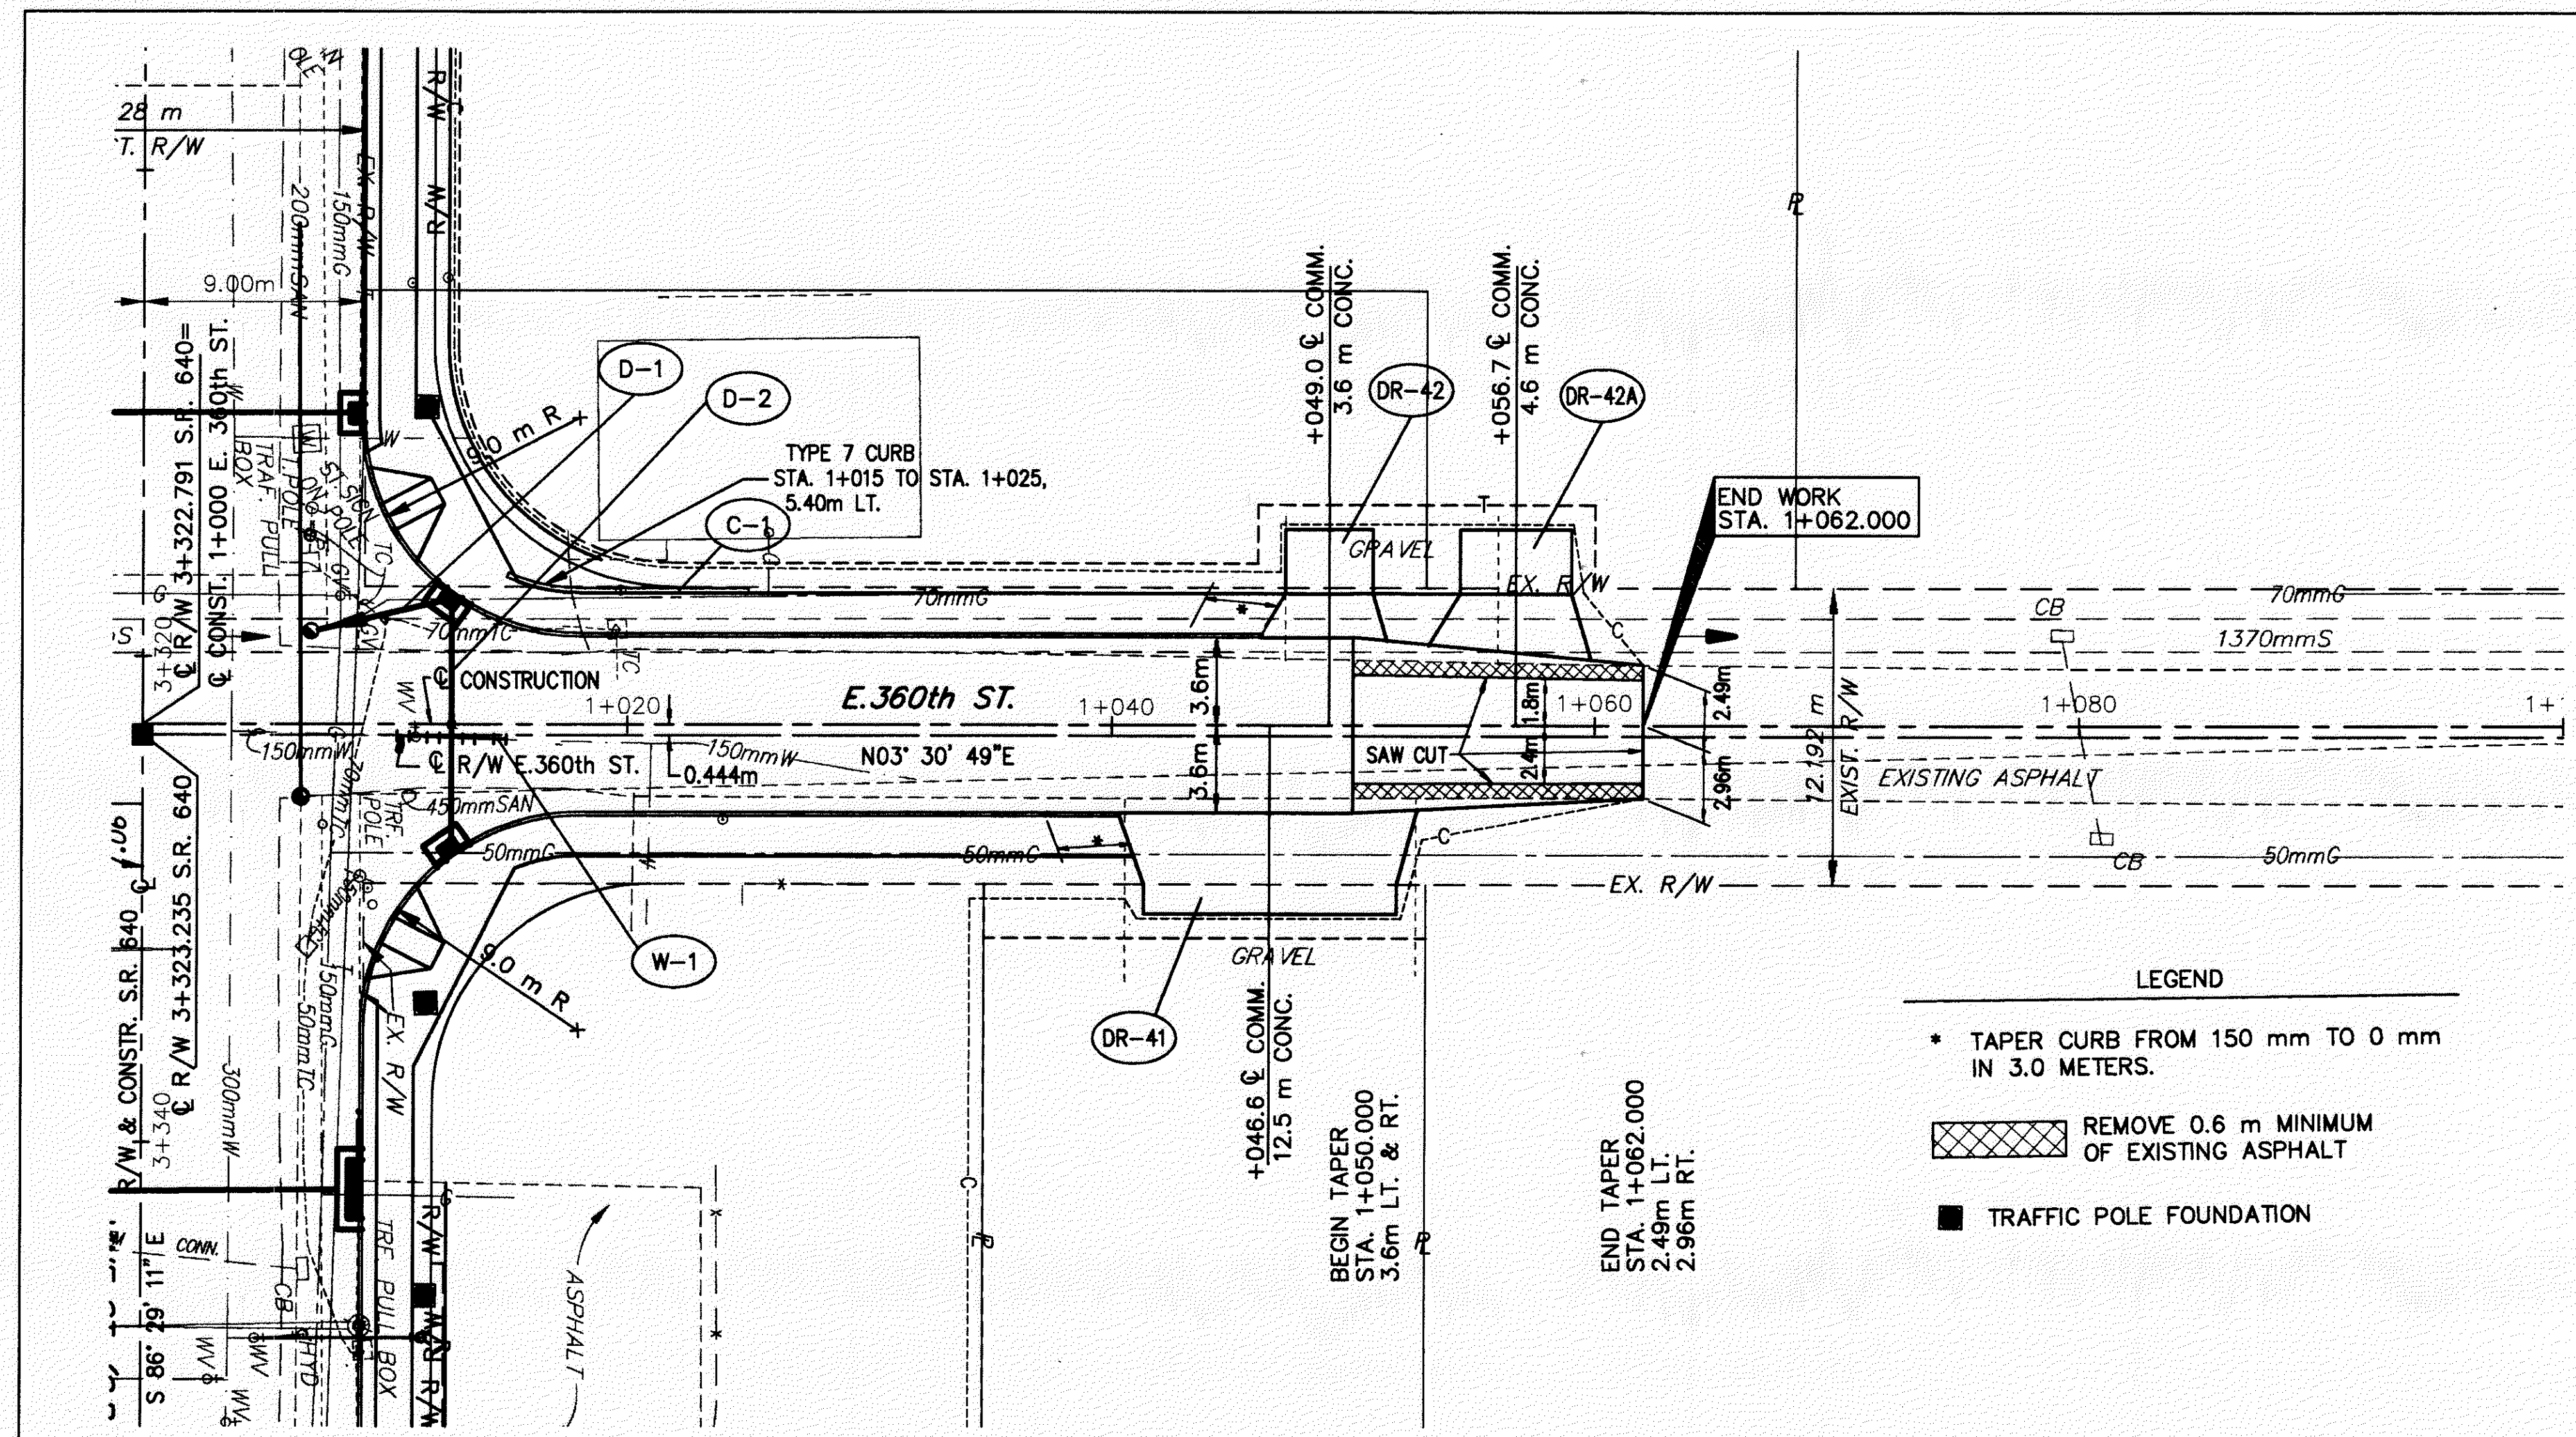

- LEGEND**
- \* TAPER CURB FROM 150 mm TO 0 mm IN 3.0 METERS.
  - REMOVE 0.6 m MINIMUM OF EXISTING ASPHALT
  - TRAFFIC POLE FOUNDATION

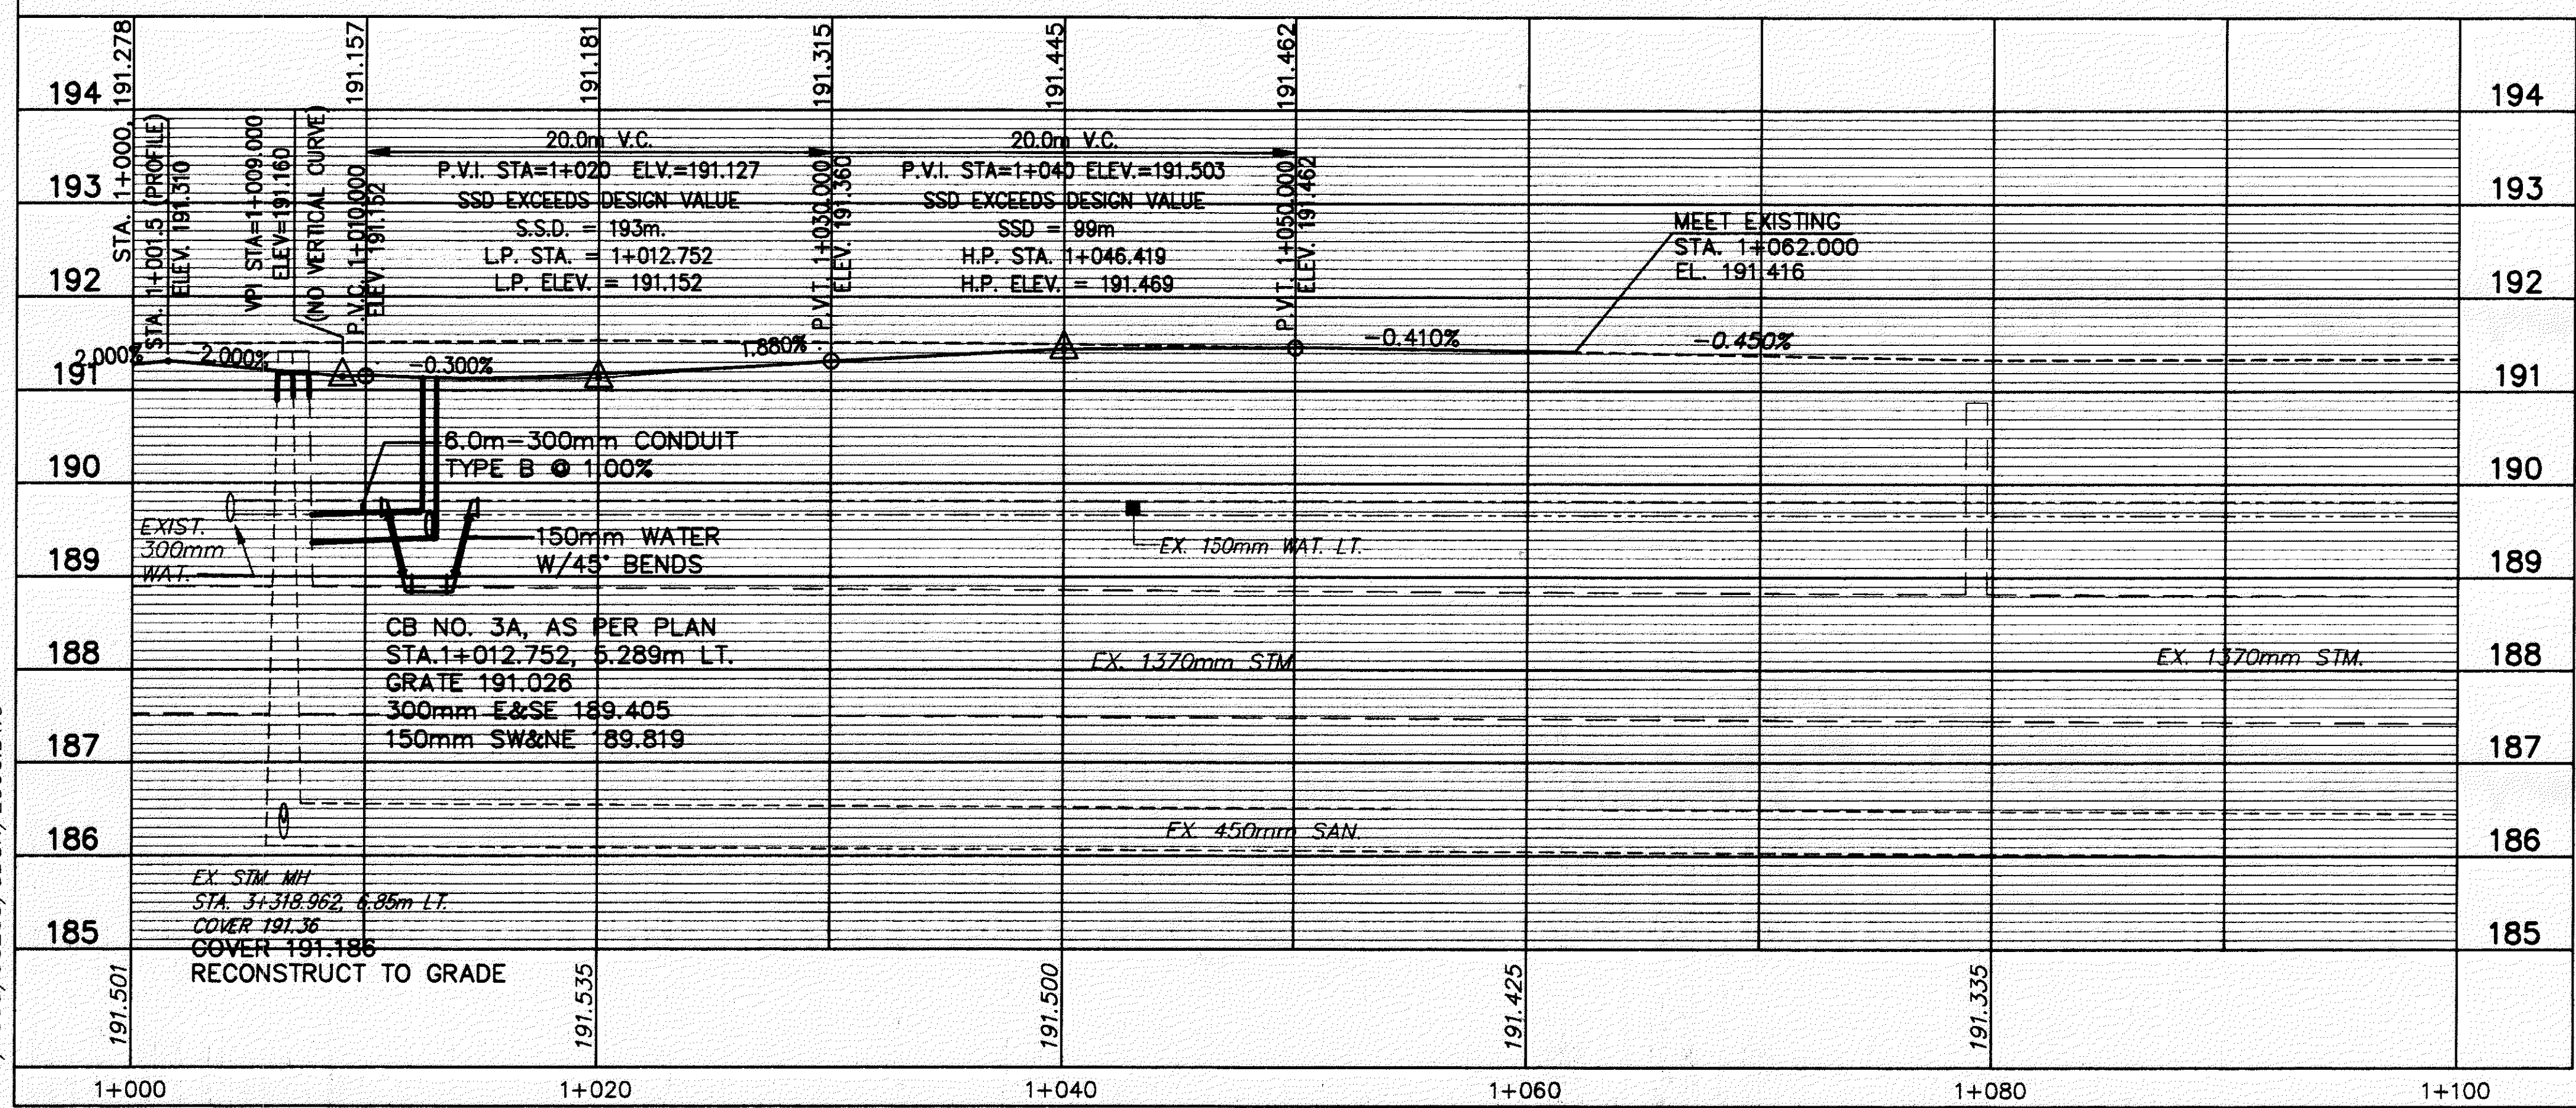

FOR TYPICAL SECTIONS, SEE SHEETS 3-7  
 FOR ROADWAY, DRAINAGE AND SANITARY QUANTITIES, SEE SHEET 102  
 FOR CROSS SECTIONS AND PIPE PROFILES, SEE SHEETS 111-122  
 FOR INTERSECTION DETAILS, SEE SHEETS 123-129  
 FOR DRIVEWAY PROFILES, SEE SHEETS 130-137  
 FOR DRIVEWAY DETAILS, SEE SHEET 138  
 FOR DRAINAGE DETAILS, SEE SHEETS 139-140  
 FOR WATER WORK DETAILS, SEE SHEETS 141-144  
 FOR MONUMENT LOCATIONS, SEE SHEET 2  
 FOR SIGNAL PLAN, SEE SHEETS 150-158  
 FOR SIGNING PLAN, SEE SHEETS 165-168  
 FOR PAVEMENT MARKING DETAILS, SEE SHEET 159-164  
 FOR SAW CUT AT EXISTING PARKING LOTS, SEE SHEET 138  
 FOR SUB-SUMMARIES, SEE SHEETS 32-43

H:\1998\98208\SDSK\E360.DWG