LAK-640-3.444(2.14)

CITY OF EASTLAKE
CITY OF WILLOUGHBY
LAKE COUNTY
T-10N & R-10W

metric units

6 ROBERT E. & ANITA DISTLER 1-2-96
8 ROBERT E. & ANITA DISTLER 1-2-96
10 JOHN R. MROZEK 11-14-86
11 RONALD M. & VALERIE L. BARE 2-24-98
12 NOT USED
14 FRANK J. & KATHLEEN L. KUHAR,TR. 10-28-94
16 K&M ENTERPRISES 6-23-81
18 NOT USED
21 LAWRENCE C. KIMBALL & PHRANIA KIMBALL 11-29-93
22 A.J.L. LTD. 11-20-97
25 JEHOVAH'S WITNESSES ASSEMBLY HALL, INC. 9-9-75
27 THE GREATER CLEVELAND CONGREGATION OF JEHOVAH'S WITNESSES, INC. 4-18-74
29 NOT USED
31 WICK MOTORS CORPORATION, AN OHIO CORPORATION 11-10-71
32 NOT USED
34 NOT USED
35 NOT USED
36 NOT USED
37 C.B.V. LTD. 9-3-98
38 JOANNE C. BHATTA 6-14-94
40 GERALDINE M. HERMAN 1-5-56
41 WILLOUGHBY CORNER LTD., AN OHIO LIMITED LIABILITY COMPANY 5-15-97

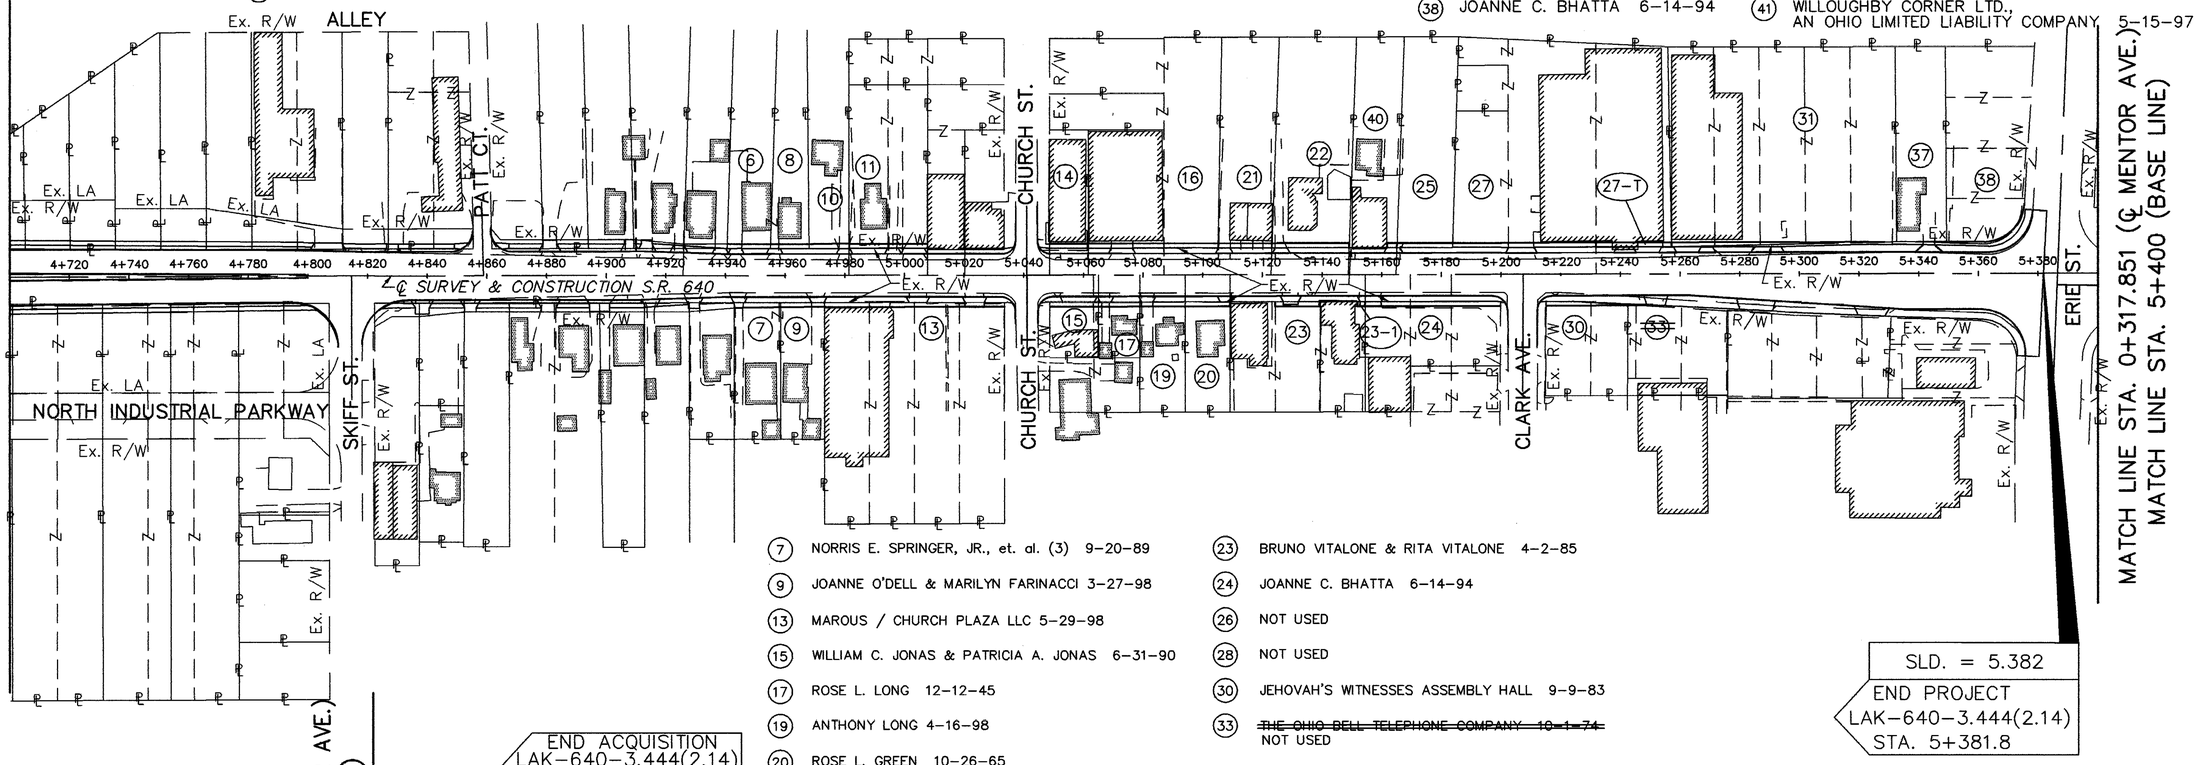

7 NORRIS E. SPRINGER, JR., et. al. (3) 9-20-89
9 JOANNE O'DELL & MARILYN FARINACCI 3-27-98
13 MAROUS / CHURCH PLAZA LLC 5-29-98
15 WILLIAM C. JONAS & PATRICIA A. JONAS 6-31-90
17 ROSE L. LONG 12-12-45
19 ANTHONY LONG 4-16-98
20 ROSE L. GREEN 10-26-65
23 BRUNO VITALONE & RITA VITALONE 4-2-85
24 JOANNE C. BHATTA 6-14-94
26 NOT USED
28 NOT USED
30 JEHOVAH'S WITNESSES ASSEMBLY HALL 9-9-83
33 ~~THE OHIO BELL TELEPHONE COMPANY 10-1-74~~ NOT USED

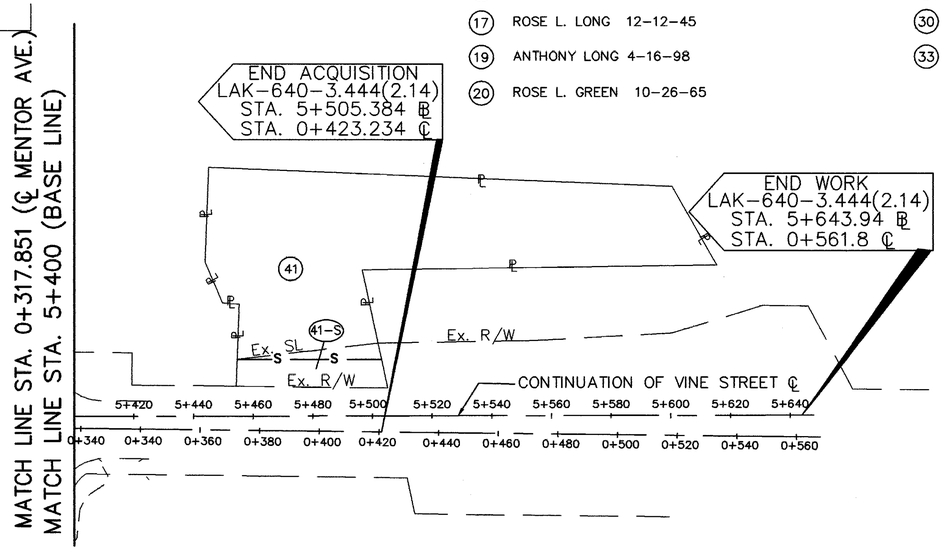

STRUCTURE KEY:

RESIDENTIAL BUILDING
COMMERCIAL BUILDING

REV.	DATE	DESCRIPTION
	10/14/98	PL,R/W,LA,LOT LINES,etc.
	04/24/2000	Parcel 33 is no longer needed and is now marked Not Used.
DATE OF COMPLETION		

1:1000 RATIO IN METERS

PID NO. 13722

STATE JOB NO. 124390

PROPERTY MAP
STA. 4+700 TO STA. 5+643.94

LAK-640-3.444(2.14)

213C / 214