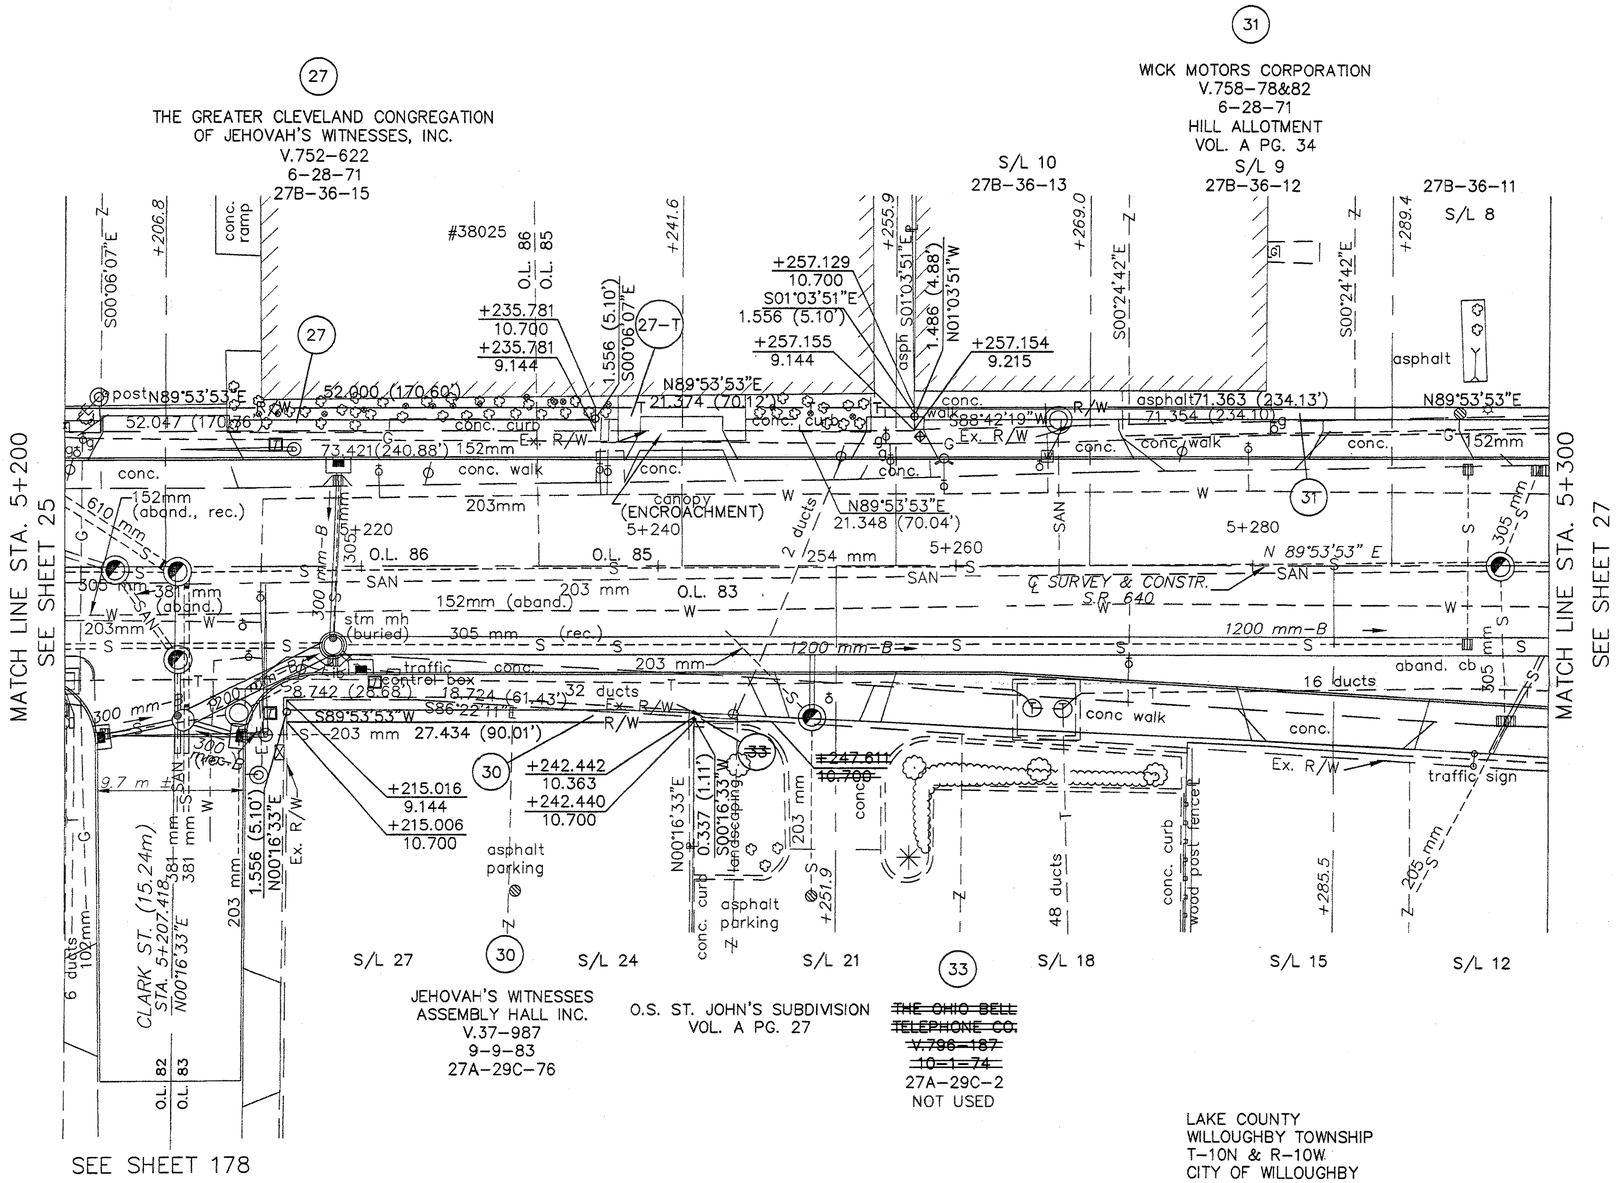

NOTES: BASIS OF BEARING FOR THIS PROJECT IS AS ESTABLISHED ON PRIOR PROJECT PLANS LAK-2-0.00.

EXISTING RIGHT OF WAY LOCATION AND WIDTH DETERMINED USING RIGHT OF WAY PLAN SH. NOS. 79 AND 80 FROM PRIOR PROJECT PLANS LAK-20-5.54: OR BEING 60 FEET WIDE AS ORIGINALLY ESTABLISHED AND REFERENCED ON LAKE COUNTY PLAT RECORDS VOL. A PG. 27.

DIMENSIONS SHOWN ABOVE:

~~* S86°22'11"E 5.180 (16.99')~~
~~** S89°53'53"W 5.171 (16.97')~~

⊕ N01°03'51"W 0.071 (0.24')

REV.	DATE	DESCRIPTION
	04/24/2000	Parcel 33 is no longer needed and is now marked Not Used.

DATE OF COMPLETION

metric units

1:200 RATIO IN METERS

PID NO. 13722

STATE JOB NO. 124390

RIGHT OF WAY PLAN
STA. 5+200 TO STA. 5+300

LAK-640-3.444(2.14)

26/29

213Y
214