
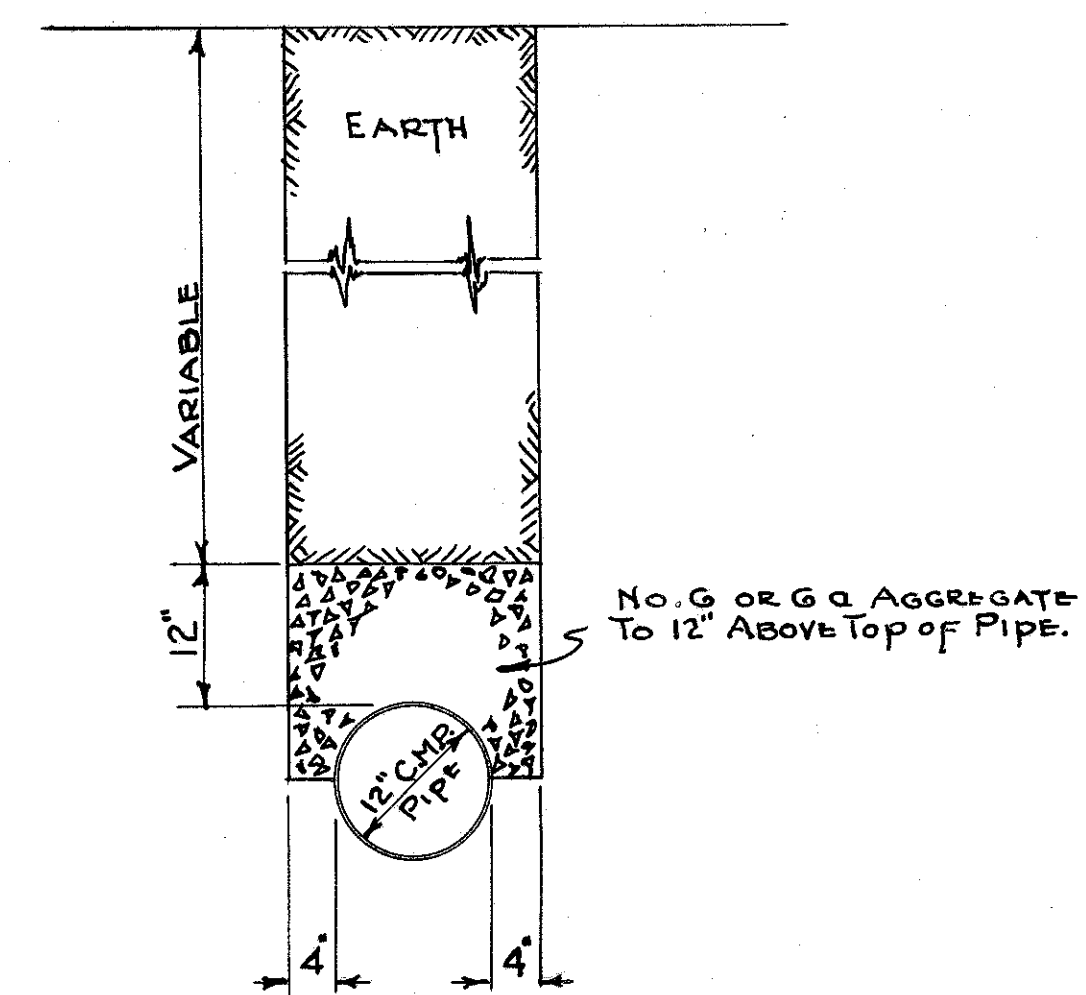


FED. RD. DIST. NO.	STATE	PROJECT	FISCAL YEAR	6 15
2	OHIO	H.I.F.	1947	

LAKE COUNTY
LAK-84-(5.86-5.97)

LAKE COUNTY

EXTRA AREA DETAIL
INTERSECTION S.R.#174 & S.R.#84
SCALE 1"=20'

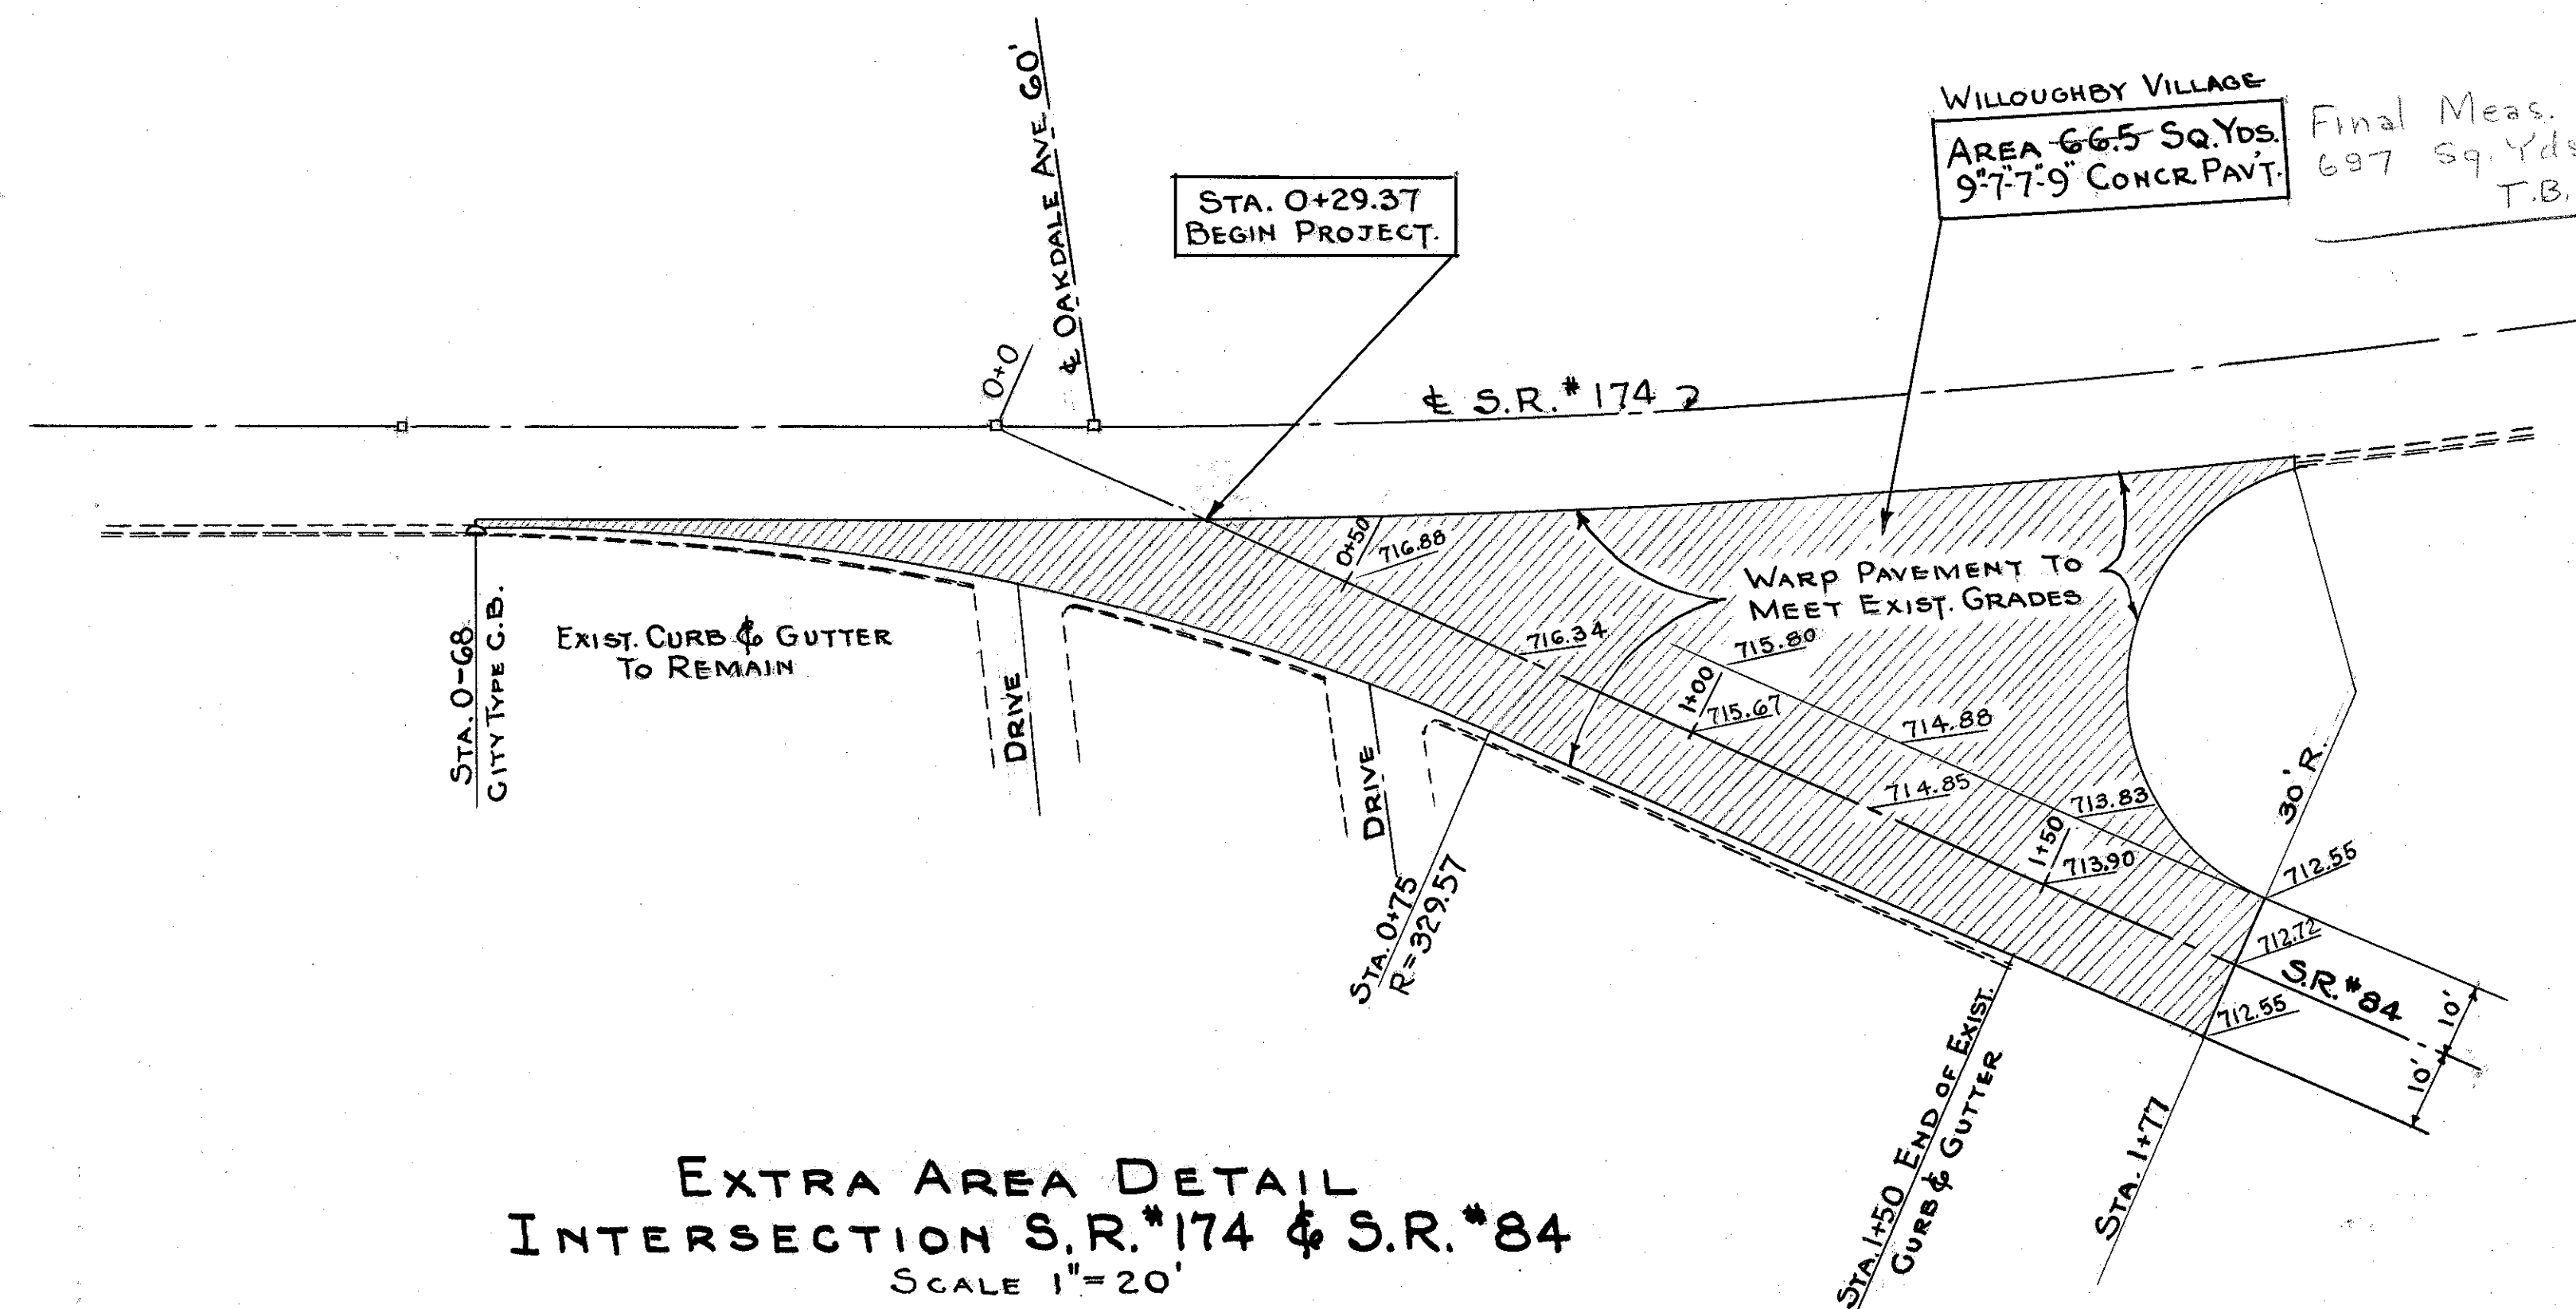

SECTION THRU OUTLET PIPE
FOR UNDERDRAIN.