


SEEDING
 END WIDTH
 104
 461
 62
 436
 95
 517
 91
 112

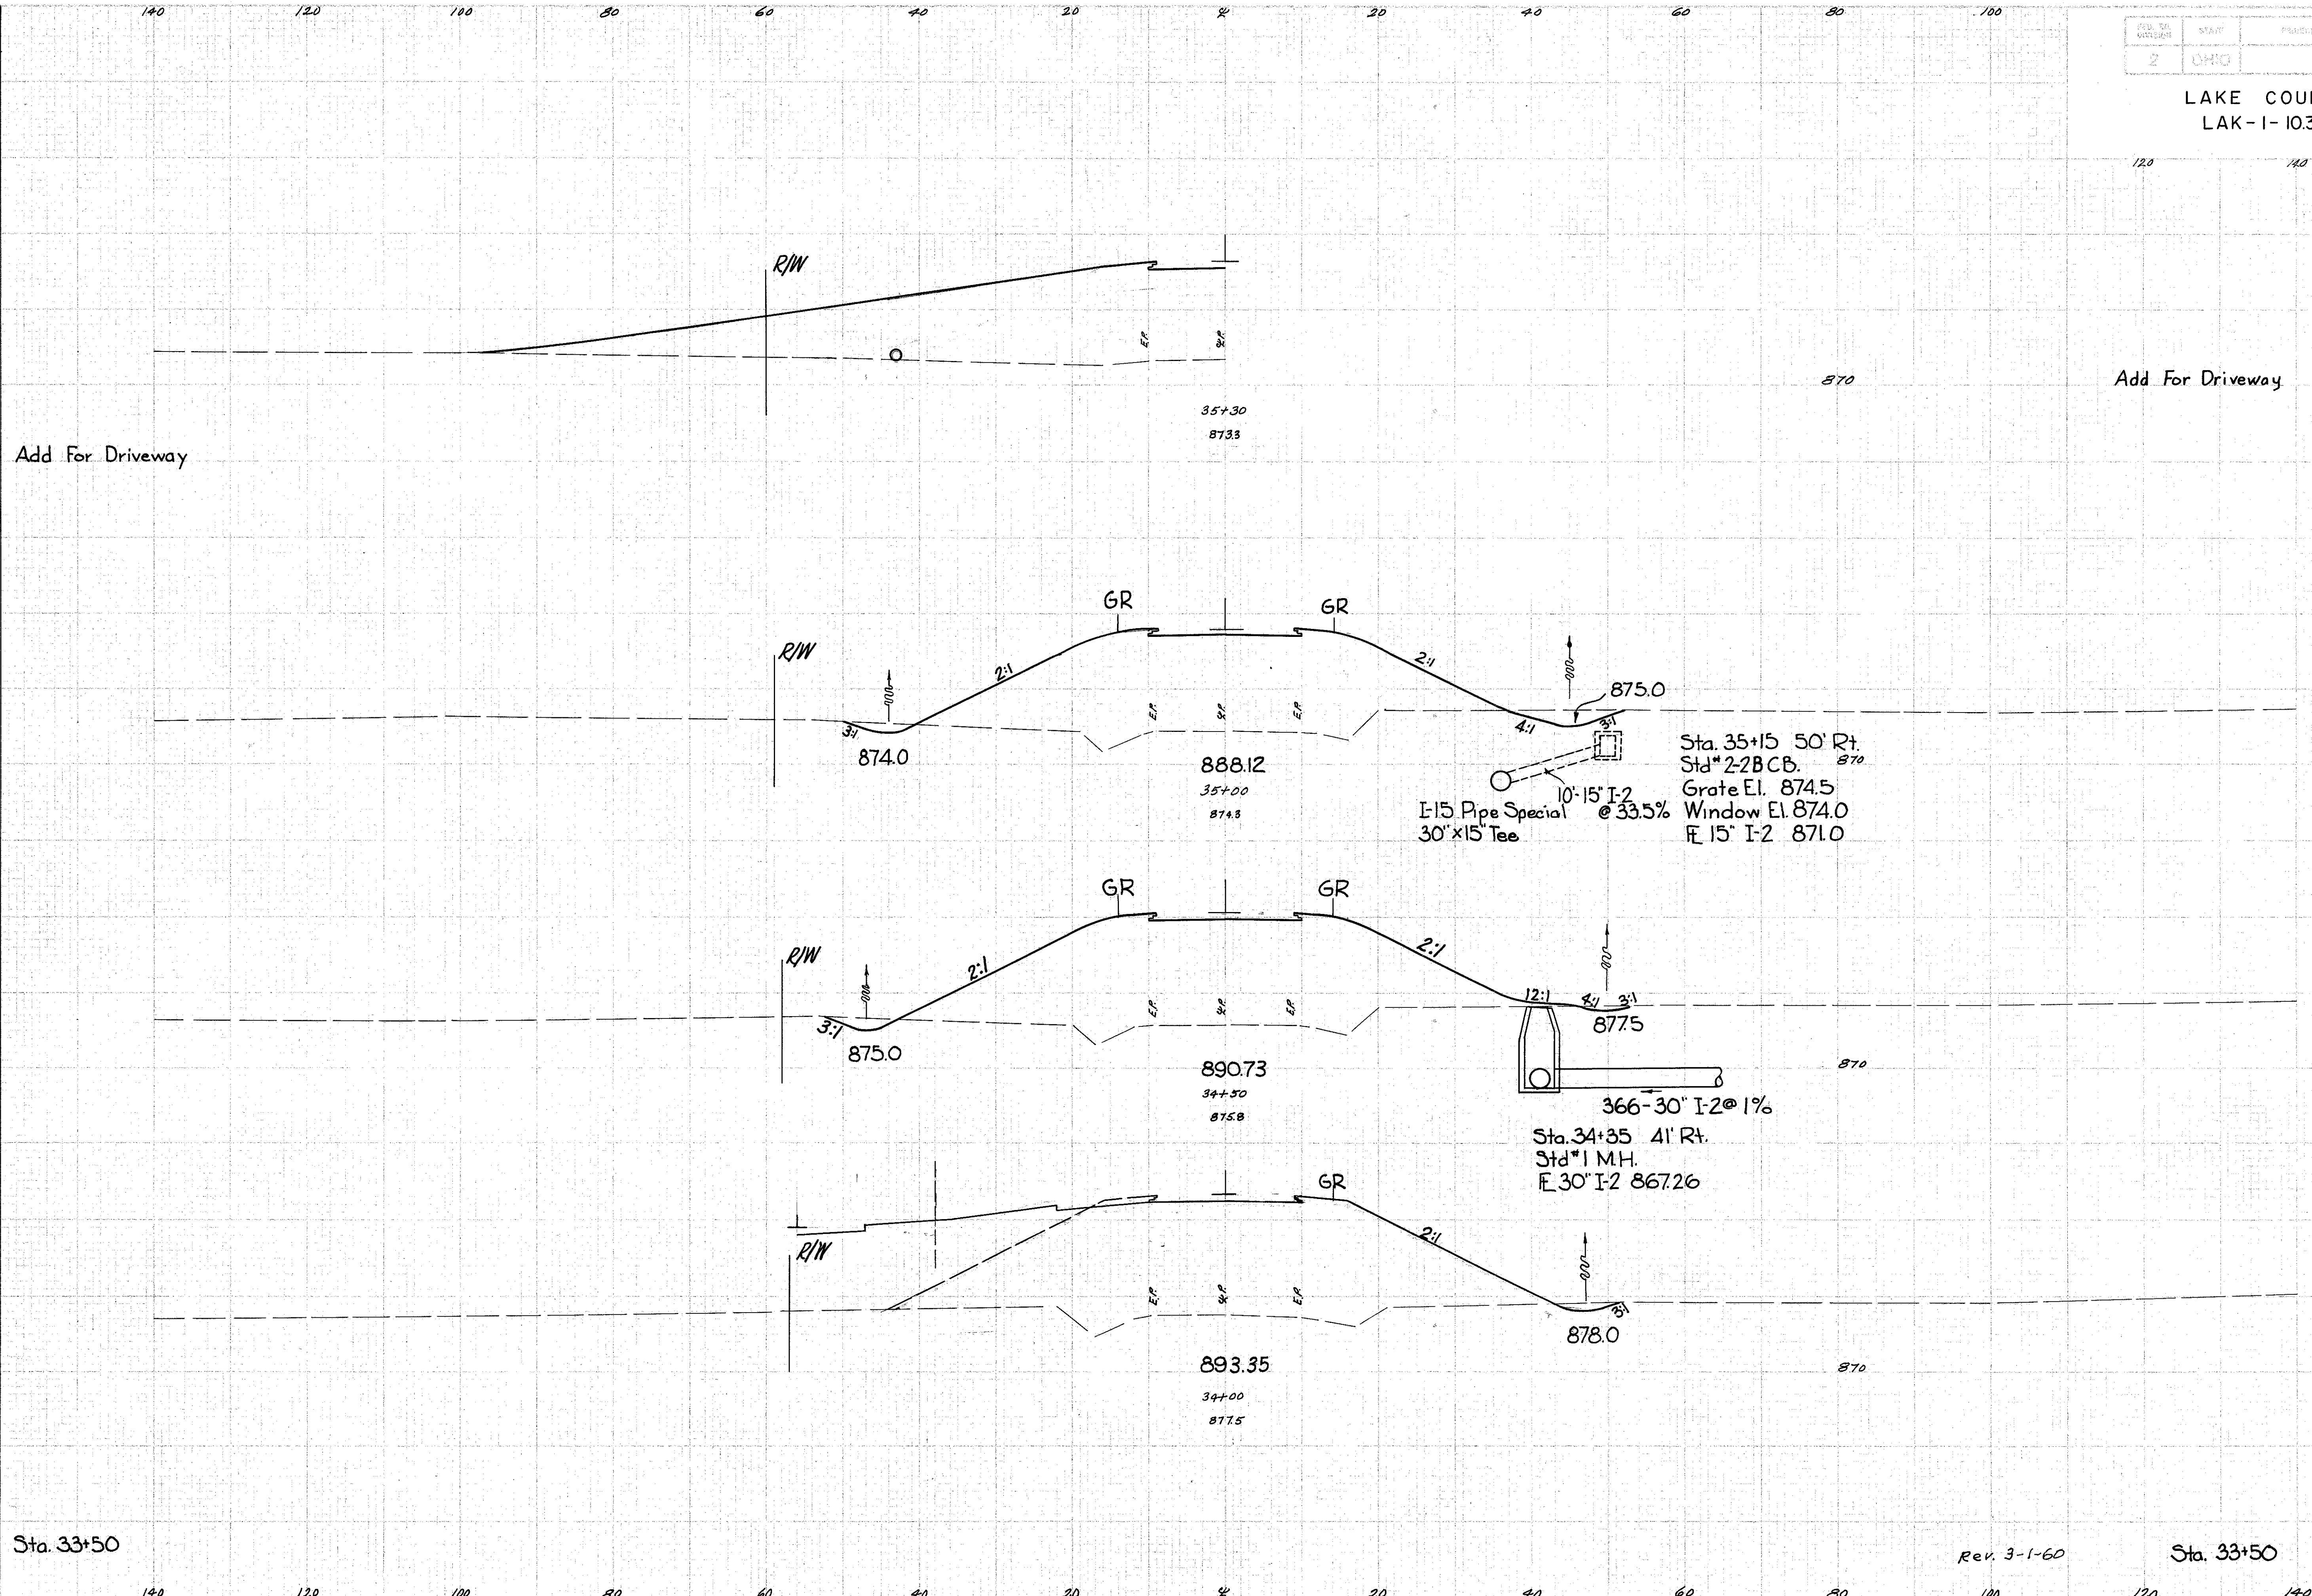

END AREA		CU. YDS.	
Cut	Fill	Cut	Fill
			174
		26	712
		35	1419
		12	820
		17	1589
		6	896
		6	1826
		1	1076

Sta. 33+50 Rev. 3-1-60 Sta. 33+50