


LAKE COUNTY
ASHTABULA COUNTY
LAK-1-12.89
ATB-1-0.00

Dc = 0°28'0"


P.T.

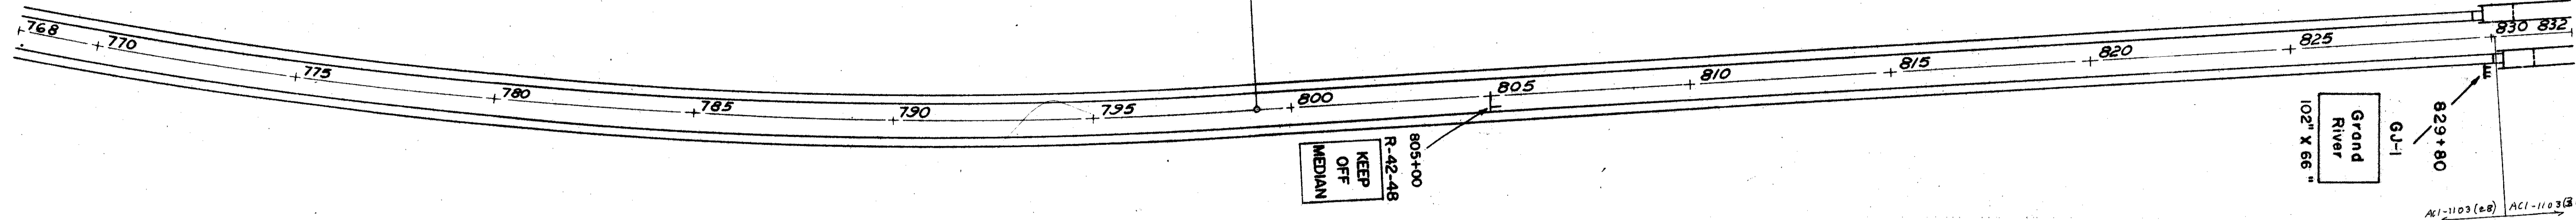

ACI-1103(e8) ACI-1103(29)


QUANTITIES

STATION	CODE NUMBER AND SIZE				SUPPORTS	1.12" D.P. BRC.		
	GJ-1 102" X 66"	R-16-48 48' X 60'	R-42-48 48' X 60'	R-43-48 48' X 60'		PCS.	TOT.	CONC.
	EA.	EA.	EA.	EA.	# BEAM FT.	EA.-FT.	FT.	CU. YDS.
829+80	1				185			4.8
839+00	1				190			4.8
805+00			1		185	2 @ 3.33	6.66	.16
848+25		X			185	2 @ 3.33	6.66	.16
847+65		X			185	2 @ 3.33	6.66	.16
870+00			1		185	2 @ 3.33	6.66	.16
880+00			1		185	2 @ 3.33	6.66	.16
TOTALS	2	X	2	1	175.5 2425		33.30 19.98	.78 1.44

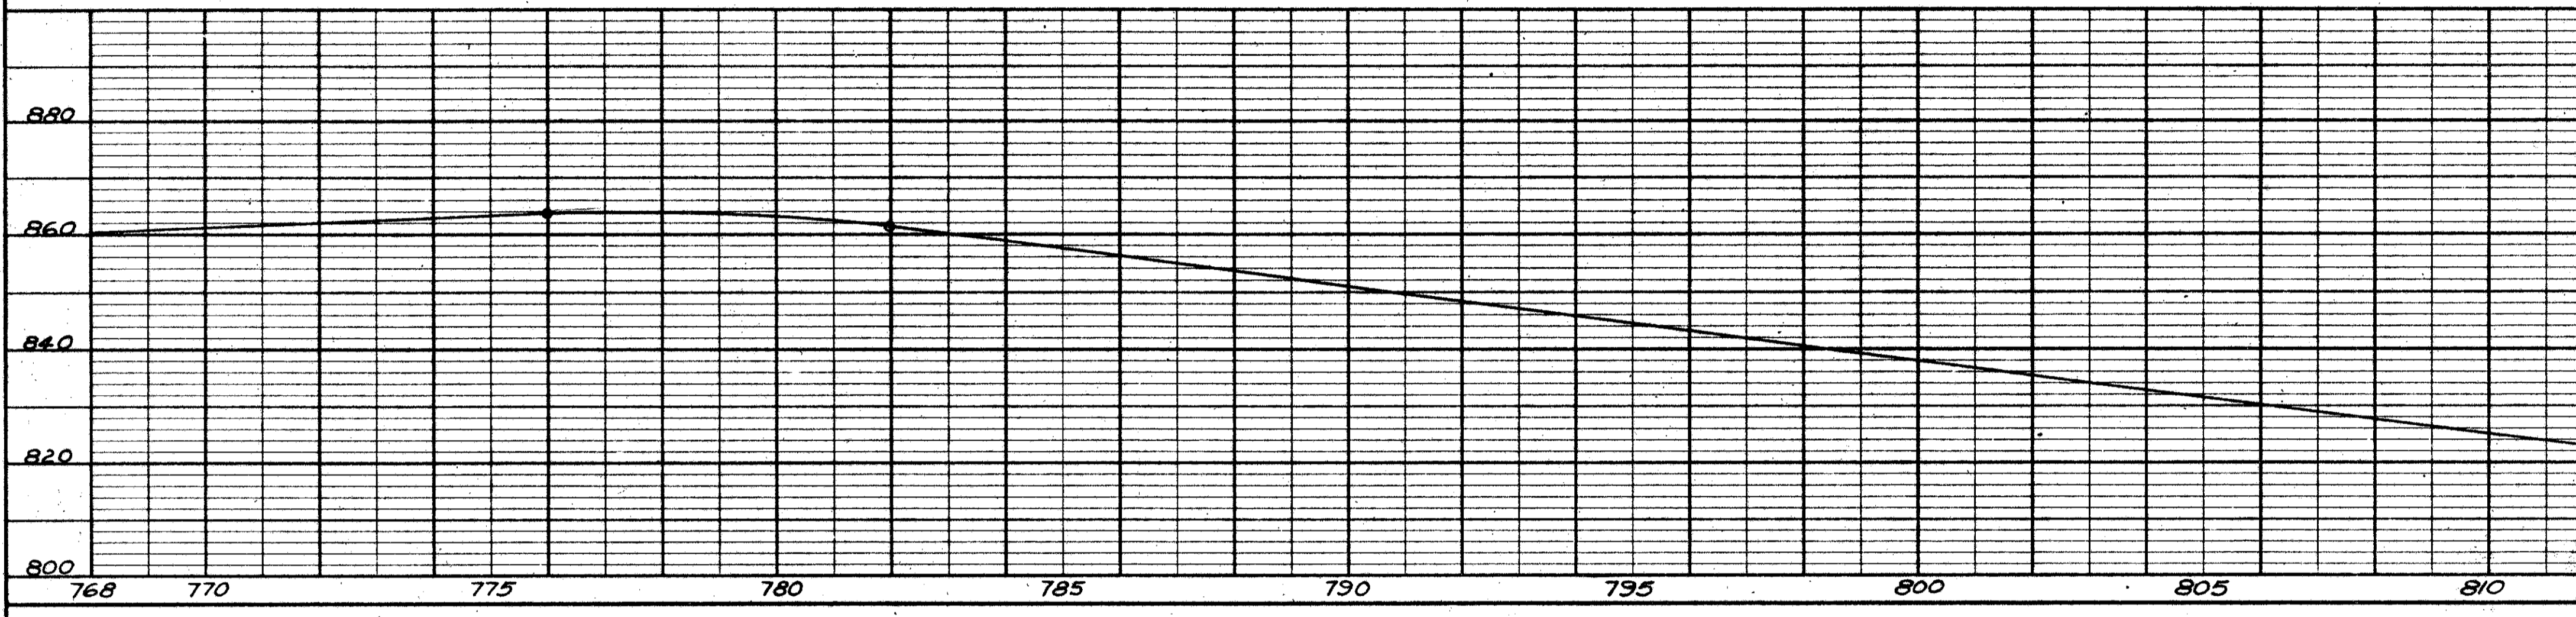


DATE _____ BY _____
SURVEYED _____
NOTE BOOK _____
ALIGNMENT CHECKED _____
RT. OF WAY CHECKED _____
NO. _____

PLAN

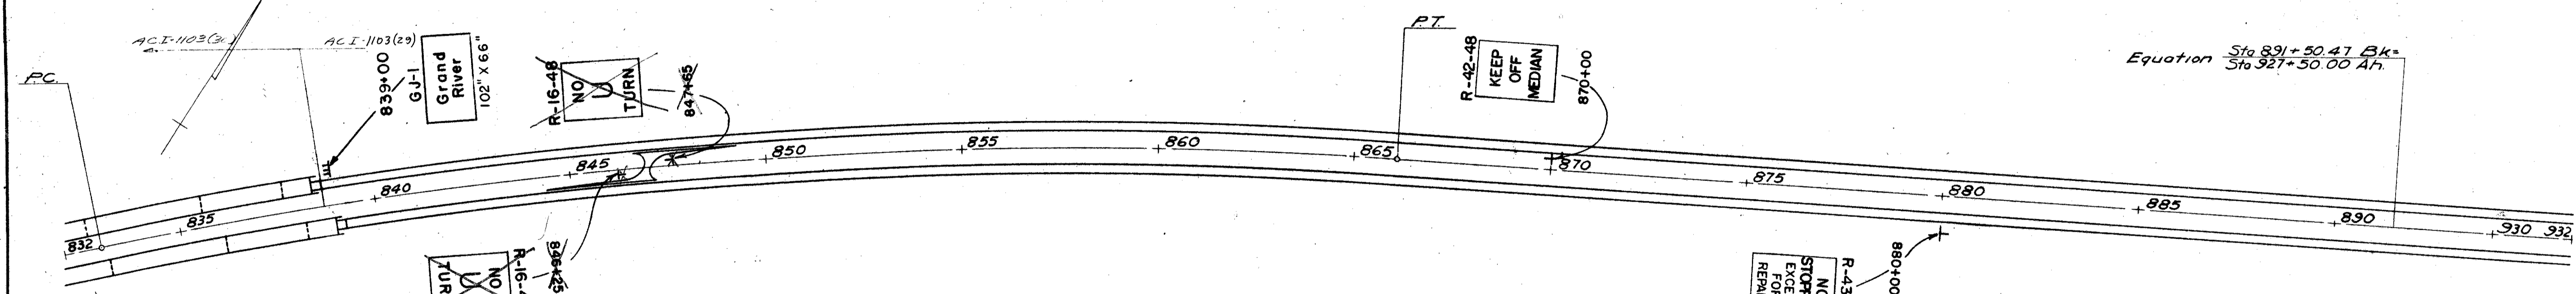

Equation Sta 891+50.41 Bk =
Sta 927+50.00 Ah.

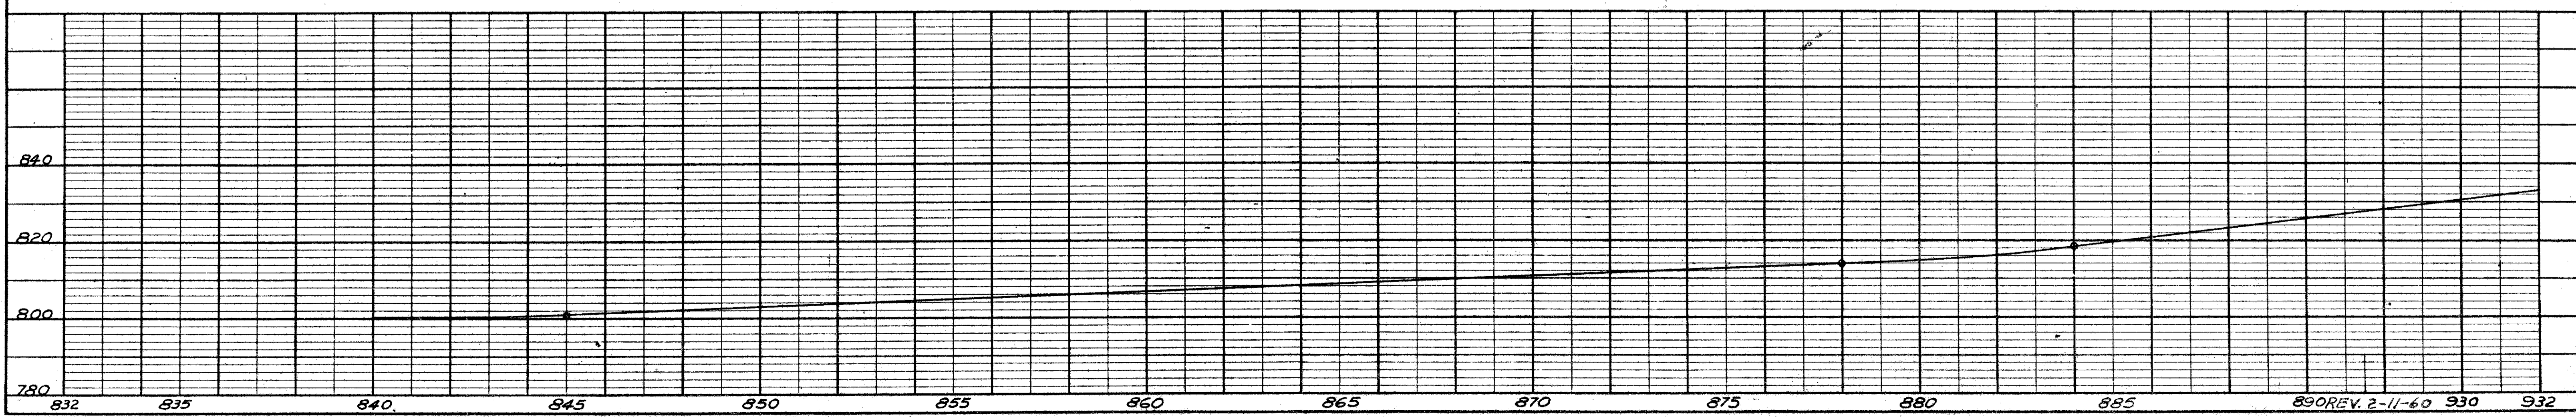

DATE _____ BY _____
SURVEYED _____
NOTE BOOK _____
GRADES CHECKED _____
B. N.S. NOTED _____
STRUCTURE NOTATIONS CH'KD _____
NO. _____

PROFILE