


LAKE COUNTY
 ASHTABULA COUNTY
 LAK-1-12.89
 ATB-1-0.00

NOTE: SEE SHEET 26 FOR INTERCHANGE QUANTITIES.

RAMP	DELINEATOR LOCATION		POST MTD.	
	FROM	TO	C-2(•2)	C-3(•3)
E	9+50	2+95	X	
	4+05	589+40	X	22
F	629+65	5+35	X	
	4+35	0+35	X	20
G	1+00	8+60	X	
	8+00	630+50	X	24
H	631+50			I
	587+94	7+50	X	
	6+50	11+50	X	20

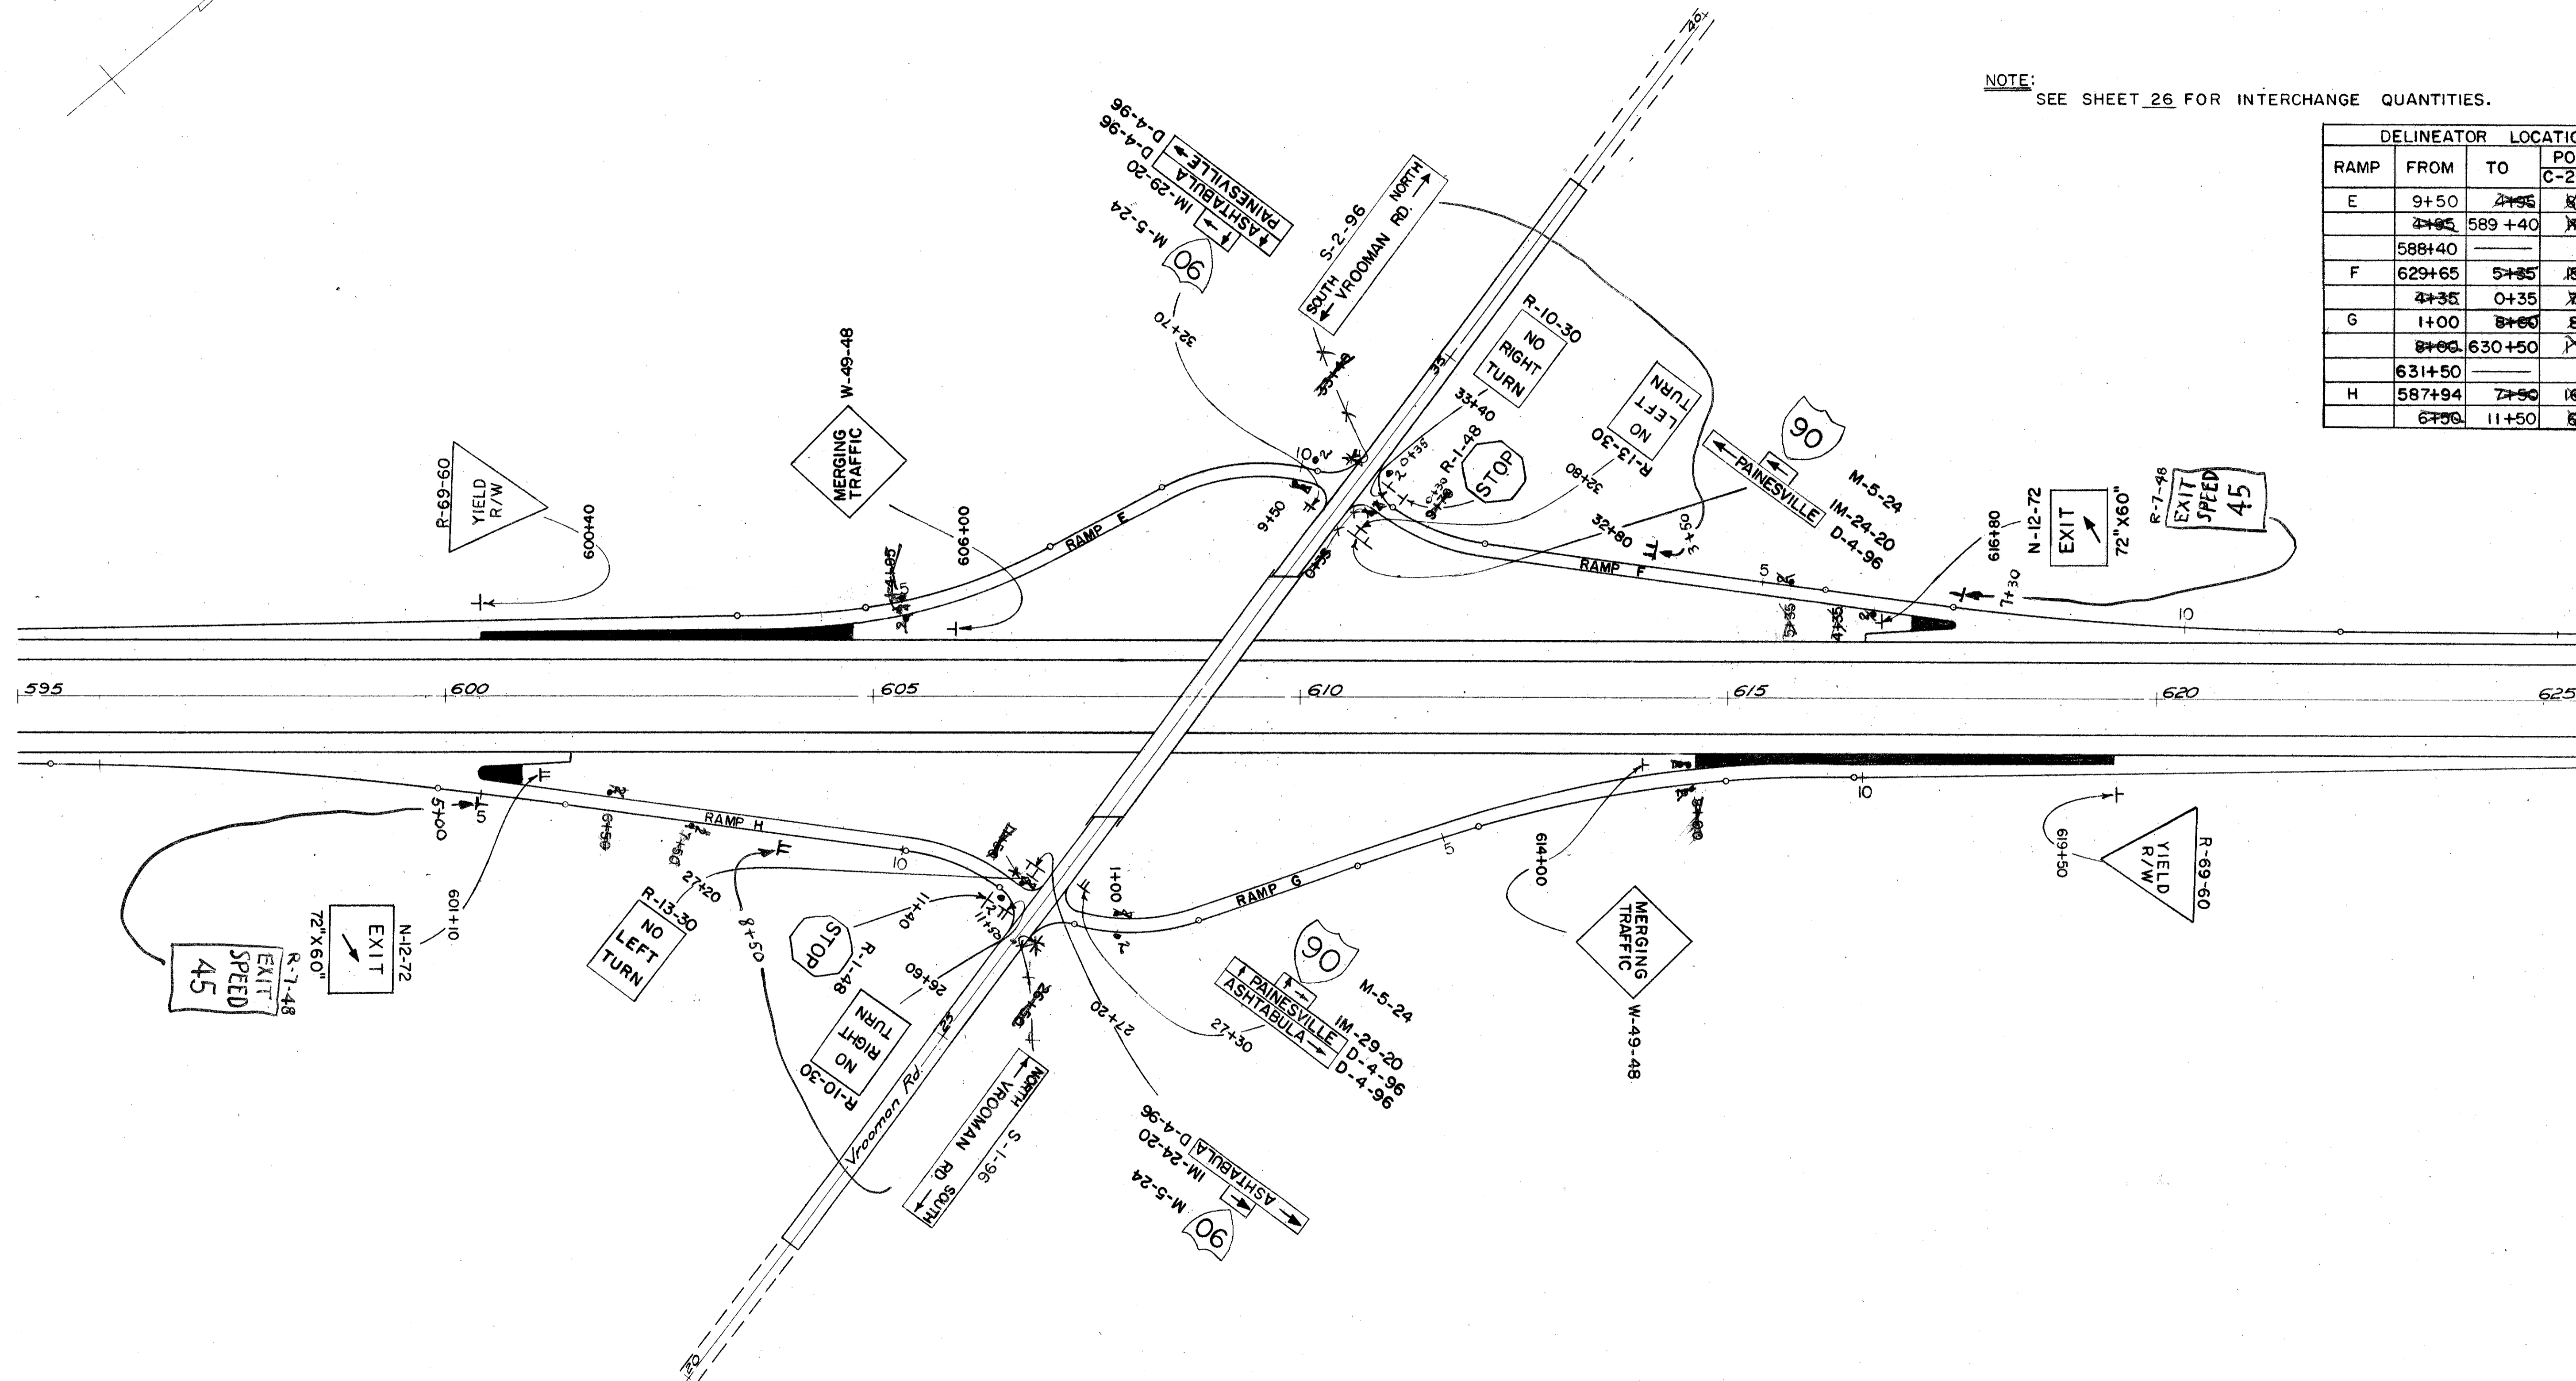

0 50' 100'
 Scale in Feet