


RAMP	DELINEATOR LOCATION		POST	MTD.
	FROM	TO		
I	1027+41	6+60	C-2(2)	C-3(3)
	5+50	12+40	78	
J	12+80	3+80	8	
	7+50	1028+55	2476	
K	15+65	3+00	78	
	6+00	1+00	19	1
L	0+75	8+70	8	
	8+70	16+26	2318	
	17+26			1

NOTE: SEE SHEET 29 FOR INTERCHANGE QUANTITIES.

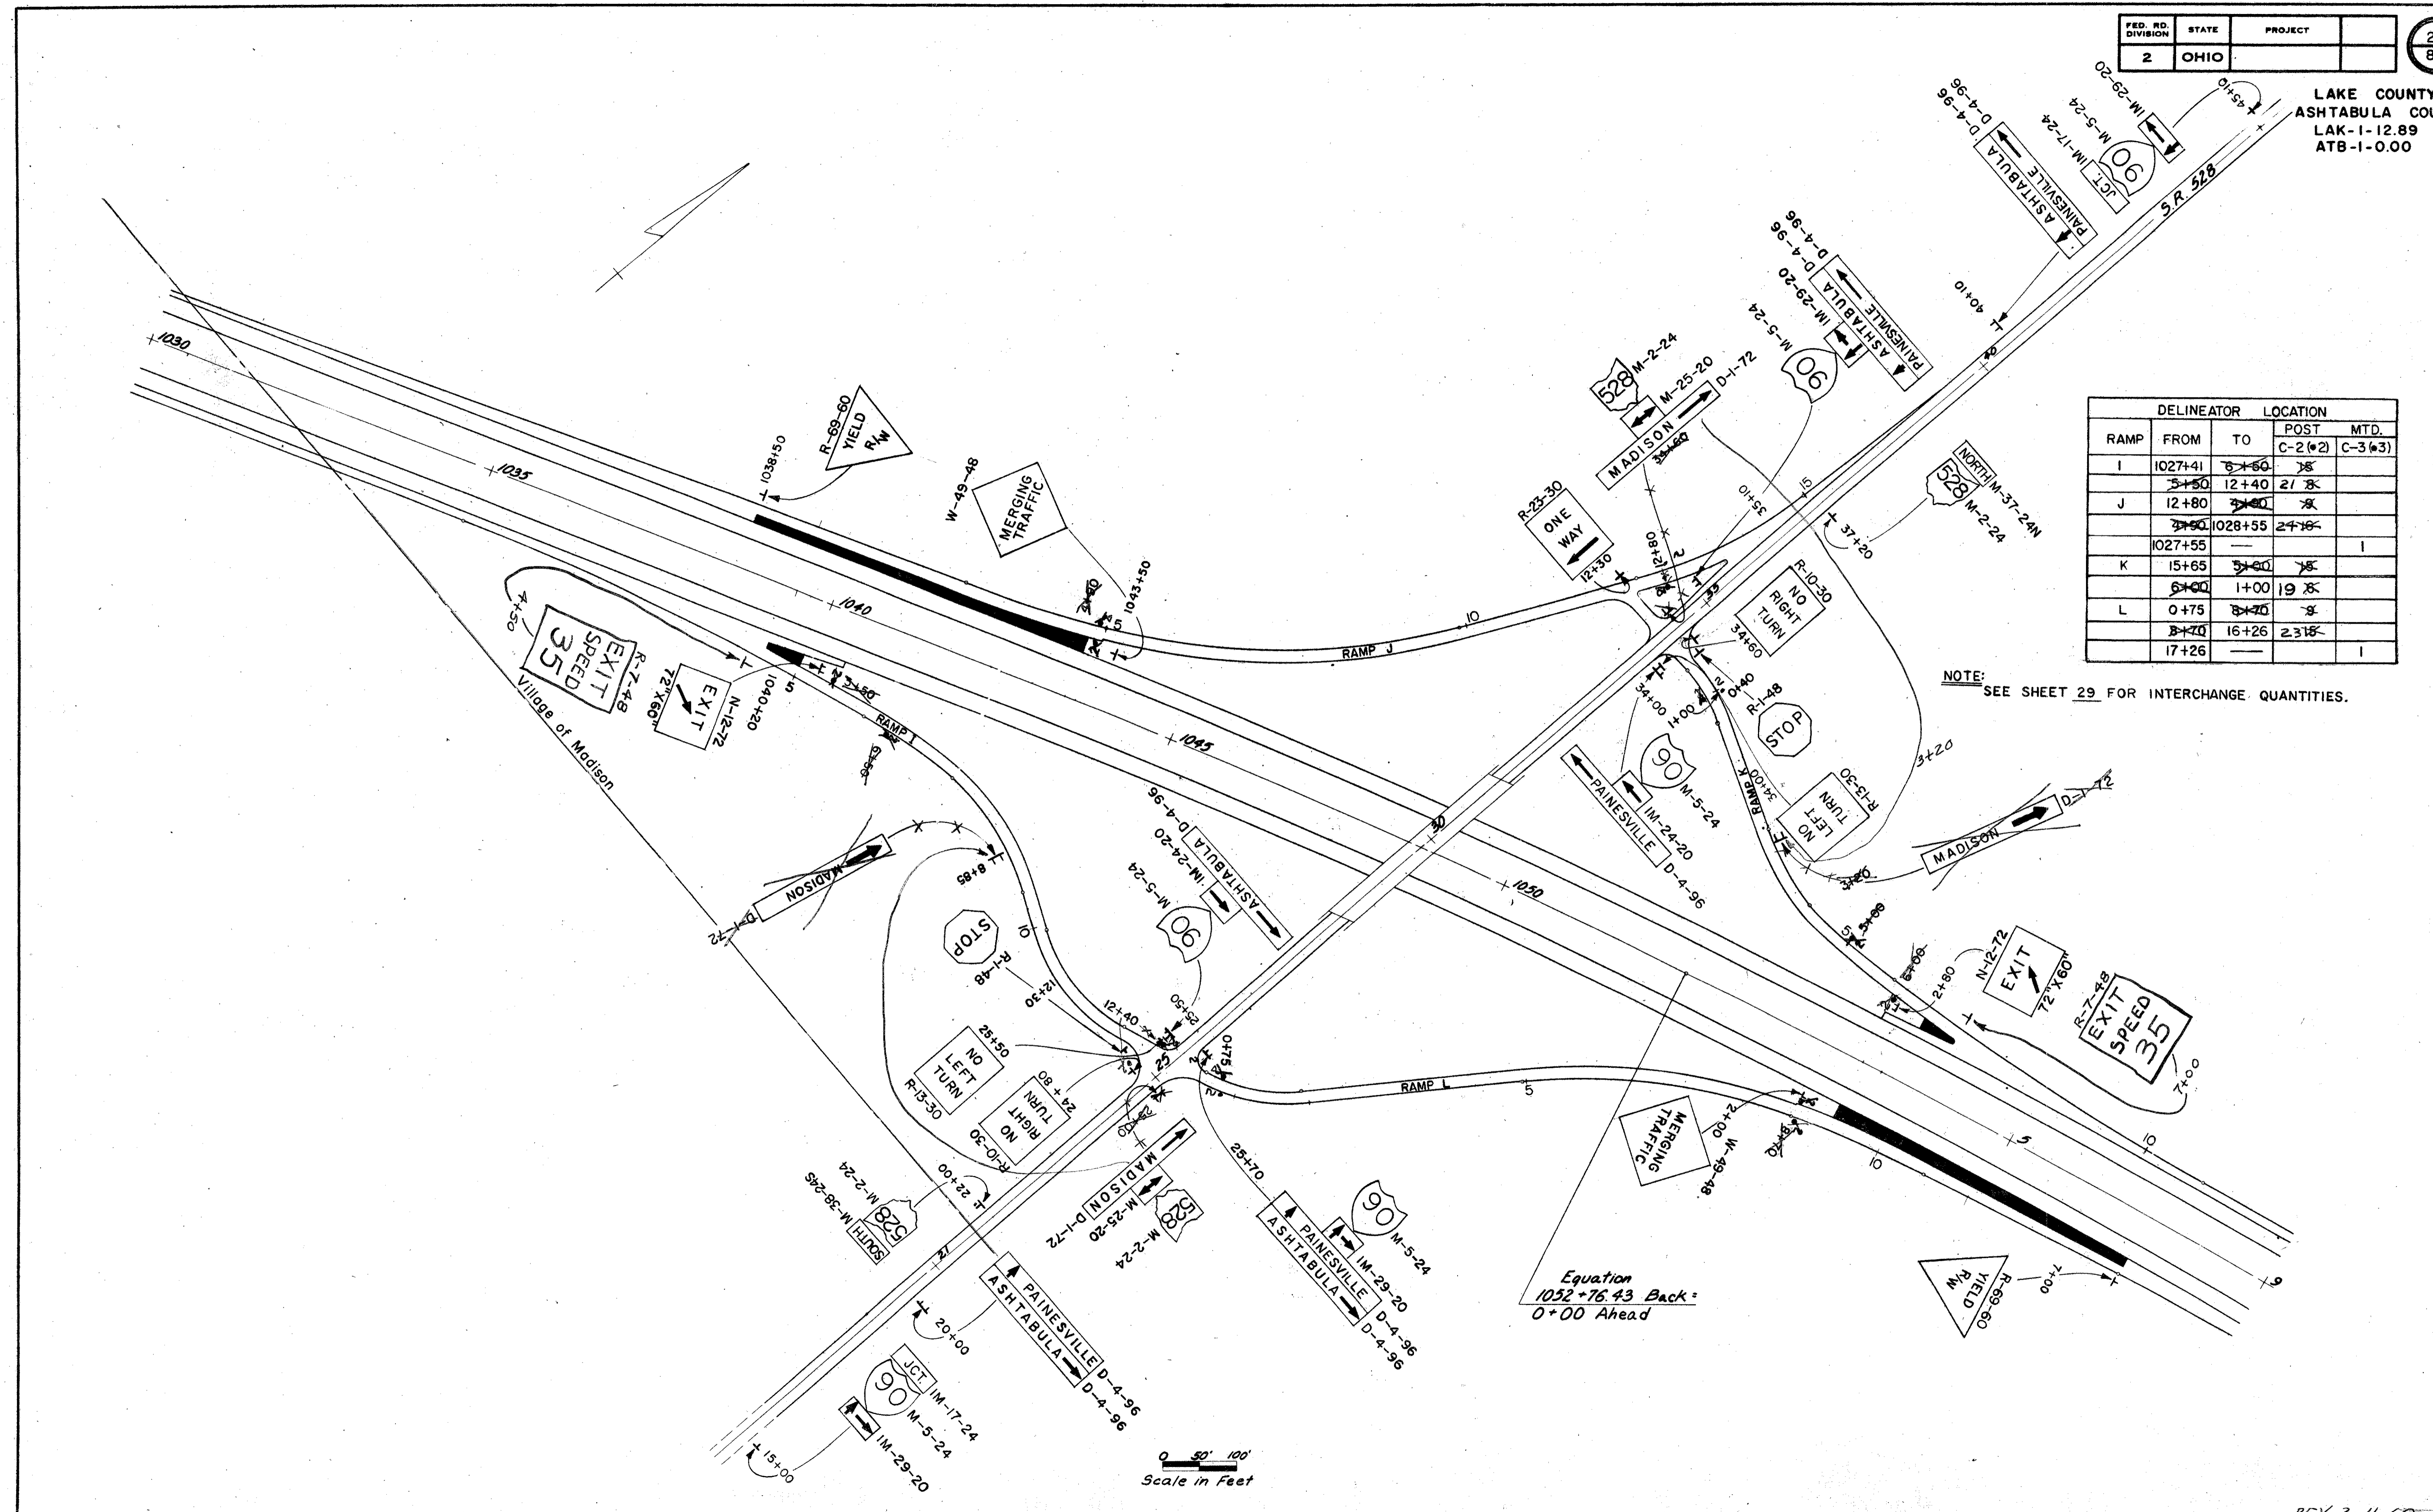

Equation
 $0 + 00 \text{ Ahead}$

Scale in Feet